


LAT. E - DIST. C - S.S. No. 20

1912

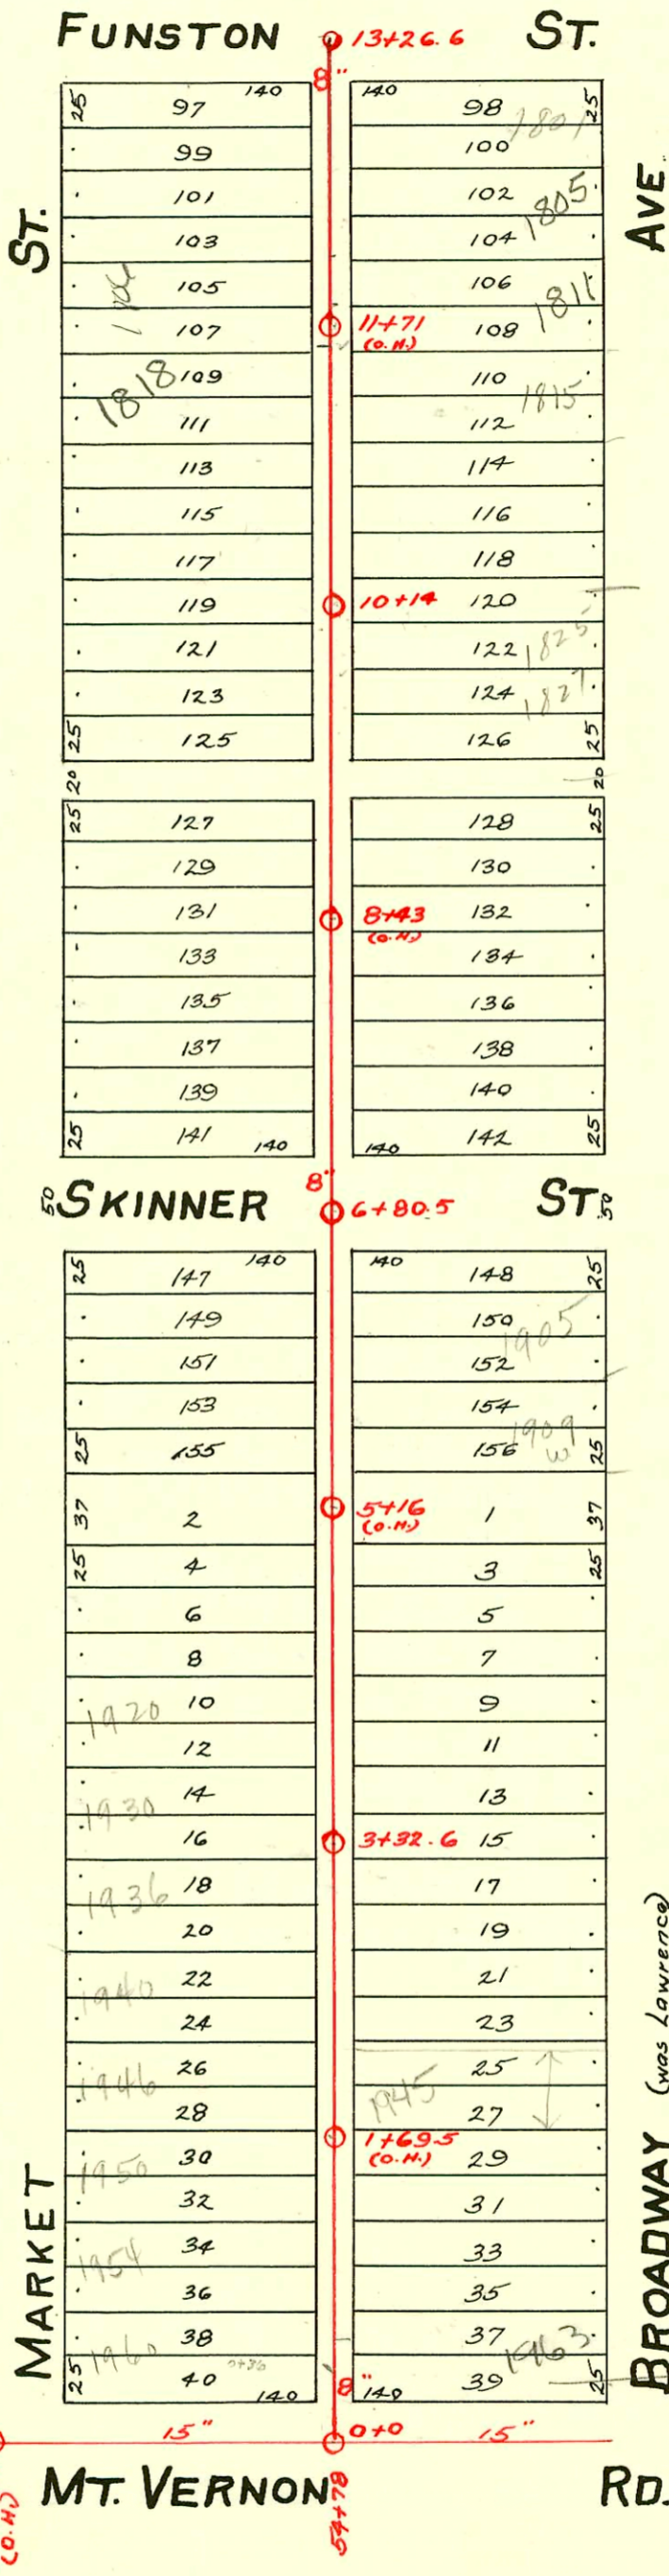

Commercial Bldg
 Prop 25x30 Bldg
 per contr. Plan
 Review Reqd.
 Contr advised he
 didn't need
 plan review
 Taylor said he
 does. Must
 show loc of
 sewer for
 exist Bldg
 known
 as 1263

CONSTRUCTION RECORD						SERVICE RECORD						
STATION	ELEVATION		Depth	MANHOLE	4-INCH "Y" BRANCHES		No. of Permit		House Number		DATE OF PERMITS	
	Ground	Grade			North West	South East	North West	South East	North West	South East	North West	South East
53				53+80								
54				54+58								
54	98.46	94.42	4.04									
	97.46	94.48	2.98	54+78								
55	97.07	94.50	2.57									
56	97.17	94.58	2.59	56+63.7 (O.H.)								
0	97.52	94.71	2.81	0+00	0+36	0+33.5	#258				3-31-22	
					0+61	0+58.5		#1399				10-23-22
					0+86.5	0+84	#1446					10-30-22
1	98.22	94.83	3.39		1+14.5	1+12						
					1+40	1+37.5	#1537					11-14-22
					1+65.5	1+63		#323				4-21-21
						1+76		#713				1-21-19
					1+88.5	1+86						
2	98.40	94.95	3.45		2+13.5	2+11						
					2+38.5	2+36	#237	#1113			8-20-23	7-31-19
					2+63	2+60.5						
					2+88	2+85.5		#800				3-28-19
3	98.09	95.07	3.02	3+32.6	3+13.5	3+11	#1316		1936 S. MARKET		10-9-22	
					3+23.5		#1536				11-13-22	
					3+38.5	3+36		#766				3-6-19
					3+61.5	3+59						
					3+87	3+84.5		#733				2-5-19
4	98.31	95.19	3.12		4+12	4+09.5						
					4+37.5	4+35	#1371				10-18-22	
					4+62.5	4+60		#1155				8-16-19
					4+88.5	4+86		#7				1-7-20
5	98.49	95.31	3.18		5+14	5+11.5	#341		1914 S. Market		5-3-27	
					5+38.5	5+36		#1997		1909 S. Broadway		4-24-68
					5+64	5+61.5	#913				7-31-22	
					5+87.5	5+85	#348	#368			4-18-22	5-11-20
6	99.44	95.43	4.01		6+13	6+10.5		#1021				8-16-22
				6+80.5	6+35	6+43.5						
7	99.17	95.55	3.62		7+22	7+19.5	#35				1-9-23	
					7+46	7+43.5						
					7+71.5	7+69		#252	1847 S. Broadway		7-3-36	
					7+97	7+94.5	#311				2-27-24	
8	100.11	95.67	4.44		8+22.5	8+20	#247	#547			2-20-24	11-21-12
					8+48	8+45.5		#169	1831 S. Broadway			3-6-25
					8+73.5	8+71	#1593				10-29-23	
					8+99	8+96.5	#6374	#2594	1833 S. Broadway		9-17-82	11-28-49
9	101.68	95.79	5.89		9+25	9+22.5	#1139	#6624	1827 S. Broadway		11-18-21	11-26-51
					9+50	9+47.5		#12287	1825 S. Broadway			1-21-69
					9+75.5	9+73	#1260				8-24-23	
					9+98.5							
10	103.23	95.91	7.32	10+14	10+01		#883	#59627			4-21-24	1-26-77
					10+26.5	10+24		#100	1823 S. Broadway			2-23-14
					10+54.5	10+52	#908		1824 S. Market		9-29-30	
					10+82.5	10+80	#1748	#89	1817 S. Broadway		11-27-23	8-14-70
11	103.22	96.03	7.19		11+08.5	11+06		#562				3-10-15
					11+33	11+30.5		#21264	1815 S. Broadway			11-29-12
					11+40-60							10-7-70
					11+56	11+53.5	#1198	#2002-02602	1818 R. Market		9-3-19	
					11+81	11+78.5	#641	#15327	1815 S. Broadway		9-26-02	8-29-17
12	103.54	96.15	7.39		12+06.5	12+04.6	#45	#204	1805 S. Broadway		7-30-13	
					12+33.5	12+31	#180	#4943	1907 S. Broadway		3-15-22	5-26-55
					12+59.5	12+57		#204	1801 S. Broadway			3-29-67
					12+85	12+82.5	#277	#15328	1801 S. Broadway		4-6-22	3-20-62
13	102.84	96.27	6.57	13+26.6								

#5285 - 1815 S. Broadway - 3-21-66
 #7029 - 1909 S. Broadway - Sealoff 2-26-68 - at Henning (5+62)
 #135528 - (tap) - 1822 S. Market - Dean Lee - 4-27-66 (10+19.5)
 #585 - 8-15-17
 #856 - 11-21-17
 #994 - 1961 S. Broadway - 11-5-30 - M.L. Lansdowne - Tap
 #995 - 1957 S. Broadway - 4-23-52 - Frederick Pibq. - Tap
 #5661 - Tap - 1901 S. Broadway - 7-19-55 - Home Pibq.
 #5662 - Tap - 1905 S. Broadway - 7-19-55 - Home Pibq.
 #16380 - Tap - 1823 S. Broadway - Van Lippoldt - 11-19-62 (10+46)
 16816 - Trench - 1823 S. Broadway - Kim Kelly - used old connection - 3-21-62
 B3456 - Sealoff - 1963 S. Broadway - Smith Albq. 5-20-65 (54+03)
 Tap #B4687 - 196 S. Broadway - Keith Hillard - 12-1-65 (0+27)
 Tap #B4688 - 1963 S. Broadway - Keith Hillard - 12-1-65 (0+25.9)