


LAT. F - DIST. C - S.S. No. 20
1912

HARRY ST.		AVE.	
2	311	3	26+12.8
4		5	
6		7	
8		9	
10		11	24+57 (O.H.)
12		13	
14		1	
2		3	
4		5	
6		7	
8		9	
10		11	23+00.5
12		13	
14		15	
16		17	
18		1	
1		3	21+55 (O.H.)
2		5	
3		7	
4		9	
5		11	
6		13	
7		15	
8			
OSIE ST.		TOPEKA	
2		2	
3		4	
5		6	
8		8	
9		10	
11		12	18+23 (O.H.)
13		14	
15		16	
2		1	
4		3	
6		5	
8		7	
10		11	16+57.39
12		13	
14		15	
16		17	
18		19	
20		21	
22		23	14+92 (O.H.)
24		25	
26		27	
28		29	
30		31	
32		33	
34			
FUNSTON ST.		BROADWAY (was Lawrence)	
2		2	
3		4	
5		6	
8		8	
9		10	
11		12	
13		13	
15		15	
2		17	
4		19	
6		21	
8		23	
10		25	
12		27	
14		29	
16		31	
18		33	
20			
22			
24			
26			
28			
30			
32			
34			

1656
1646
1657
1659

BROADWAY (was Lawrence)

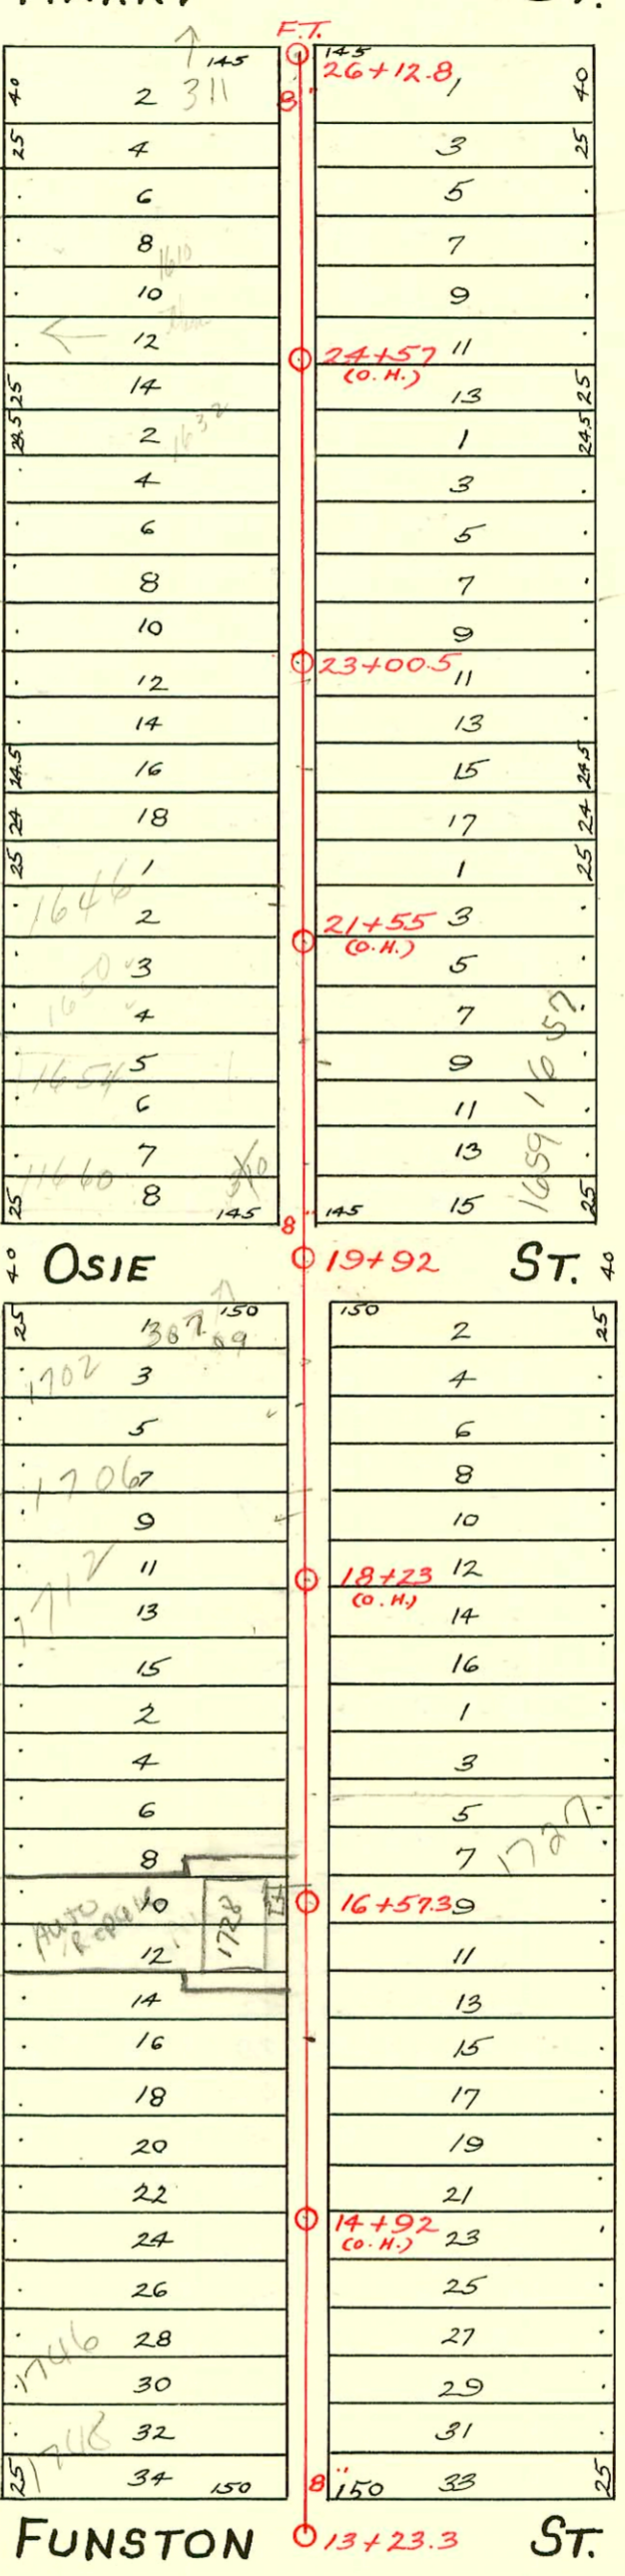

CONSTRUCTION RECORD

SERVICE RECORD

STATION	ELEVATION		Depth	MANHOLE	4-INCH "Y" BRANCHES		No. of Permit		House Number		DATE OF PERMITS	
	Ground	Grade			North West	South East	North West	South East	North West	South East	North West	South East
13	102.02	95.71	6.31	13+23.3	13+70.5	13+68	#128	#128	308 East Finston		7-24-91	12-30-19
14	101.98	95.83	6.15		13+88	13+85.5	#695	#1244	1735 S. Topeka			12-9-22
					14+98	14+05.5	#723	#3162	1746 S. Broadway		7-24-91	11-13-25
					14+32.15	14+30	#408				7-26-50	
					14+60	14+57.5					10-23-22	
					14+85	14+82.5						
15	101.81	95.95	5.86		15+10	15+07.5	#83	#16972	1738 S. Broadway	1745 S. Topeka	9-16-86	2-8-22
					15+36	15+33.5	#1784	#790			10-27-44	9-24-47
					15+61	15+58.5	06-011600	#409	1734 S. Broadway	1735 S. Topeka	6-22-06	8-20-52
					15+85.5	15+83					5-14-21	
16	101.82	96.07	5.75		16+10	16+07.5						
					16+38.5	16+36	2004	#287	1728 Broadway		5-6-04	
				16+57.3	16+63	16+60.5	#287	1227	1732 S. Broadway		2-15-79	12-9-21
					16+88.5	16+86	#250				4-1-20	
17	102.16	96.19	5.97		17+13	17+10.5	#1675					12-7-22
					17+38.5	17+36	#802				3-31-19	
					17+63	17+60.5	#3180	#1175	1716 S. Broadway	1717 S. Topeka	7-24-79	11-6-28
					17+88.5	17+86					12-10-15	
18	102.20	96.31	5.89		18+13.5	18+11	#143	#969	1715 S. Topeka		3-23-17	9-7-28
					18+38.5	18+36	Need		1706 S. Broadway			9-10-28
					18+63.5	18+61		#975	1707 S. Topeka			
					18+88.5	18+86	Seal	#17147	1702 S. Broadway		12-2-69	
19	102.90	96.43	6.47		19+14	19+11.5	#1628	#1246	307-09 E. Osie	1701 S. Topeka	12-1-48	11-16-25
					19+39	19+36.5						
				19+59.5	19+57							
20	103.50	96.55	6.95		20+21.5	20+19	#1086		1660 S. Broadway		5-18-78	9-30-48
					20+46.5	20+44	#2006	#424	1659 S. Broadway		9-25-64	10-10-16
					20+72	20+69.5	#865				11-24-17	
					20+97.5	20+95	#2229	226	1657 S. Broadway	1657 S. Topeka	5-18-70	10-11-94
21	103.79	96.67	7.12		21+22.5	21+20	#1589		1642 S. Broadway		12-6-49	3-30-21
					21+50.5	21+48	#59				3-13-47	
					21+75.5	21+73	#389	#353	1638 S. Broadway		5-9-20	2-17-15
					21+99	21+96.5	#69				5-18-20	9-6-16
22	104.25	96.79	7.46		22+23.5	22+21	#477				3-8-50	
					22+49	22+46.5	#642				7-10-17	
					22+74.5	22+72	#37				1-29-13	
					22+95	22+92.5	#206				4-11-14	
23	104.14	96.91	7.23	23+00.5	23+19.5	23+17	#385	#695			5-17-20	8-8-21
					23+44.5	24+42	#3				1-4-13	
					23+69.5	23+67	#862				4-22-19	
					23+94.5	23+92						
24	104.65	97.03	7.62		24+19.5	24+17	#551				7-31-17	
					24+45	24+42.5						
					24+70.5	24+68						
					24+95.5	24+93	#935	#793	1611 S. Topeka		8-2-22	9-18-26
25	104.33	97.15	7.18		25+20.5	25+18	#2123	#915	1602 S. Broadway		9-29-21	10-20-49
					25+46	25+43.5	#915	888			2-11-20	
					25+71	25+68.5	#925				1-21-65	
					25+93	25+90.5	#925		311 E. Larry		10-3-21	
26	104.85	97.37	7.48		26+06.5	26+04	#355	#986	1600 S. Broadway	1601 S. Topeka	5-20-80	8-11-22

26 + 12.8 F.T.

2-18-98 310 E Osie - Dead line hit by a gas company. Sewer Maint called to verify line could be s/o. Pipe Co. did s/o and sewer Maint inspected

#C 17240 - 1702 S. Broadway - Gerald Thompson - 12-9-69 (19+14)

C 9957 - 1712 S. Broadway - Roger Pllg 8-6-68 - top (18+06.6)

#1731 - Top - 1731 S. Topeka - 9-11-46 - Roy Yackley

#6178 - Top - 1640 S. Broadway - 8-14-53 - Rex Robertson Pllg.

#6383 - Top 1712 S. Broadway - Lester D. Spencer - 11-12-63 (18+59.5)

#B 1118 - Seal off - 1648 S. Broadway 4-20-64 - Baker Pllg

63296 top - 1632 S. Broadway - Rex Robertson Pllg. 4-20-65 (top 23+36.2)

26894 - 1-22-91 - 1727 S Topeka - Rep. Rick Haney

94-10313-7 - 61304 - 1659 S Topeka - 4" Clay tile line starts off 12 ft south of NPL + 31 ft from RPL (no alley cut)

SWR 2006-00296 - 1724 S Broadway 31" N of MH - 1/31/00

#05724 - 7/24/91 - 1750 S. Broadway - Henning

#05725 - 7/21/91 - 1748 S. Broadway - Henning - 5/0 4' clay 4' off main