
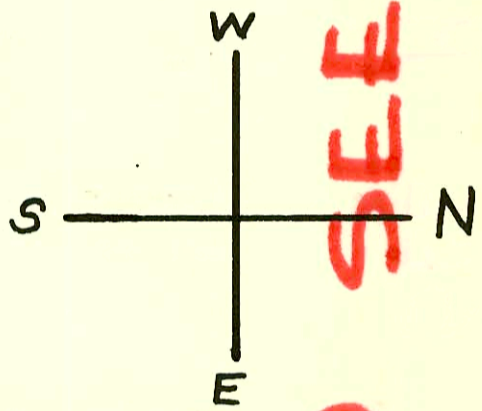


S.S. No. 9-1909  
Dist. Y - S.S. No. 20 - 1920

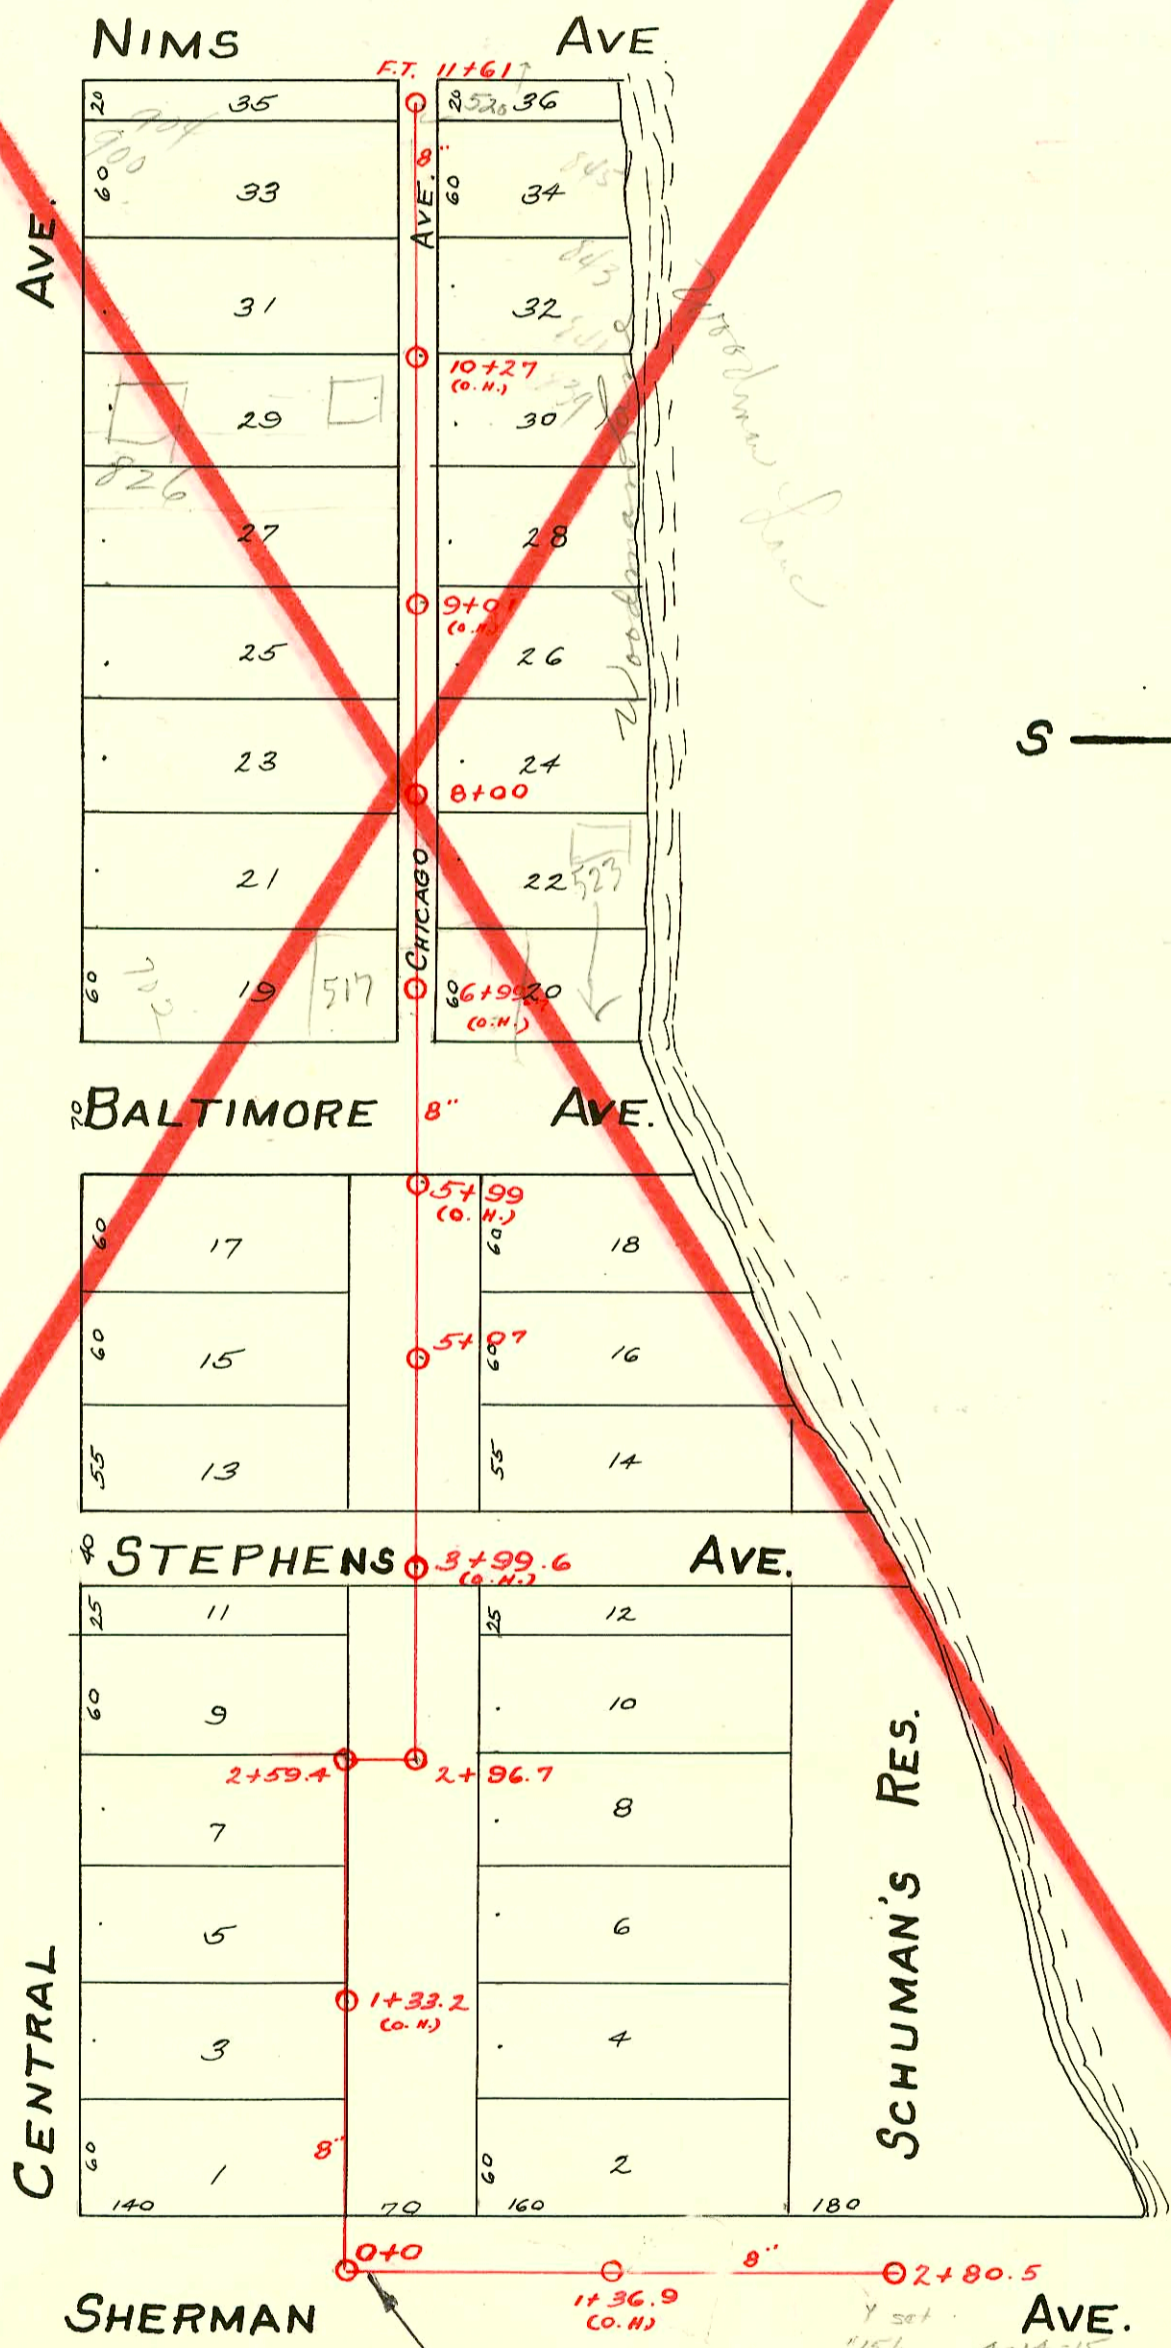

**ABANDONED SEE M-104 to M-108**

Sealed off  
5-9-66

CONSTRUCTION RECORD

SERVICE RECORD

| STATION | ELEVATION |        | Depth | MANHOLE          | 4-INCH "Y" BRANCHES |            | No. of Permit |                | House Number    |                | DATE OF PERMITS |                   |
|---------|-----------|--------|-------|------------------|---------------------|------------|---------------|----------------|-----------------|----------------|-----------------|-------------------|
|         | Ground    | Grade  |       |                  | North West          | South East | North West    | South East     | North West      | South East     | North West      | South East        |
|         |           |        |       | 11+61 F.T.       | 11+53.5             | 11+56      | #1052         | 954 W. Central | Swimming Pool   | See Book M-104 | 7-17-23         |                   |
|         |           |        |       |                  | 11+25.5             | 11+28      | #1836         |                | 520 Nims        |                | 9-15-39         |                   |
|         |           |        |       |                  |                     | 11+21      | #530          |                |                 |                | 6-26-20         |                   |
| 11      | 112.79    | 110.44 | 2.35  |                  | 11+00.5             | 11+03      | #1326         |                |                 |                | 6-6-24          | 6-3-14            |
|         |           |        |       |                  |                     | 10+99      | #376          |                |                 |                |                 | 5-14-20           |
|         |           |        |       |                  | 10+75               | 10+77.5    |               |                |                 |                |                 |                   |
|         |           |        |       |                  | 10+47.5             | 10+50      |               |                |                 |                |                 |                   |
| 10      | 112.39    | 110.34 | 2.05  |                  | 10+19.5             | 10+22      | #1583         | 520 Nims       | 830 W. Central  |                | 5-20-39         | 7-6-67<br>3-8-10  |
|         |           |        |       |                  | 9+97                | 9+91.5     |               |                |                 |                |                 |                   |
|         |           |        |       |                  | 9+69                | 9+71.5     |               |                |                 |                |                 |                   |
|         |           |        |       |                  | 9+44                | 9+46.5     |               |                |                 |                |                 |                   |
| 9       | 112.29    | 110.24 | 2.05  |                  | 9+18.5              | 9+21       | #138          |                |                 |                |                 | 2-2-67<br>12-4-12 |
|         |           |        |       |                  | 8+93.5              | 8+96       | #49           |                |                 |                |                 | 4-13-12           |
|         |           |        |       |                  | 8+68                | 8+70.5     |               |                |                 |                |                 | 2-9-11            |
|         |           |        |       |                  | 8+43                | 8+45.5     | #200          |                |                 |                | 3-24-11         | 8-4-21            |
| 8       | 111.79    | 110.14 | 1.65  | 8+00             | 8+18                | 8+20.5     | #3822         |                |                 |                | 7-6-67          | 1-27-15           |
|         |           |        |       |                  | 7+92.5              | 7+95       | #915          |                | 523 Baltimore   |                | 11-4-27         |                   |
|         |           |        |       |                  | 7+67.5              | 7+70       |               |                |                 |                |                 | 4-20-16           |
|         |           |        |       |                  | 7+42.5              | 7+45       |               |                |                 |                |                 | 7-6-67<br>8-4-15  |
| 7       | 112.00    | 110.04 | 1.96  |                  | 7+17.5              | 7+20       | #377          |                | 517 Baltimore   |                |                 |                   |
| 6       | 113.60    | 109.94 | 2.86  |                  | 6+87                | 6+89.5     |               |                |                 |                |                 |                   |
|         |           |        |       |                  | 5+89                | 5+91.5     | #534          |                |                 |                | 6-28-20         |                   |
|         |           |        |       |                  | 5+66.5              | 5+69       |               |                |                 |                |                 |                   |
|         |           |        |       |                  | 5+41                | 5+43.5     | #422          | #22            |                 |                | 5-18-21         | 1-17-11           |
| 5       | 113.80    | 109.84 | 3.96  | 5+07             | 5+16                | 5+18.5     |               |                |                 |                |                 |                   |
|         |           |        |       |                  | 4+91.5              | 4+94       | #843          | #732           |                 |                | 12-28-16        | 10-5-17           |
|         |           |        |       |                  | 4+65.5              | 4+68       | #822          | #205           |                 |                | 11-2-66         | 4-29-15           |
|         |           |        |       |                  |                     | 4+47       |               | #874           |                 |                | 12-3-20         |                   |
| 4       | 113.28    | 109.74 | 3.54  |                  | 4+40                | 4+42.5     |               |                |                 |                |                 |                   |
|         |           |        |       |                  | 3+72.5              | 3+75       |               |                |                 |                |                 |                   |
|         |           |        |       |                  | 3+41                | 3+43.5     |               |                |                 |                |                 |                   |
| 3       | 113.28    | 109.64 | 3.64  |                  | 3+13.5              | 3+16       | #275          | #278           |                 |                | 6-10-12         | 4-14-20           |
|         |           |        |       | 2+96.7<br>2+59.4 |                     |            |               |                |                 |                |                 |                   |
|         |           |        |       |                  | 2+52                | 2+54.5     | #2686         |                | 519 Sherman     |                | 11-22-54        |                   |
|         |           |        |       |                  | 2+29                | 2+31.5     |               |                |                 |                |                 |                   |
| 2       | 113.28    | 109.54 | 3.74  |                  | 2+01.5              | 2+04       |               | #1068          |                 |                |                 | 8-24-22           |
|         |           |        |       |                  | 1+76.5              | 1+79       | #3516         | #428           | 519 1/2 Sherman |                | 12-15-52        | 5-20-21           |
|         |           |        |       |                  | 1+51.5              | 1+54       |               | #388           |                 |                |                 | 4-26-11           |
|         |           |        |       |                  | 1+26                | 1+28.5     |               |                |                 |                |                 |                   |
| 1       | 113.18    | 109.44 | 3.74  |                  | 1+03.5              |            |               |                |                 |                |                 |                   |
|         |           |        |       |                  |                     | 0+93.5     |               | #393           |                 |                |                 | 6-25-09           |
|         |           |        |       |                  |                     | 0+68       |               | #43            |                 |                |                 | 2-18-09           |
|         |           |        |       |                  |                     | 0+42.5     |               | #651           |                 |                |                 | 10-20-09          |
| 0       | 112.98    | 109.34 | 3.64  | 0+0              |                     |            |               |                |                 |                |                 |                   |
|         |           |        |       |                  | 2+80.5              |            |               |                |                 |                |                 |                   |
| 2       | 113.04    | 109.68 | 3.36  |                  | 2+02                |            | #1251         |                |                 |                | 9-30-19         |                   |
|         |           |        |       |                  | 1+83                |            |               |                |                 |                |                 |                   |
|         |           |        |       |                  | 1+75.5              |            |               |                |                 |                |                 |                   |
|         |           |        |       |                  | 1+42.2              |            |               |                |                 |                |                 |                   |
| 1       | 112.44    | 109.48 | 2.96  |                  | 1+14.5              |            | #286          |                |                 |                | 5-18-10         |                   |
| 0       |           |        |       | 0+00             | 0+07                |            | #390          |                |                 |                | 5-18-20         |                   |

ABANDONED SEE M-104 to M-108

C4-23-831-37 Woodman Seal off - Al Henning 9-6-67  
 P-251-817 Woodman Seal off - Al Henning 12-2-66  
 C-968-704-7 Central Seal off - Al Henning 11/25/66  
 B-639-739-845 Woodman Seal off - Al Henning 9-27-66  
 #57-3-1-18  
 #156-4-14-15  
 #540-7-28-11 Seal 5821-Henning-7/6/67  
 #187-Top-511 Baltimore-4-13-31-L. W. Murphy  
 #103-Top-612 W. Central-10-10-34-Jensen Plbg. Co.  
 #620-606 W. Central-5-27-43-Kansas Plbg. Co.  
 #1398-Top-825 Chicago-6-27-50-Simmons Plbg. Co.