


DIST. A - S.S. No. 8 - 1918



*S.S. No. 8, constructed in 1918 has been killed in this area. For replacement lines see Bk. E, page 147 & Bk. I, page 87. For original lines, S.S. No. 8, See old Bk. 2, page 142.*

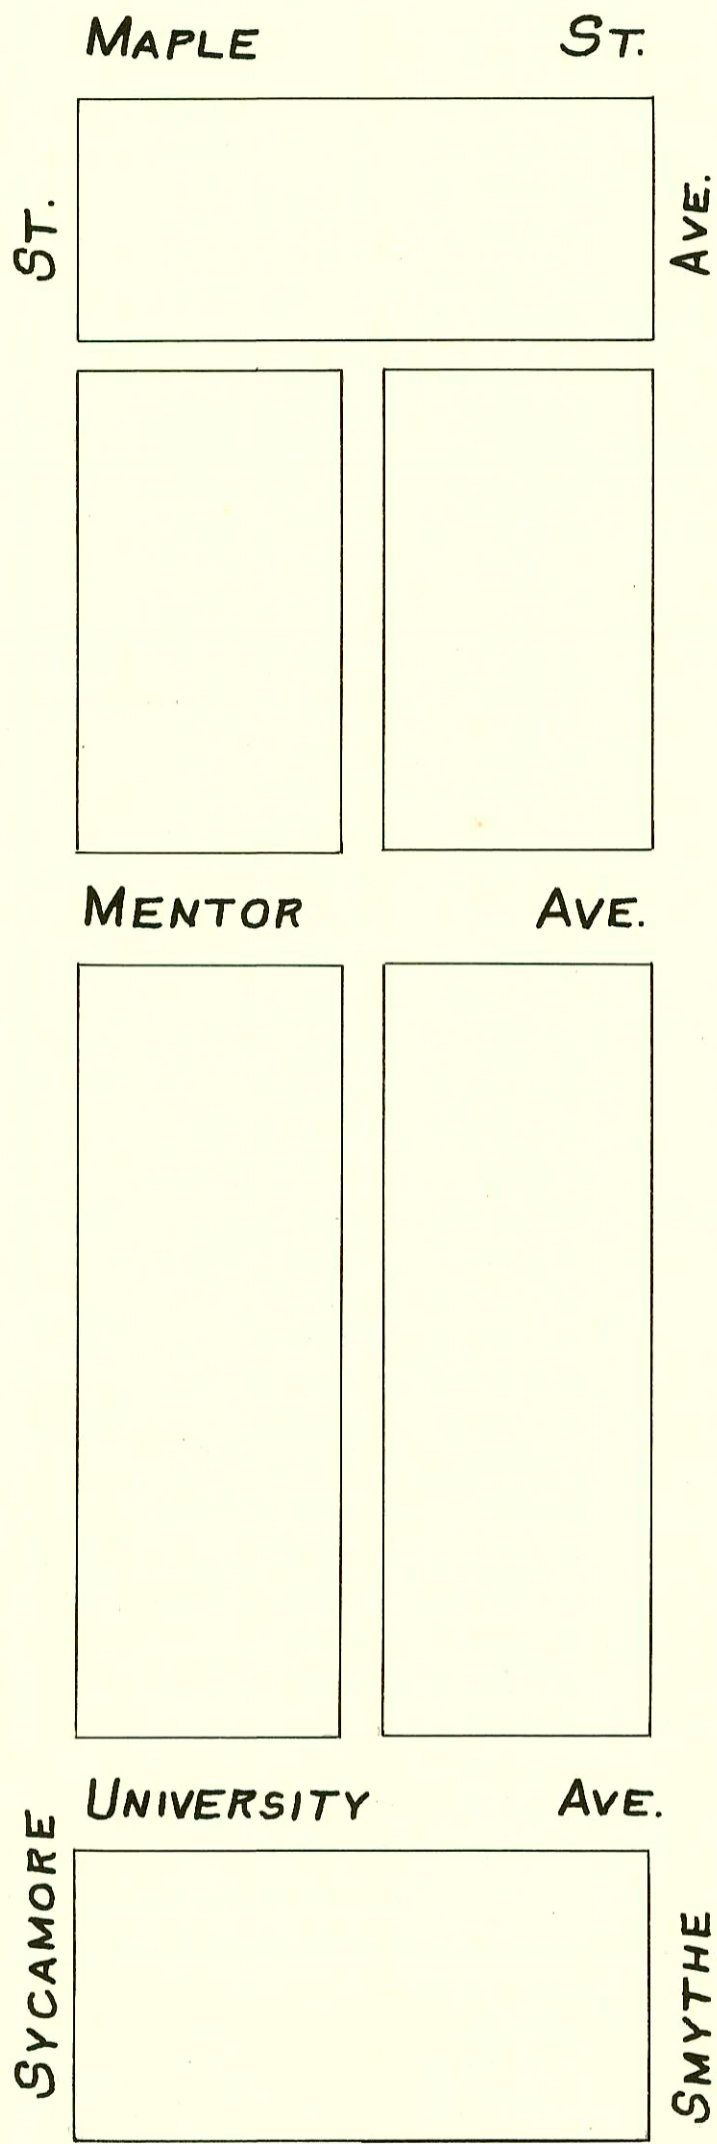