



LAT. 3 - SUB-MAIN A - S.S. No. 21

1922

3+47.84 MH TYP 'P'
20' CONC ENCASUREMENT E.
3+73.4 Connected
to EXIST. Line
CONC. ENCASED

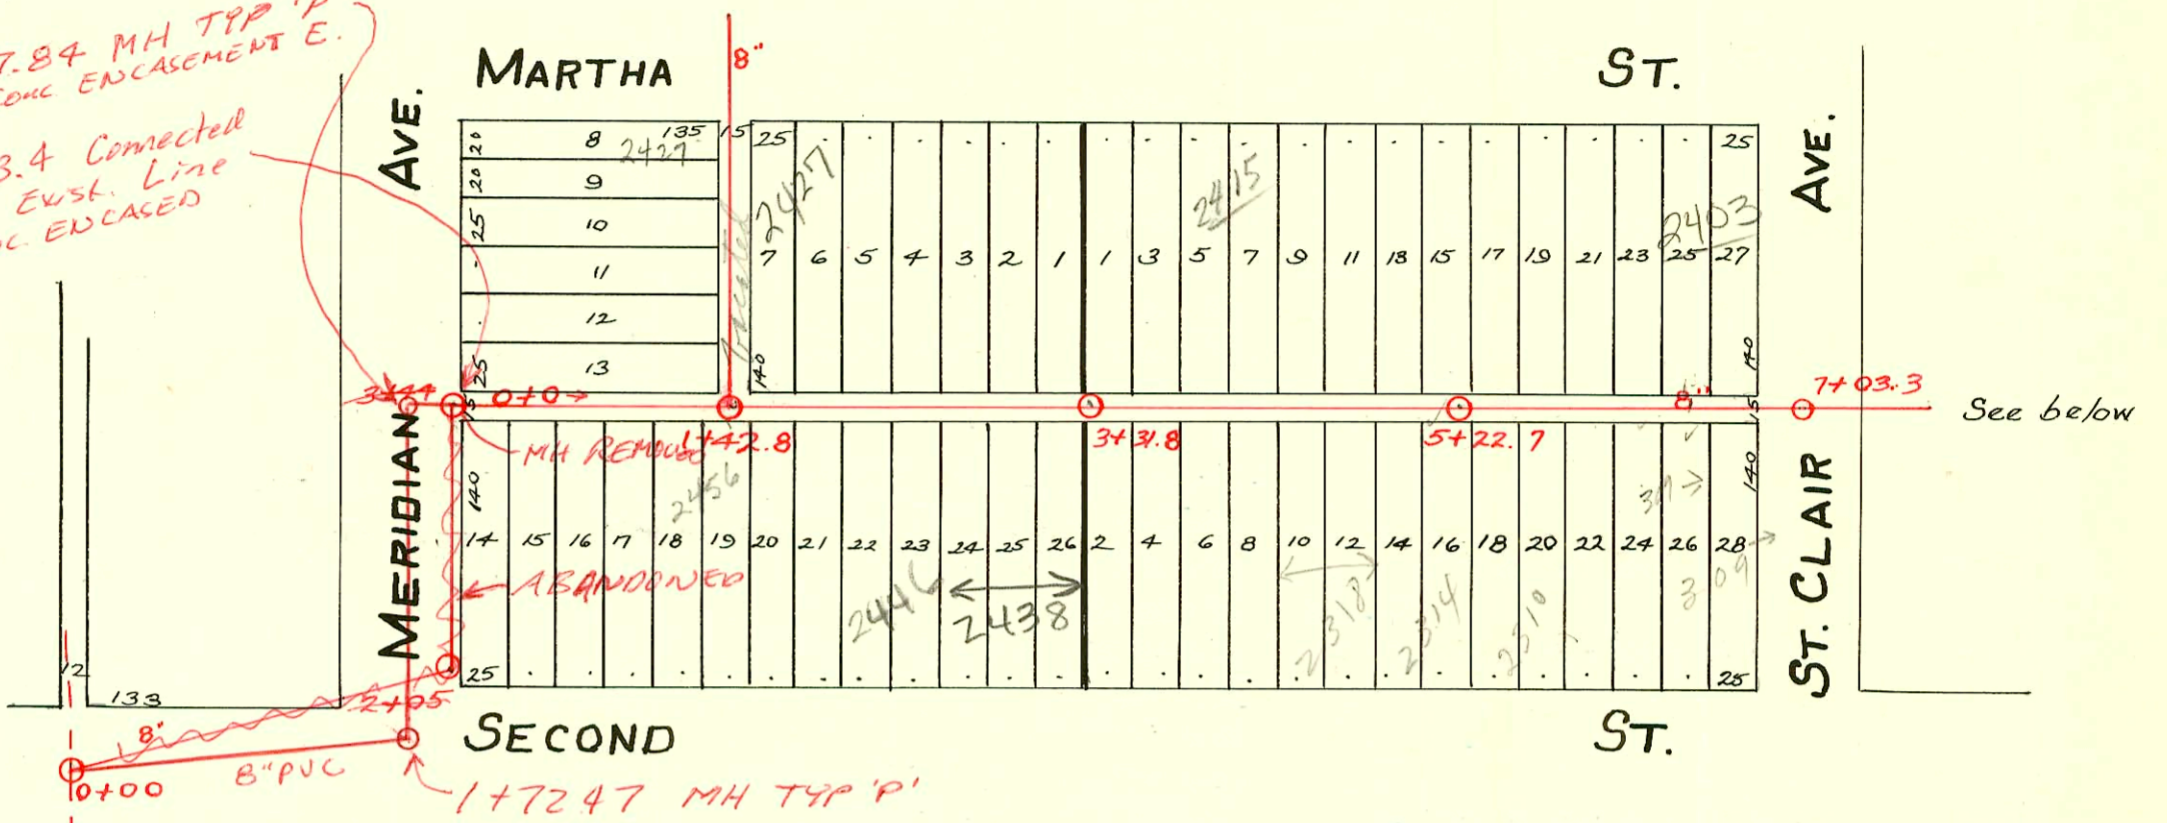

S.S. Reconst. in conn. with Water Main
Replacement in Meridian from
Burton to Newell (89059)
Proj. No. 468-82803
Built by Wildcat Const.
Booked from AS Built Plan 3-17-99

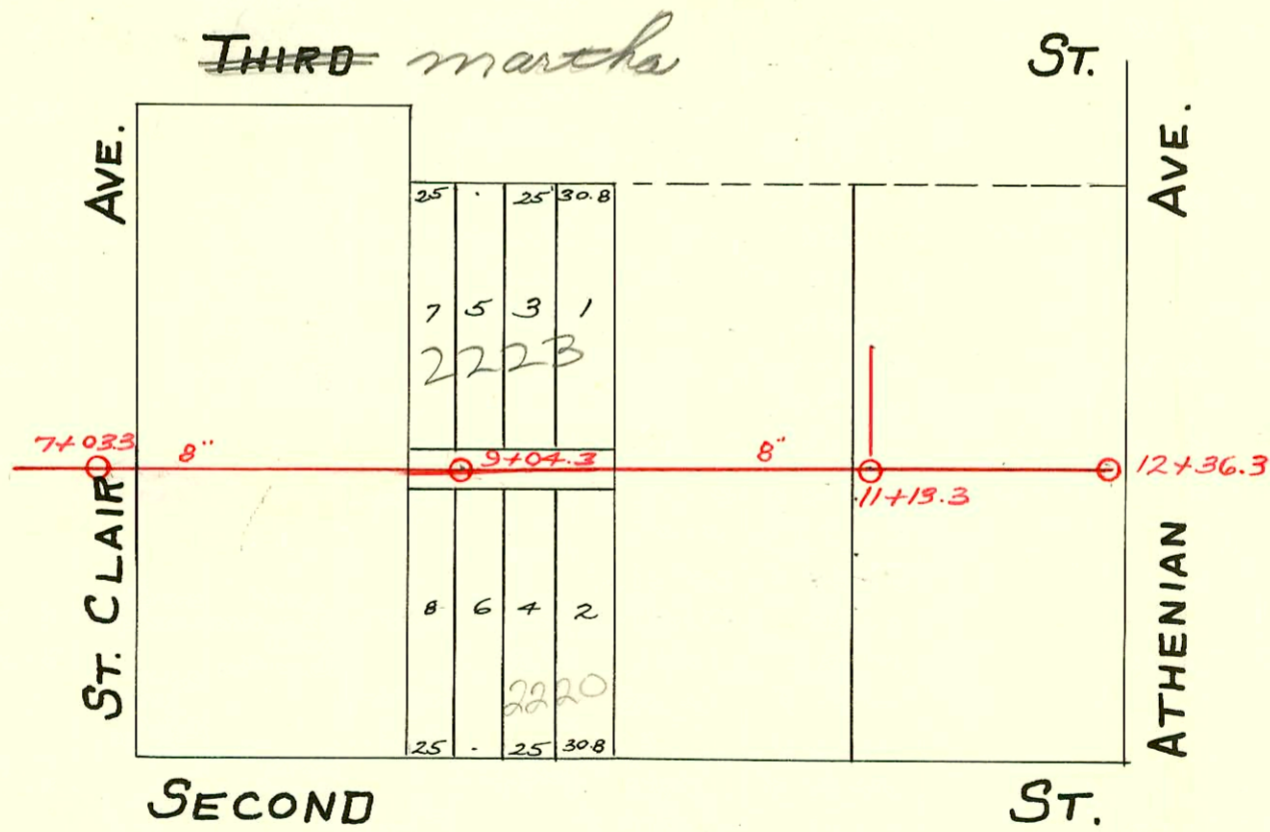

2001-03257- 12/24/01- 2438 W 2nd- Wichita EXC- 4" SCH40 - CITY REPAIR, 4" Predco, 1V22, 1TWINCO, 1FERNO,

