


S.S. No. 18 - 1910
Dist. Y - S.S. No. 20 - 1920

1302
Camm in D 123

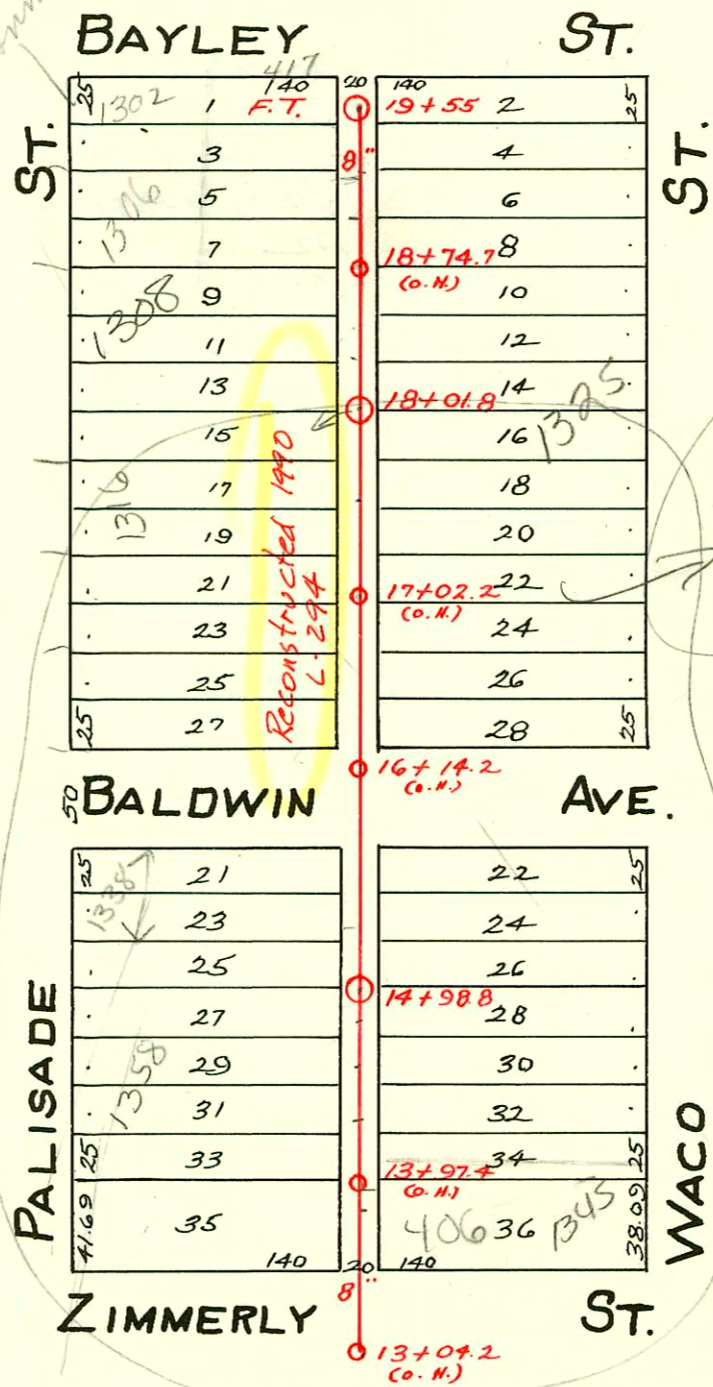

CONSTRUCTION RECORD						SERVICE RECORD						
STATION	ELEVATION		Depth	MANHOLE	4-INCH "Y" BRANCHES		No. of Permit		House Number		DATE OF PERMITS	
	Ground	Grade			North West	South East	North West	South East	North West	South East	North West	South East
	107.86	103.10	4.76	19+55 FT.								
19	107.96	103.00	4.96		19+46	19+43.5	#1377	#418	417 W Bayley	1308 S Waco	8-25-24	9-18-23
					19+21	19+18.5	#807	#498			8-18-30	4-9-23
					18+95.5	18+93	#791	#503			4-11-24	9-1-10
					18+73	18+70.5		#716				1-25-19
					18+47	18+44.5		#340				3-7-23
18	107.96	102.80	4.16	18+01.8	18+22	18+19.5	#2427		1310 Palisade		5-11-48	
					17+97	17+94.5	#575	#403	1312 Palisade		3-26-24	5-1-11
					17+48.5	17+46						
					17+26	17+23.5						
17	107.76	102.60	5.16		17+00.5		#855				4-17-24	
						16+98						
					16+76	16+73.5						
					16+50.5	16+48	#11935	#310	#346	1360 Palisade	9-5-24	2-27-24
					16+25.5	16+23						7-14-15
16	106.96	102.40	4.56		15+51.5	15+39		#207				2-15-24
					15+29.5	15+27	#994				5-2-24	
15	107.46	102.20	5.26		15+08.5	15+06						
				14+98.8								
					14+84.5	14+82	#340				3-3-24	
					14+59	14+56.5						
					14+34	14+30.5	#278		1358 Palisade		12-5-24	2-25-24
14	107.26	102.00	5.26		14+01.5							
						13+99						
					13+84	13+81.5	#1362	#558			9-17-23	7-9-20
					13+58	13+55.5						
13	107.46	101.80	5.66	13+04.2 (O.N.)								

2004-00422 21824 1308 S Palisade - Wichita Exc. 4" 40 PVC - Replace lower 6' at main - 6" Wye repaired - New 4" trap installed, 14" fall, shallow 136's of MH 17+55 (18+19) 1045, dirt alley cut NOTE from K. Johnson (Inspector) Drain cleaner requested a cleanout in the dirt alley. I would not allow it. Please record this on permit.

#925 - Tap - 417 W. Bayley - 11-12-46 - Burgan Pibg. Co.
 #6039 - Tap - 412 W. Zimmerly - 10-5-51 - Cherry Pibg. Co.
 #3409 - Tap - 1308 Palisade - 12-8-52 - Ray Pibg. Co. see above
 #2862 - 6 on 8 wye - 1335 S. Waco - 12-9-54 - Joe McDonald.