


S.S. No. 15 - 1910
Dist. Y - S.S. No. 20 - 1920

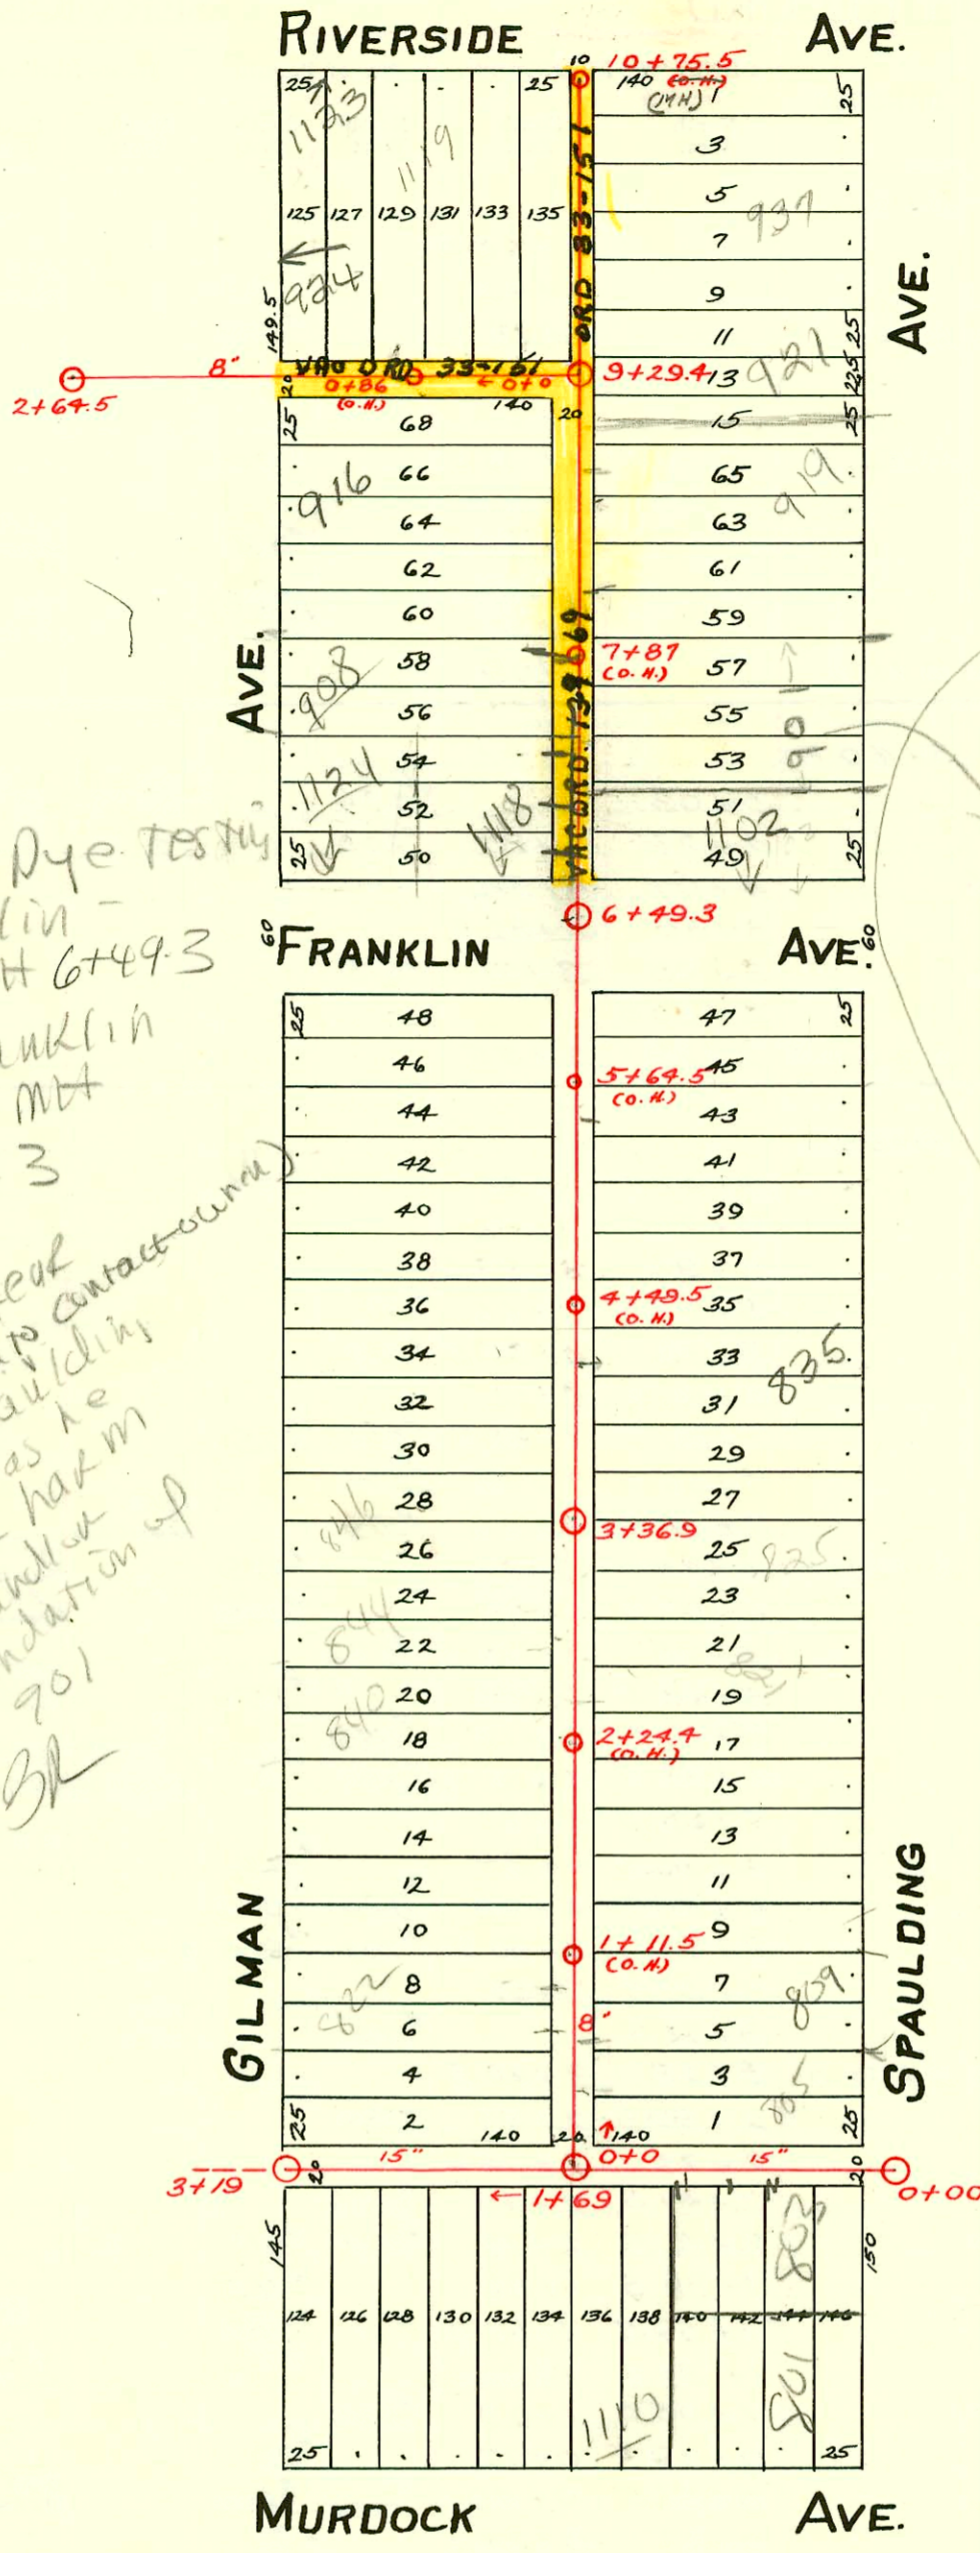

- 2004-00217-1/23/04-916 Gilman- Roto Rooter- 4" Predco by city- Wye repair 65' sof mt 9+29.4 (8+64.4) 4" PE SDR17 Pipe burst replacement- 4 Fernco, 1 Wye, 2 1/4" 45, 1 1/2" 22, 2 1/4" 45, poly pipe, shallow
- 2002-00793-3/20/02-822 N Gilman- Padgett Exc- 4" PE SDR17 - Pipe burst replacement. NO USmt - NO 1 1/2"
- 2003-00032-1/6/03-924 N Gilman- Olson Swr- 2 Dir clo, 2 Fernco, 6" 40 PVC
- 2005-03122-1-17-06-937 N Spaulding- Roto Rooter- 4" PVC, 87' south mt, tied in side house to main- (2) Fernco, (4) Dir clo - Roto Rooter

CONSTRUCTION RECORD						SERVICE RECORD						
STATION	ELEVATION		Depth	MANHOLE	4-INCH "Y" BRANCHES		No. of Permit		House Number		DATE OF PERMITS	
	Ground	Grade			North West	South East	North West	South East	North West	South East	North West	South East
3	115.07			3+19				#21 ^{TOP}				1-11-24
								#1215				9-11-19
								#242				6-13-16
2	114.91											
				1+69				#686		?		6-19-22
1	114.98							#480		?		9-27-15
								#890		801 Spaulding		7-18-29
								#630				11-21-10
0	113.17			0+0								
2	115.45	109.84	5.61	2+64.5	2+29	2+55						
					1+68.5							
1	115.20	109.74	5.46		1+18	1+43						
					0+93			#206				3-25-11
					0+68			#134				4-12-12
0	115.60	109.64	5.96	0+0	0+19	0+42		#232				5-14-15
				10+75.5								
						10+66						
						10+45		#98		947 Spaulding		2-11-26
10	115.72	109.46	6.26		10+14	10+23						
						9+97						
						9+71		#521		?		12-1-16
						9+48		#734		?		5-14-23
				9+29.4								
9	115.28	109.07	6.21		9+07.5	9+05						
					8+64.3	8+79		#76	#288	916 R Gilman	see next	1-23-04
					8+54.5	8+52						12-30-10
					8+31.5	8+29						
8	115.60	108.92	6.68		8+03.5	8+14		#441	#918	912 Gilman	?	5-24-21
					7+83	7+80.5		#917		908 Gilman		12-11-11
					7+56.5	7+54						
					7+33.5	7+31		#988		909 Gilman		10-18-21
7	116.14	108.77	6.37		7+03.5	7+11		#611	#916	808, 112, 1118 Spaulding		10-17-18
6	115.38	108.62	5.76	6+49.3	6+78.5	6+76		#126		800, 1118 Spaulding		2-23-22
					5+45.5	5+43		#612	#706			10-17-18
5	115.85	108.47	7.38		5+20.5	5+18		#408		800, 1118 Spaulding		7-9-18
					4+97	4+99.5		#178				5-9-16
					4+69.5	4+67		#272				5-11-18
					4+43.5	4+41		#403	#1054	863 Spaulding		4-26-22
4	115.65	108.32	7.23		4+19.5	4+17		#283		835 Spaulding		11-29-27
					3+97.5	3+95						6-18-12
					3+72.5	3+70		#226				12-9-21
				3+36.9	3+43.5	3+41		#554	#650	848 Gilman		12-14-31
3	116.50	108.17	8.33		3+18.5	3+16						11-28-10
					2+95	2+92.5		#153		825 Spaulding		3-15-11
					2+69.5	2+67		#436	#366	811, 810 Spaulding		9-25-12
					2+42.5	2+40		#154	51469 Gilman			8-2-12
2	116.38	108.02	8.36		2+17.5	2+15						3-15-11
					1+92.5	1+90		#627				11-21-10
					1+66.5	1+64			#643			11-25-10
					1+42.5	1+40		#464				6-3-20
1	115.49	107.87	6.62		1+18	1+15.5			#399			8-13-15
					0+92.5	0+90						
					0+69.5	0+67		#644		807 Spaulding		11-24-13
					0+43.5	0+41		#629		803 Spaulding		11-21-10
0	113.17	107.72	5.45	0+0	0+19.5	0+17		#695	#1123	805 Spaulding		12-17-10
												11-15-21

#2690 - Top - 875 - Spaulding - 2-11-46 - Fish Pibg Co.
 #1517 - Top - 1102 Franklin - 9-7-49 - Collison Pibg Co.
 #4686 - Top - 875 Spaulding - 6-12-57 - Reynolds Pibg.
 #1439 - Top - 937 Spaulding - 7-21-58 Reynolds Pibg.
 94 1860-7, 11-16-94 914 N Spaulding - 2+13 N of M.H. = 8+64.3 - 4" sizes - Also replaced wye for 920 N. Gilman = 215' N of M.H. = 8+64.3
 74 2373-7 2-17-94 901 N Spaulding - Arrowhead.
 4" Pvc 40 - City wye for 40.6' N of a M.H. (Historical Bldg)