


LATERAL 10 MAIN 3 WESTLINK SAN
 BUILT BY: MID STATES CONST. CO.
 PROJ. NO DBKL 574034
 BOOKED 5-7-76 FROM CG 18

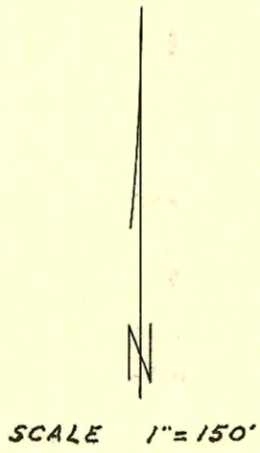

CONSTRUCTION RECORD

SERVICE RECORD

STATION	ELEVATION		Depth	MANHOLE	4-INCH "Y" BRANCHES		No. of Permit		House Number		DATE OF PERMITS	
	Ground	Grade			North West	South East	North West	South East	North West	South East	North West	South East
RIVERSIDE MOBILE HOME PARK (CONT.)												
LINE G 0+00	84.0	78.15	5.9	0+00=2+48.0 LINE F	1+34 W	0+32 E						
1+00	83.3	78.40	4.9		1+81 W	1+83 E						
2+00	84.5	78.65	5.9		2+30 W	1+79 E						
	85.2	78.76	6.4		2+79 W	2+83 E						
		79.43	5.8	2+45.3	3+29 W							
3+00	85.0	79.58	5.4		3+32 W							
					3+79 W	2+81 E						
4+00	84.7	79.83	4.9		4+29 W	4+31 E						
					4+77 W	2+81 E						
5+00	84.3	80.08	4.2		5+27 W	5+29 E						
	84.1	80.30	3.8	5+93.4	6" STUB NE	5+79 E						
					6" STUB NW	5+79 E						
					5+77 W							
LINE F 0+00	84.3	74.83	9.5	0+00=8+22.4 LINE B	0+33 N	0+25 S						
1+00	84.2	75.08	9.1									
						1+73 S						
2+00	83.9	75.33	8.6		2+17 N	2+09 S						
	84.0	75.45	8.6		4" STUB SW	2+90 S						
		75.55	8.5	2+48.0								
3+00	83.8	75.68	8.1		3+10 N	3+35 S						
					3+62 N							
4+00	83.5	75.93	7.6		4+10 N	4+40 S						
	83.4	76.05	7.4		4+48.2	4+60 N	4+87 S					
		76.15	7.3									
5+00	83.2	76.28	6.9		5+10 N	5+37 S						
					5+60 N	5+87 S						
6+00	83.0	76.54	6.5		6+10 N	6+37 S						
					6+60 N	6+87 S						
7+00	82.6	76.79	5.8									
	82.6	76.82	5.8		7+08.4							
		76.90	5.7									
8+00	81.6	77.13	4.5									
						8+68 W						
9+00	83.2	77.38	5.8		9+13 W	9+63 E						
	84.0	77.46	6.2		9+32.9	9+97 W						
		77.56	6.4									
10+00	83.9	77.73	6.2		10+13 W							
					10+63 W							
11+00	83.6	77.98	5.6		11+13 W							
					11+63 W							
12+00	83.4	78.23	5.2		12+13 W							
	83.3	78.31	5.0		12+33.3	4" STUB N						
		78.41	4.9			12+53 N	12+60 S					
13+00	83.1	78.58	4.5		13+01 N	13+18 N						
					13+50 N	13+60 S						
14+00	82.6	78.83	3.8		13+99 N							
	82.6	78.85	3.8	14+10.2	4" STUB NE	4" STUB S						
LATERAL 10 MAIN 3 WESTLINK SAN SEWER												
0+00	168.7	156.06	12.6									
1+00	167.8	156.86	10.9		1+22.4		06		1008 Callahan		5-23-77	
	168.7	157.56	11.1									
		157.66	11.0	1+87.3								
2+00	167.7	157.76	9.9		1+98.1		064783		1624 Callahan		1-6-78	
3+00	167.9	158.56	9.3		3+12.1		065670		1636 Callahan		4-3-78	
4+00	168.0	159.36	8.6		3+91.0		066504		1648 Callahan		5-24-78	
	169.4	159.72	9.7	4+45.0								
					4+98.4		065817		1668 Callahan		4-10-78	
5+00	168.1	160.16	7.9									
					5+98.8		065812		1710 Callahan		4-10-78	
6+00	168.5	160.96	7.5		6+70.4		064189		1722 Callahan		12-27-77	
	170.2	161.76	8.4	6+99.7								
	169.0	161.76	7.2									
7+00												
8+00	169.8	162.56	7.2									
					7+95.6		063492		1732 N Callahan		10-12-77	
9+00	170.1	163.36	6.7		8+83.0		062405		1742 Callahan		8-3-77	
	171.0	163.76	7.2	9+49.6	4" STUB NW		066695		1752 Callahan		6-5-78	