


SANITARY SEWER (PART A & B)
AMARADO ESTATES
BUILT BY: MID KANSAS CONST. CO.
PROJ. NO. DBKW 705026
BOOKED 6-30-76 AS BUILT PLAN

LATERAL 18 MAIN 3 WESTLINK SAN
BUILT BY: UTILITY CONTR. INC.
PROJ. N^o DBKL575057
BOOKED 11-7 -78 FROM LES15

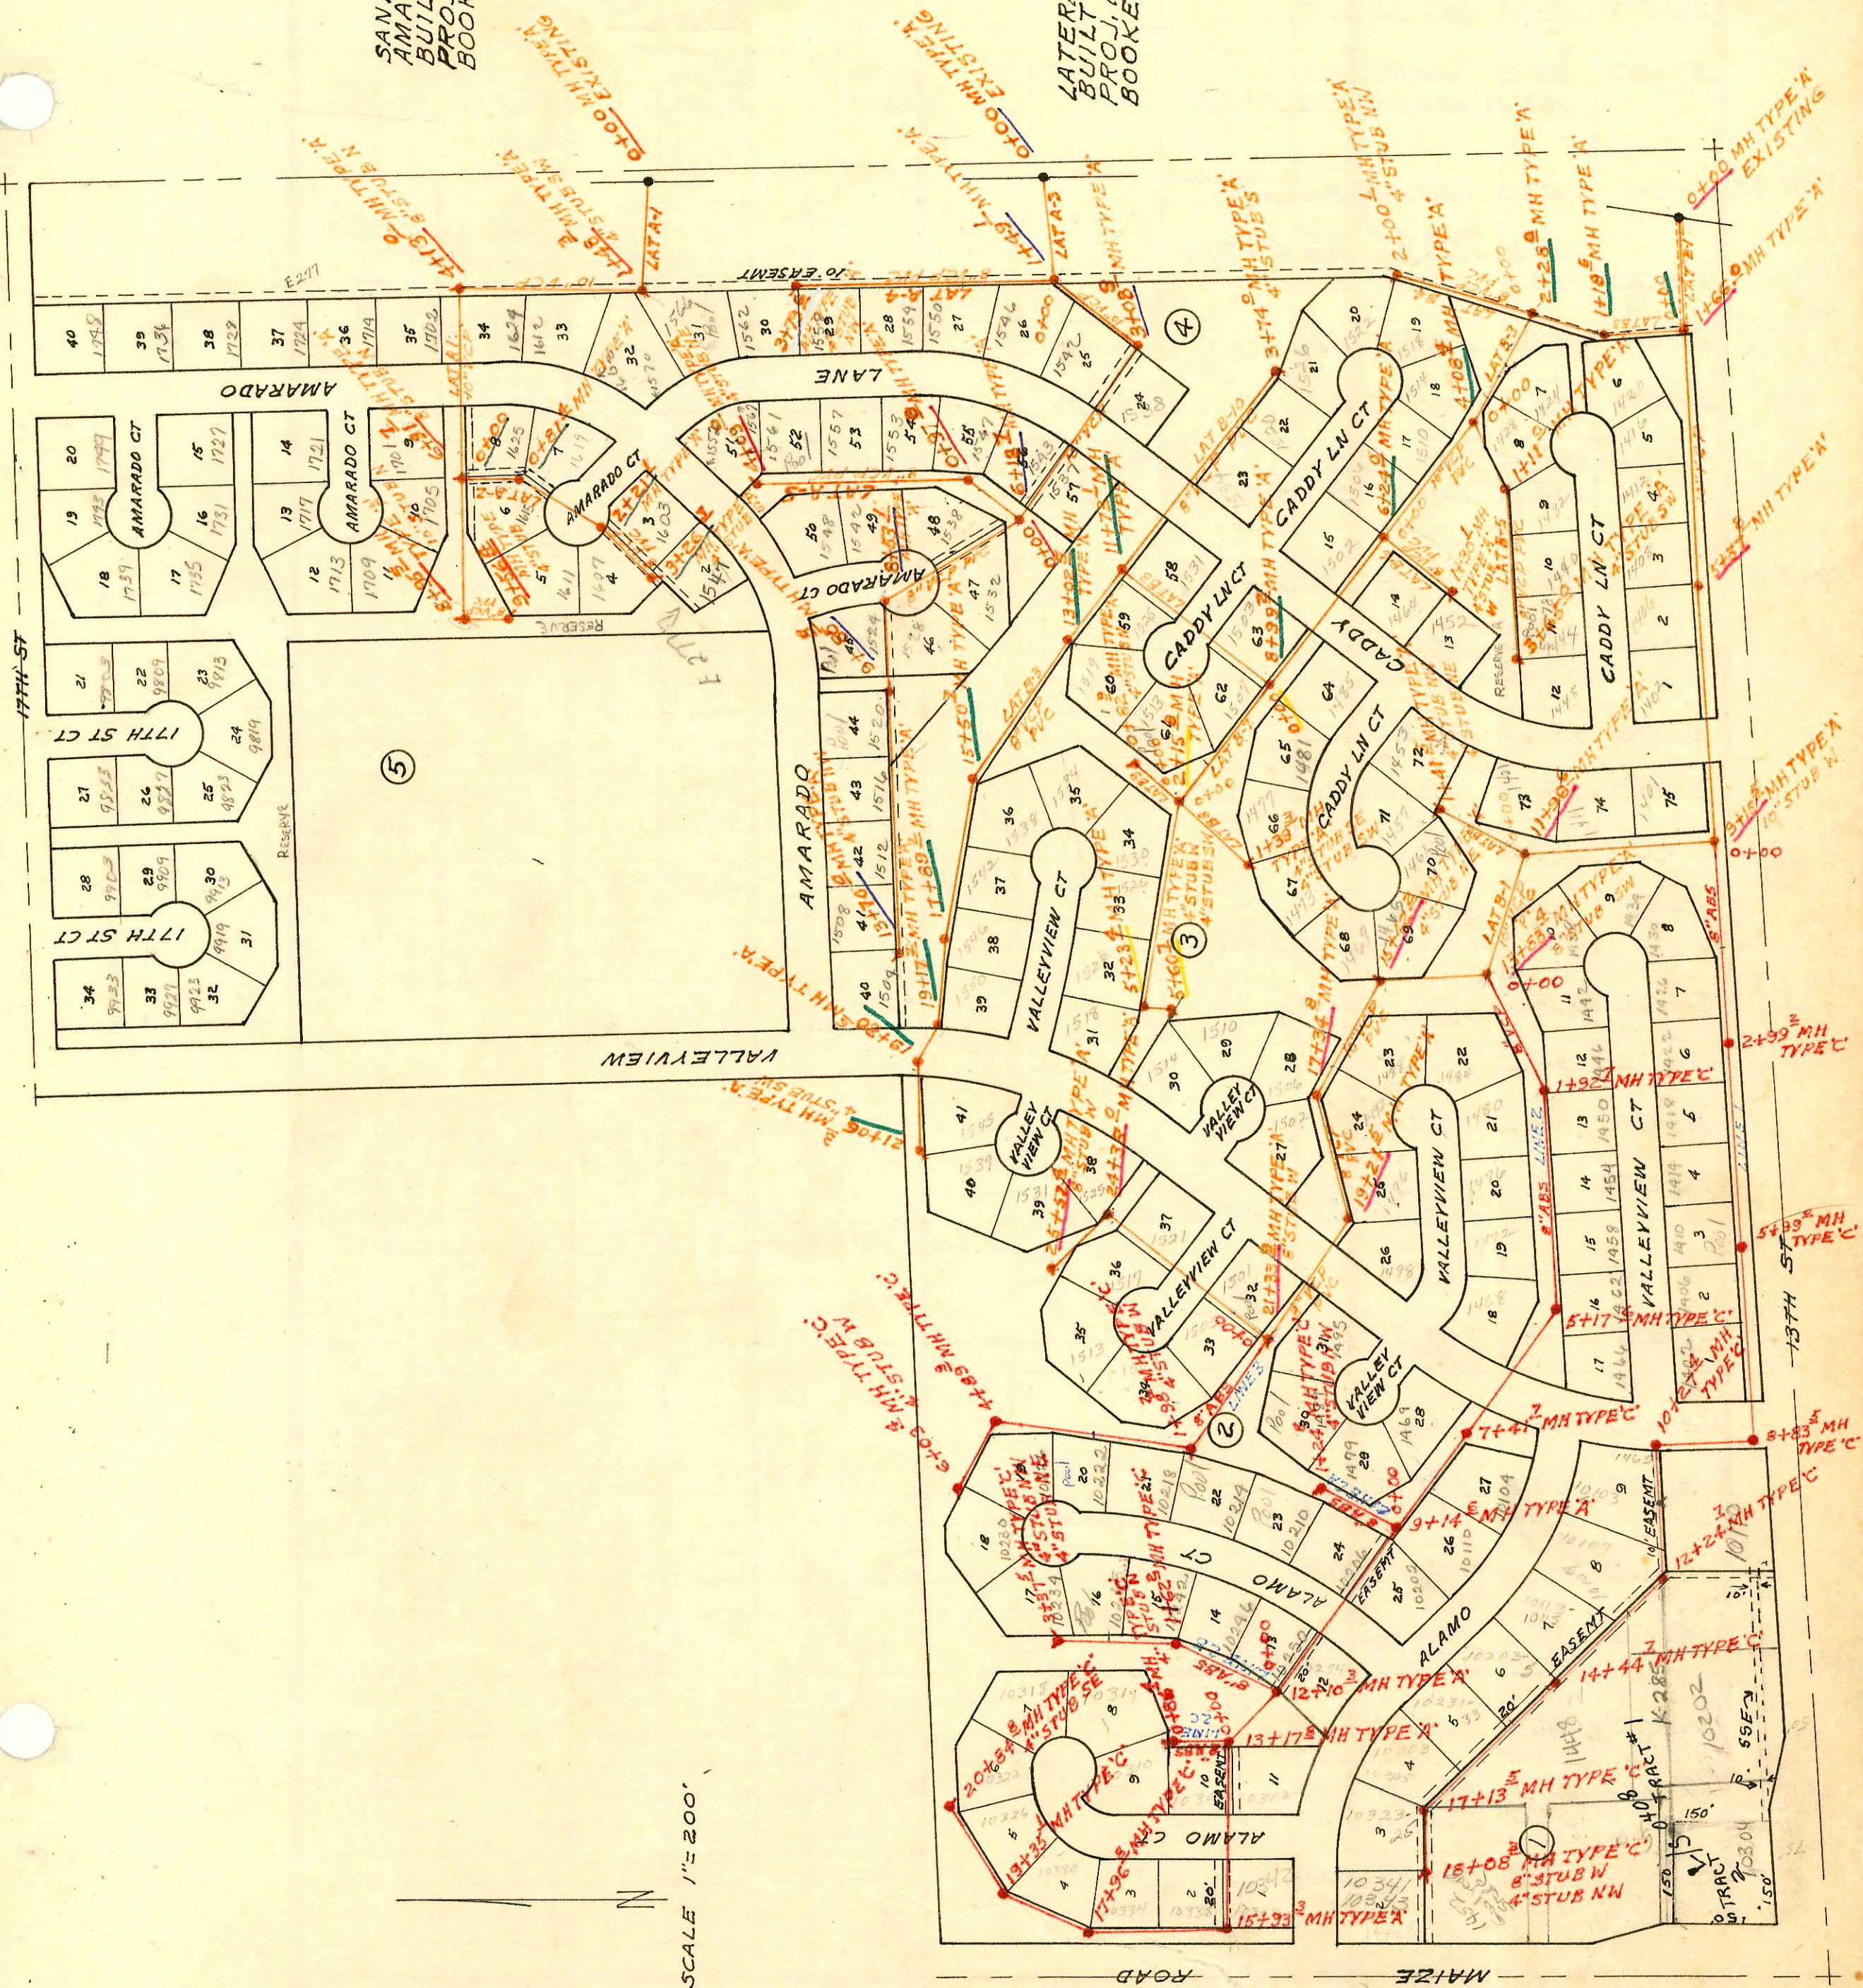


CONSTRUCTION RECORD

SERVICE RECORD

SANITARY SEWER - AMARADO ESTATES
PART A
LINE A-1

STATION	ELEVATION		Depth	MANHOLE	4-INCH "Y" BRANCHES		No. of Permit		House Number		DATE OF PERMITS	
	Ground	Grade			North West	South East	North West	South East	North West	South East	North West	South East
0+00	155.3	142.51	12.8	0+00								
1+00	146.5	142.87	3.6									
	154.98	143.15	11.8	1+48.3	4" STUB SW		065814		1566		4-12-78	
					1+52.3		067077		1602		6-26-78	
2+00	155.5	143.28	12.2		2+31.3		065856		1612		4-11-78	
3+00	155.5	143.56	12.2									
4+00	155.5	143.84	11.7		3+52.6		068028		1624		8-23-78	
	155.43	143.98	11.5	4+13.0	8" STUB N				1624			
5+00	152.8	144.24	8.6									
6+00	152.8	144.55	8.3		6+52.5		10364		1701		3-6-84	
	153.89	144.83	9.1	6+91.7	8" STUB N				1705			
7+00	153.1	144.85	8.3		7+30.3		06872		1709		11-1-82	
8+00	153.4	145.14	8.3		8+01.5		3682		1709		7-15-81	
	154.46	145.68	8.8	8+95.5	10" STUB N							
9+00	154.0	145.70	8.3									
	154.65	145.92	8.7	9+56.4	4" STUB SE		067403		1611		7-18-78	
LINE A-2	0+00	153.0	7.9	0+00=6+91.7								
		145.10	7.9	LINE A1								
		152.8	7.4	0+81.4			067479		1615		7-21-78	
1+00	153.0	145.62	7.4				067180		1625		6-30-78	
2+00	152.6	145.02	7.6				068204		1619		9-6-78	
	154.82	146.21	8.6	2+21.1								
3+00	153.3	146.51	6.8				067670		1603		8-3-78	
	155.44	146.61	8.8	3+26.3			068279		1607		9-11-78	
					4" STUB S		068106		1547 A		10-2000	
LINE A-3	0+00	155.1	12.3	0+00								
1+00	145.5	142.40	3.1									
	155.60	142.68	13.0	1+49.1								
2+00	152.0	142.82	9.2									
3+00	152.0	143.10	8.9				064321		1542		12-5-77	
	152.89	143.22	9.9	3+08.9					1538		11-8-76	
4+00	150.3	143.51	6.8									
5+00	150.5	143.82	6.7									
6+00	151.0	144.13	6.9				067075		1537		6-26-78	
	152.83	144.45	8.4	6+18.7			064429		1538		12-13-77	
7+00	151.3	144.81	6.5									
8+00	152.3	145.24	7.1				068200		1528		9-5-78	
	155.97	145.57	10.4	8+53.1			068196		1524		9-5-78	
9+00	151.0	145.70	5.3									
	154.51	145.99	8.5	9+85.8								
10+00	152.7	145.99	6.7				070252		1520		2-12-79	
11+00	153.1	146.40	6.7				14357		1516		1-31-85	
12+00	154.6	146.82	7.8				065155		1512		2-28-78	
13+00	155.0	147.24	7.8				064662		1508		12-28-77	
	155.07	147.53	7.5	13+70.0	4" STUB NW		064998		1504		2-7-78	


2000-02573- 11/27/00- 1547 N Amarado- McClungs- 4" PVC- Changed Lower End of Pipe at MH-1H22

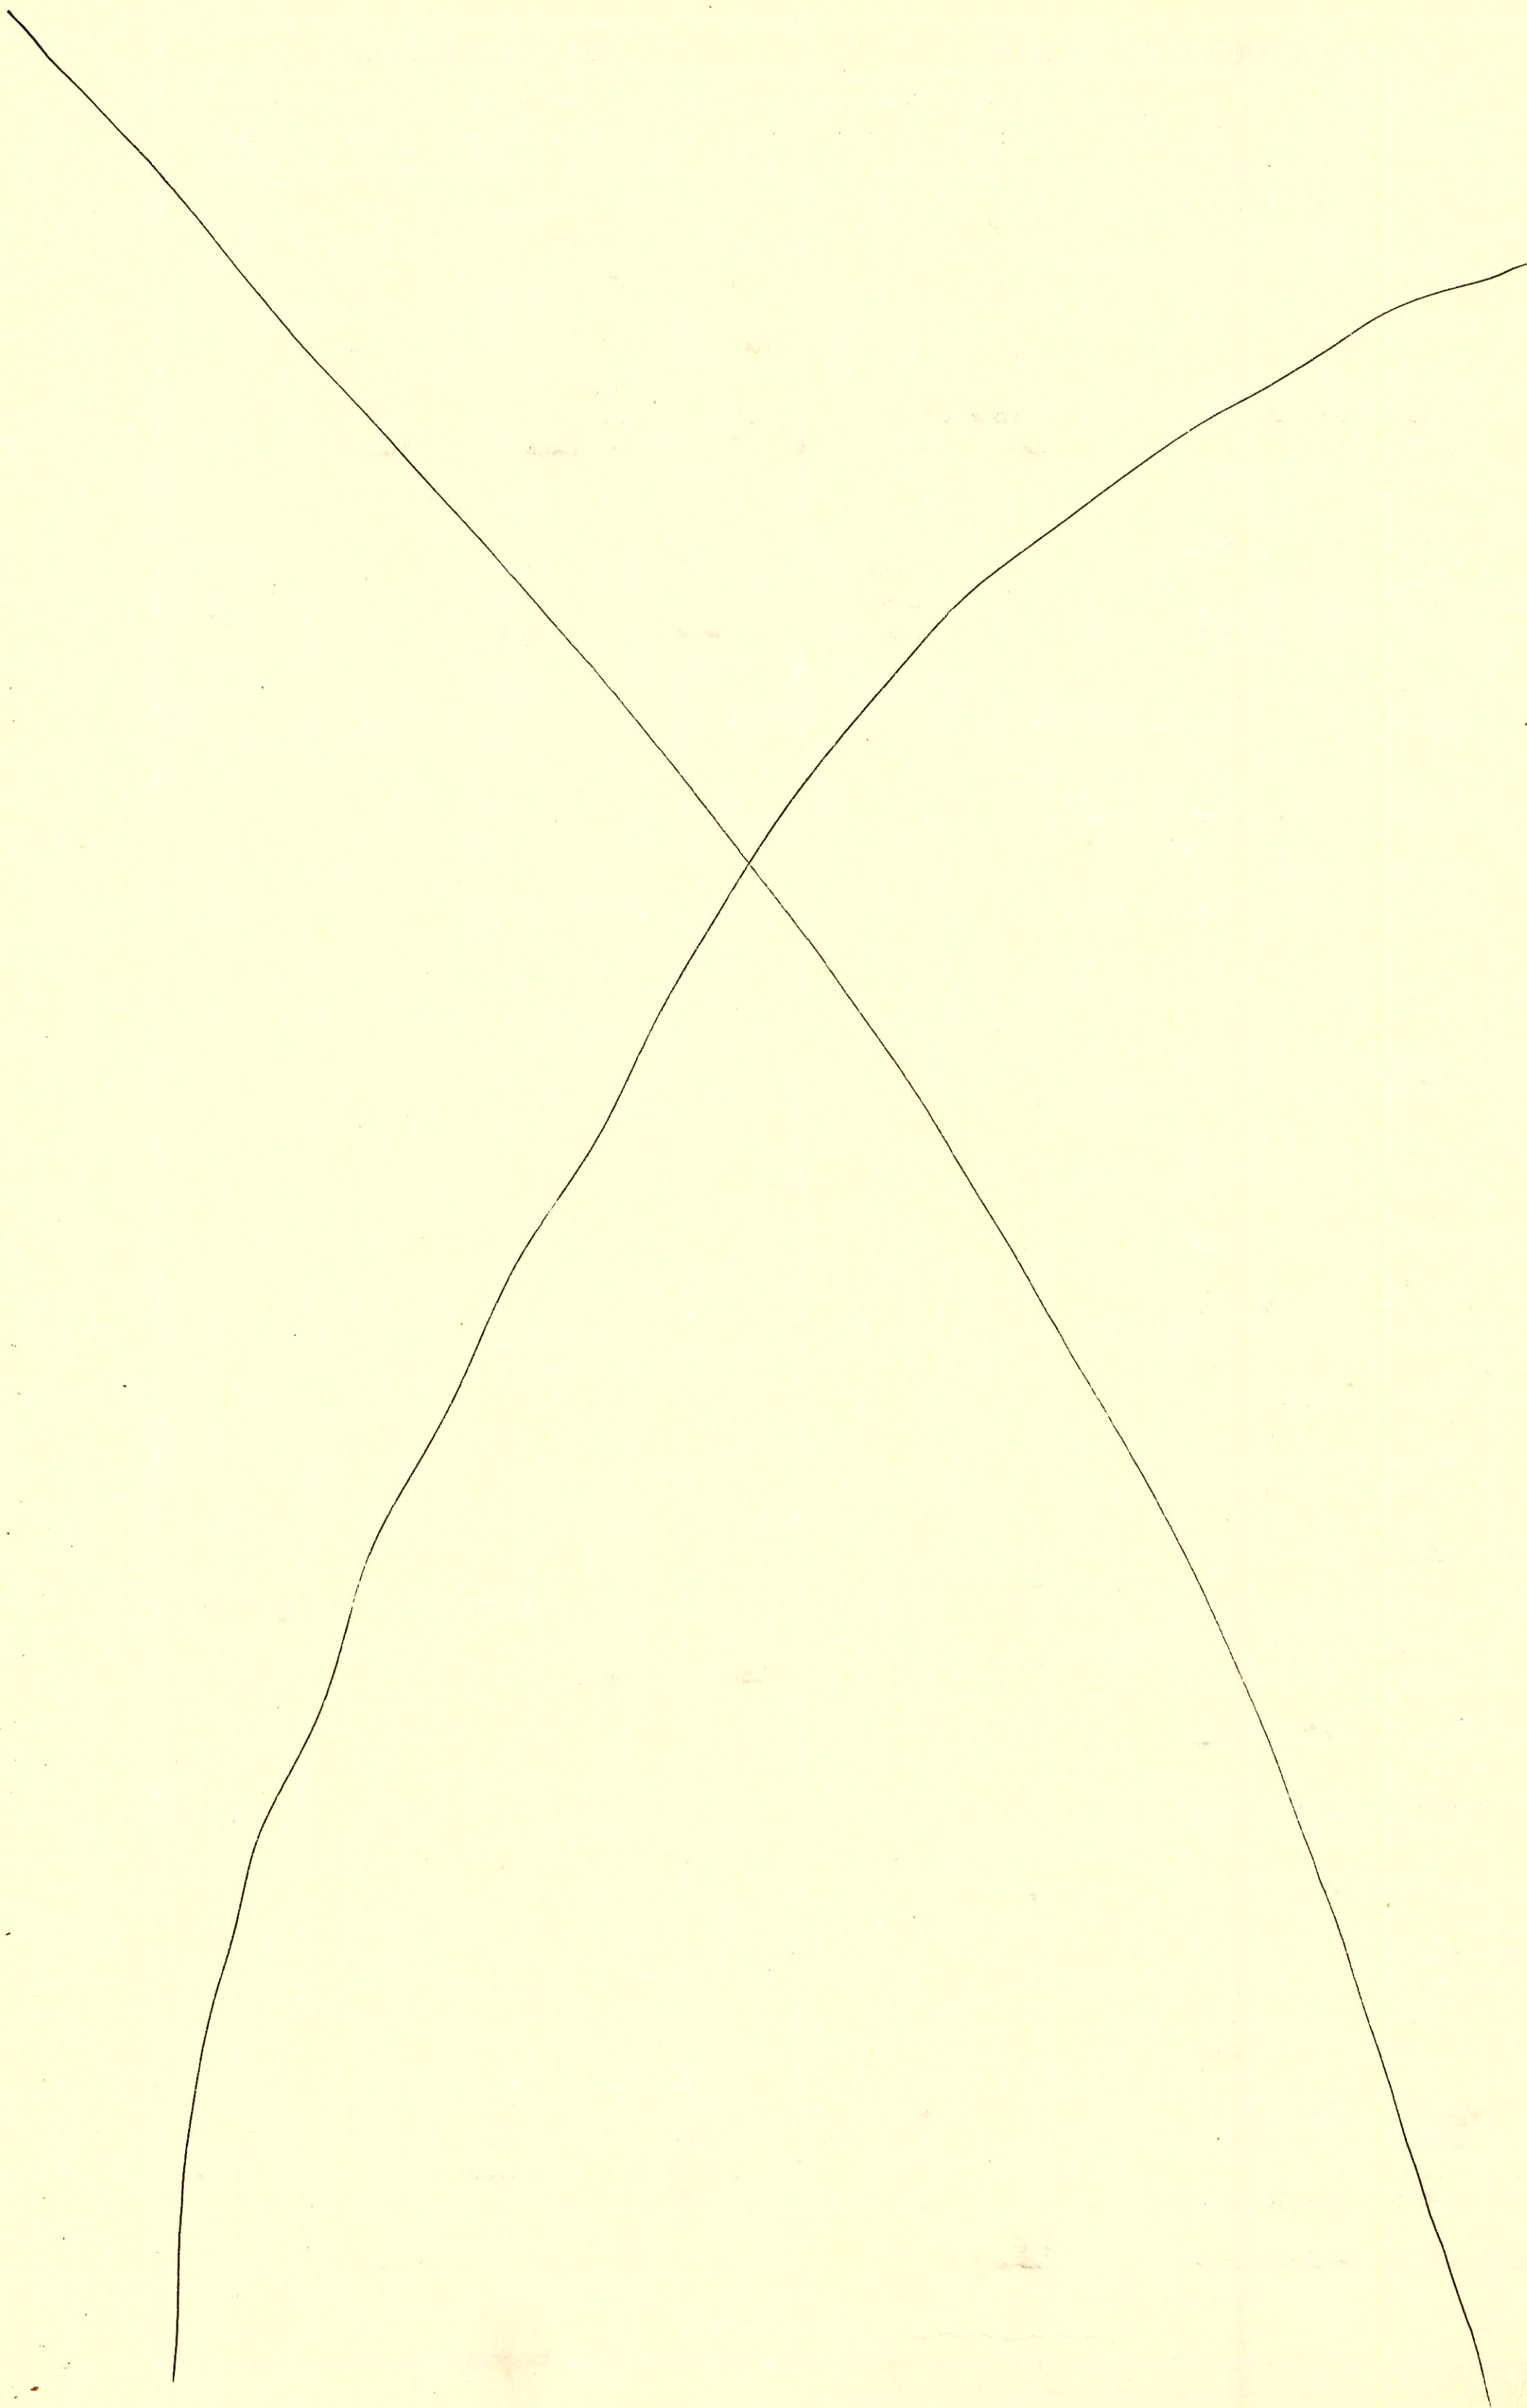

CONSTRUCTION RECORD

SERVICE RECORD

STATION	ELEVATION		Depth	MANHOLE	4-INCH "Y" BRANCHES		No. of Permit		House Number		DATE OF PERMITS	
	Ground	Grade			North West	South East	North West	South East	North West	South East	North West	South East
SAN SEWER AMARADO EST (CONT.)												
LINE A4 0+00	155.6	142.85	12.8	0+00=1749.1 LAT A3	0+41		C67985		1546 Caddy		8-22-78	
1+00	155.7	143.25	12.5		1+36.8		C64999		1550 Caddy Ln		2-7-78	
2+00	155.4	143.66	11.7		2+26		C64484		1554 Caddy Ln		12-15-77	
3+00	155.2	144.06	11.1		3+01.4		C64485		1558 Caddy Ln		12-15-77	
	155.23	144.38	10.8	3+79.1	Stub NW		C66091		1562 Caddy Ln		4-26-78	
LINE A5 0+00	153.0	144.45	8.6	0+00=6+18.7 LAT A3								
	153.11	144.86	8.3	0+97.0		0+70.7	C62047		1543 Caddy Ln		7-14-77	
1+00	150.5	144.97	5.5			0+91.0	C62052		1547 Caddy Ln		8-9-77	
						1+81.1	C66837		1553 Caddy Ln		6-14-78	
2+00	151.0	145.37	5.6									
3+00	151.9	145.77	6.1		2+58.8	2+58.6	C65001	C62265	1542 Amarado	1557 Caddy Ln	3-14-78	7-26-77
4+00	152.5	146.16	6.3		3+48.5	3+35.9	C67645	C62265	1548 Amarado	1561 Caddy Ln	8-1-78	7-26-77
	155.70	146.20	9.5	4+09.0	Stub NE		C64428		1552 Amarado		12-13-77	
LINE B1 0+00	153.16	141.18	12.0	0+00 EXISTING								
1+00	144.6	141.45	3.2									
	153.40	141.63	11.8	1+66.0								
2+00	154.1	141.80	12.3		3+33.6		C67495		1416 Caddy Ln		7-24-78	
3+00	154.8	142.00	12.8		4+17.8		C65449		1412 Caddy Ln		3-26-78	
4+00	154.6	142.20	12.4		5+18.4		C69151		1408 Caddy Ln		10-30-78	
5+00	154.5	142.40	12.1		5+52.5		C66250		1406 Caddy Ln		5-12-78	
	154.5	142.58	11.9	5+37.8								
6+00	154.6	142.71	12.0		6+74.9		C66249		1402 Caddy Ln		5-12-78	
7+00	154.2	142.93	11.3									
8+00	154.2	143.14	11.1									
9+00	154.4	143.36	11.0									
	154.67	143.39	11.3	9+15.5	10" STUB W							
10+00	154.2	143.66	10.5		9+50.0		C57227	C66244	1411 Caddy Ln	1401 Caddy Ln	C57227	5-5-78
					10+50.0		C71366		1434 Valleyview Ct		4-22-79	
11+00	154.1	143.85	10.3									
	155.09	144.04	11.1	11+96.6								
12+00	154.5	144.15	10.4									
13+00	154.8	144.37	10.4		13+02.5		C71490		1438 Valleyview Ct		4-30-79	
	155.46	144.56	10.9	13+83.4	8" STUB SW							
	155.46	144.66	10.8									
14+00	155.1	144.69	10.4		14+37.2		C58939		1405 Caddy Ln		12-17-76	
15+00	155.3	144.86	10.4									
	155.78	144.93	10.9	15+42.2	4" STUB NE							
	155.78	145.03	10.8				C60656		1409 Caddy Ln		4-7-77	
16+00	155.4	145.14	10.3									
17+00	155.3	145.34	10.0		16+77.4		C75163		1489 Valleyview Ct		11-26-79	
	157.09	145.21	11.7	17+34.8			C64999	C75464	1506 Valleyview Ct	1492 Valleyview Ct	2-7-78	11-26-79
	157.09	145.58	11.5									
18+00	154.8	145.83	9.0		17+71.3		C70346		1502 Valleyview		2-26-79	

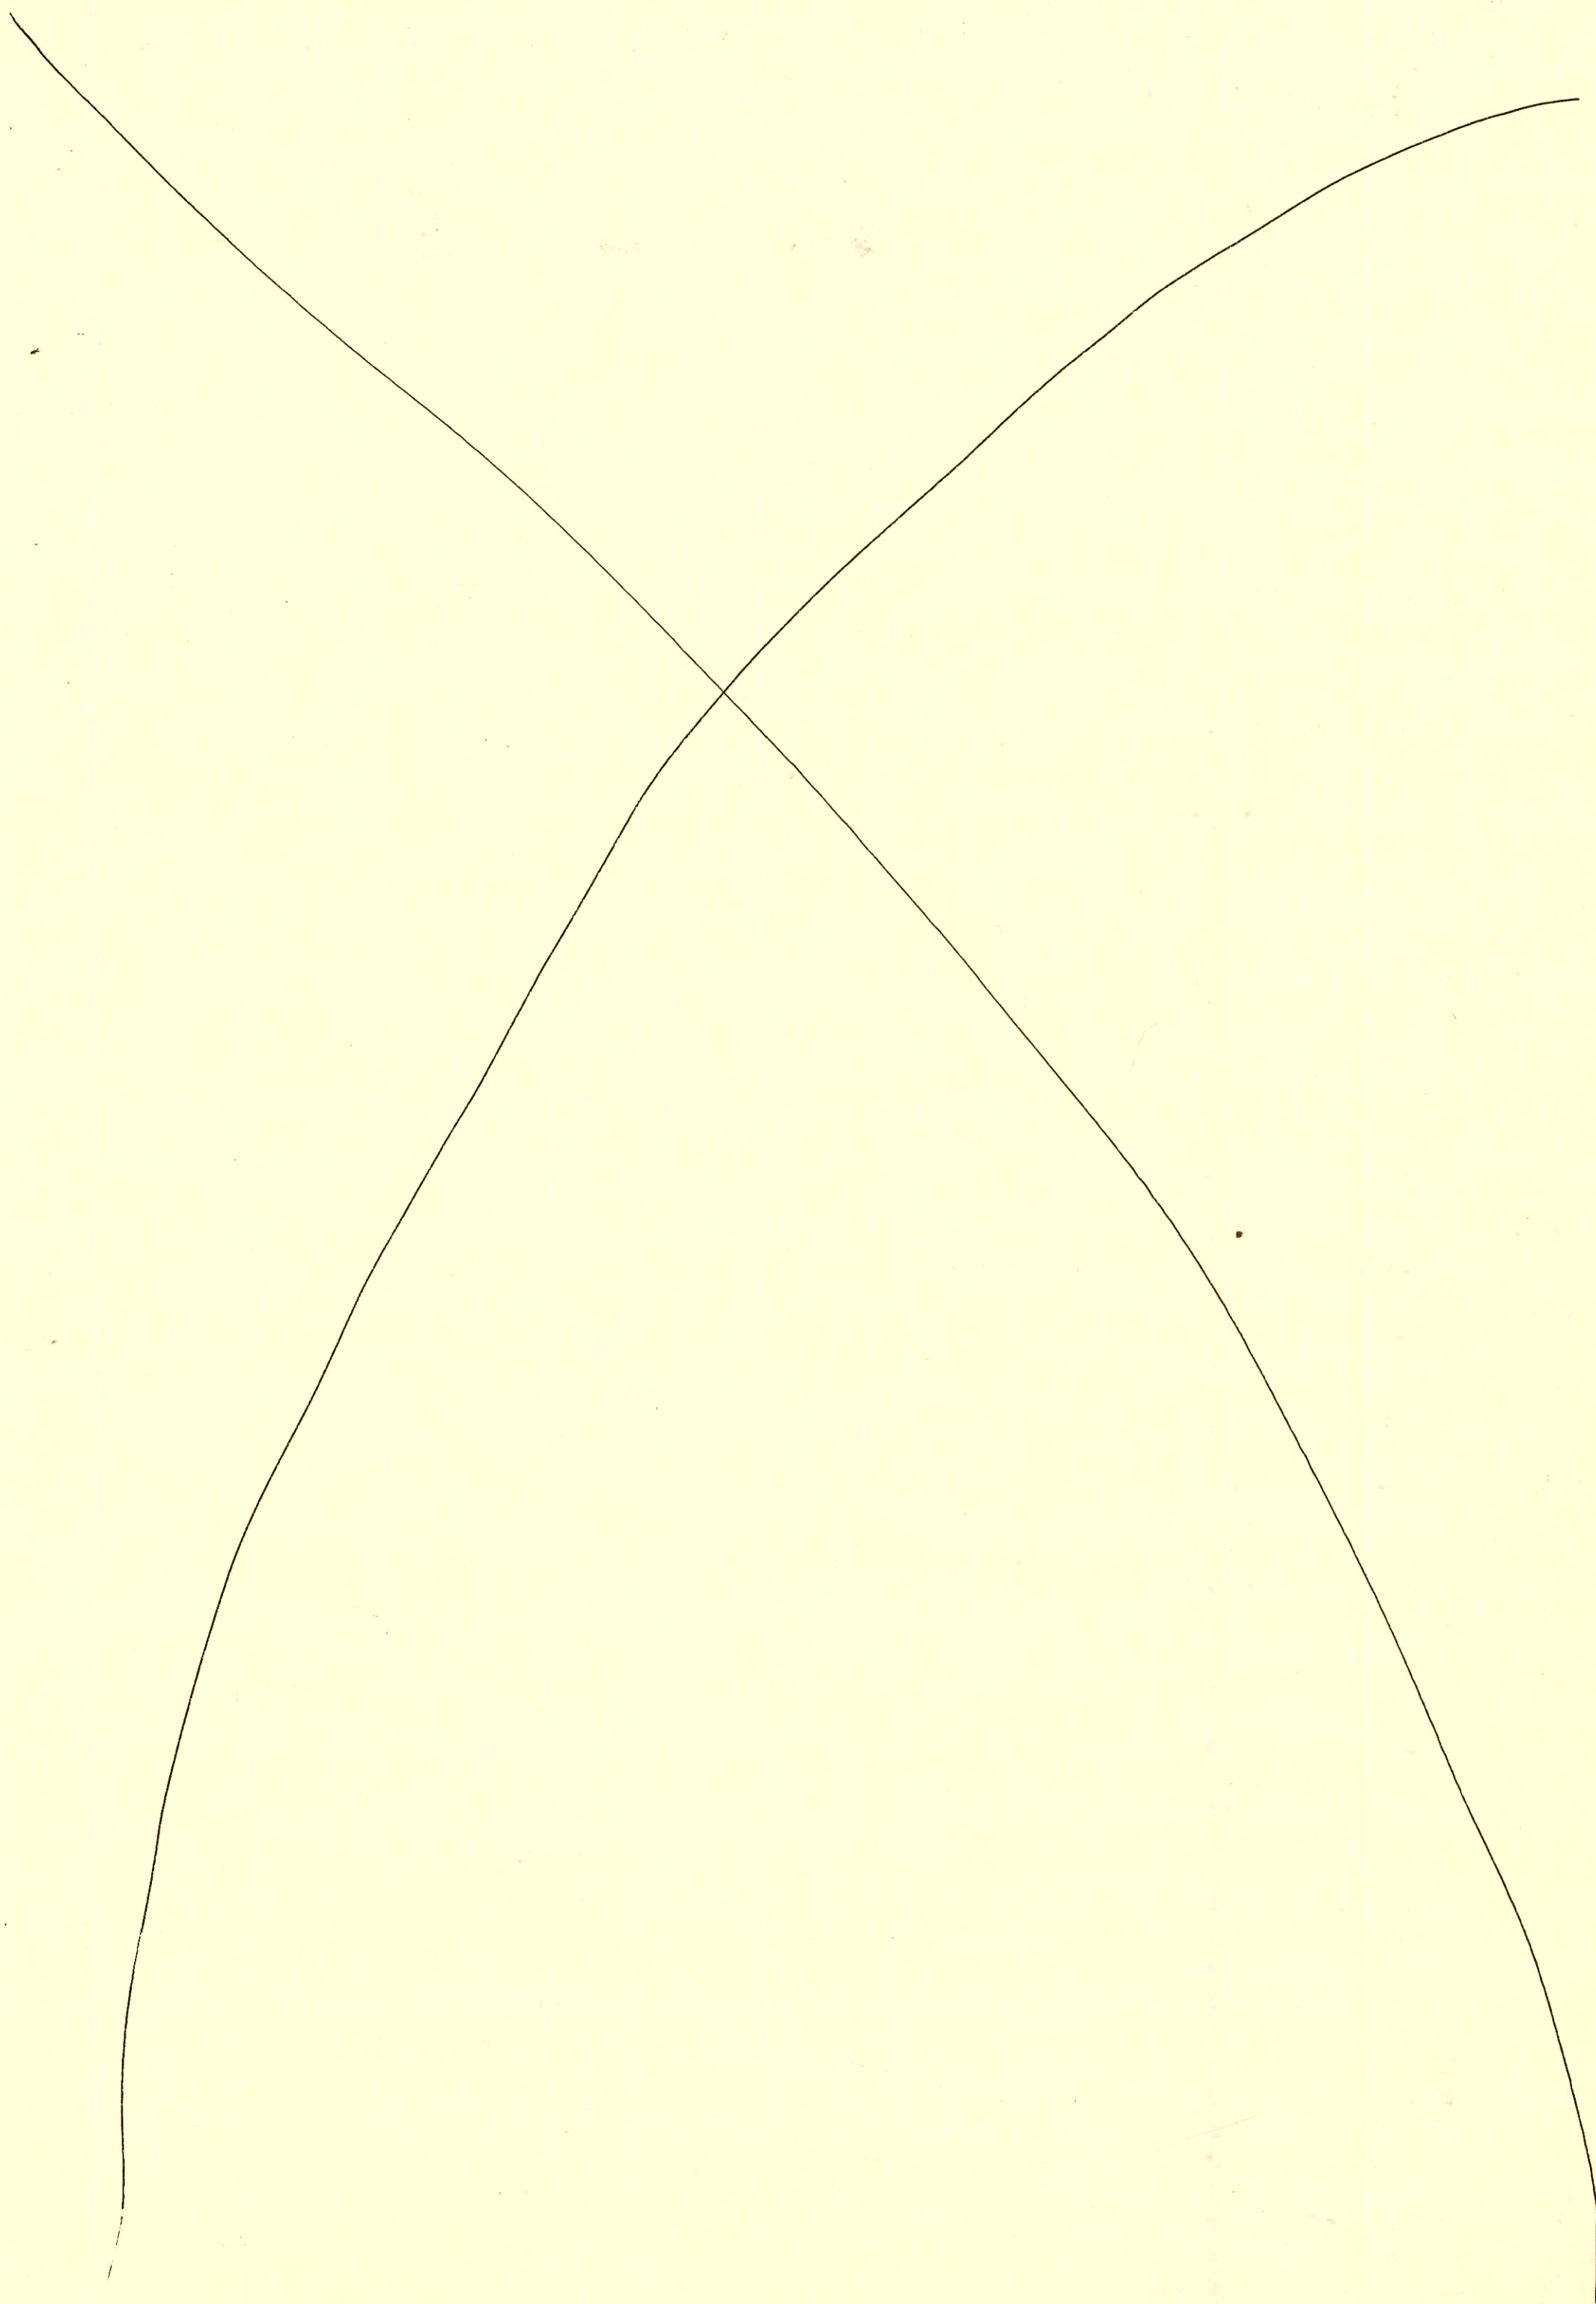

B255

Form 42-020


CONSTRUCTION RECORD

SERVICE RECORD

SAN SEWER AMARADO EST. (CONT.)												
(LINE B1)	19+00	154.7	146.22	8.5	18+45.1		C70251	1496 Ct Valleyview		2-12-79		
		155.78	146.37	9.5								
			146.41	9.4	19+21.5							
	20+00	154.5	146.76	7.7	19+59.5		739	1482 Valleyview Ct		7-14-80		
					20+60.6		C72541	1581 Valleyview		6-25-79		
					20+77.8		2469	1495 Valleyview Ct		1-23-81		
	21+00	154.5	147.20	7.3								
		156.21	147.35	8.9								
		147.45	8.8	21+33.9	8" STUB W							
					21+78.9		C73487	1501 Valleyview		8-7-79		
	22+00	154.6	147.71	6.9								
	23+00	154.7	148.11	6.6								
					23+60.3		C72542	1521 Valleyview		6-25-79		
	24+00	154.5	148.50	6.0								
		157.55	148.65	8.9								
		148.75	8.8	24+38.0			C6562	1525 VALLEYVIEW		5-21-78		
	25+00	154.8	149.03	5.8								
		157.39	149.26	8.1	25+52.4	8" STUB W	C75203	1517 Valleyview Ct		11-5-79		
					25+33.0		C75466	1513 Valleyview		5-24-78		
LINE B2	0+00	155.09	144.31	10.8	0+00=11+96.6 LINE B1		57228	1421 R Caddy		12-4-97		
					0+13.6					8-16-76		
					0+90.0		C58687	1461 Caddy		11-15-76		
	1+00	154.2	144.73	9.5								
		154.71	144.90	9.8	1+41.5	Stub North	C67375	1453 Caddy		7-17-78		7-20-76
LINE B3	0+00	153.5	141.73	11.8	0+00=1466.0 LINE B1							
					0+73.8		C64043	1420 Caddy		11-16-77		
	1+00	154.2	141.89	12.3								
		154.38	142.02	12.5								
		142.02	12.4	1+18.6								
	2+00	155.1	142.22	12.9								
		154.99	142.29	12.7								
		142.39	12.6	2+28.0								
	3+00	157.0	142.51	14.5								
					3+80.3		C68205	1474 Caddy		9-6-78		
	4+00	156.1	142.68	13.4								
		155.60	142.70	12.9								
		142.80	12.8	4+08.4			C57777	1510 Caddy		10-5-76		4-7-77
	5+00	155.9	143.02	12.9								
	6+00	154.4	143.25	11.2								
		154.94	143.31	11.6	6+24.0		58000	1506 Caddy		10-5-76		
					6+71.9		C61237	1507 Caddy		5-23-77		
	7+00	152.9	143.46	9.4								
	8+00	153.1	143.66	9.4								
		154.94	143.86	11.1								
		143.96	11.0	8+99.2			C58686	1485 Caddy		11-15-76		
	9+00	153.0	143.96	9.0			C62608	1503 Caddy		8-17-77		
	10+00	152.5	144.29	8.2								
	11+00	152.8	144.61	8.2								
		152.85	144.85	8.0								
		145.02	7.8	11+73.1	11+21.4		C60560	1531 Caddy		3-31-77		
	12+00	153.0	145.07	7.9								
					12+54.6		C65155	1525 Caddy		2-28-78		
	13+00	153.7	145.26	7.4								
		154.74	145.26	9.5								
		145.36	9.4	13+02.5			C61553	1519 Caddy		6/10/77		
	14+00	151.2	145.74	5.5								
					14+56.9		C58939	1465 Caddy		12-2-76		
	15+00	153.2	146.12	7.1								
		154.08	146.32	7.8								
		146.42	7.7	15+50.7			C65549	1528 Valleyview		3-29-78		
	16+00	155.0	146.60	8.4								
					16+56.9		C70121	1542 Valleyview		1-16-79		
	17+00	155.0	146.96	8.0								

* 1501 Valleyview has 2 connections to same house

B256 A

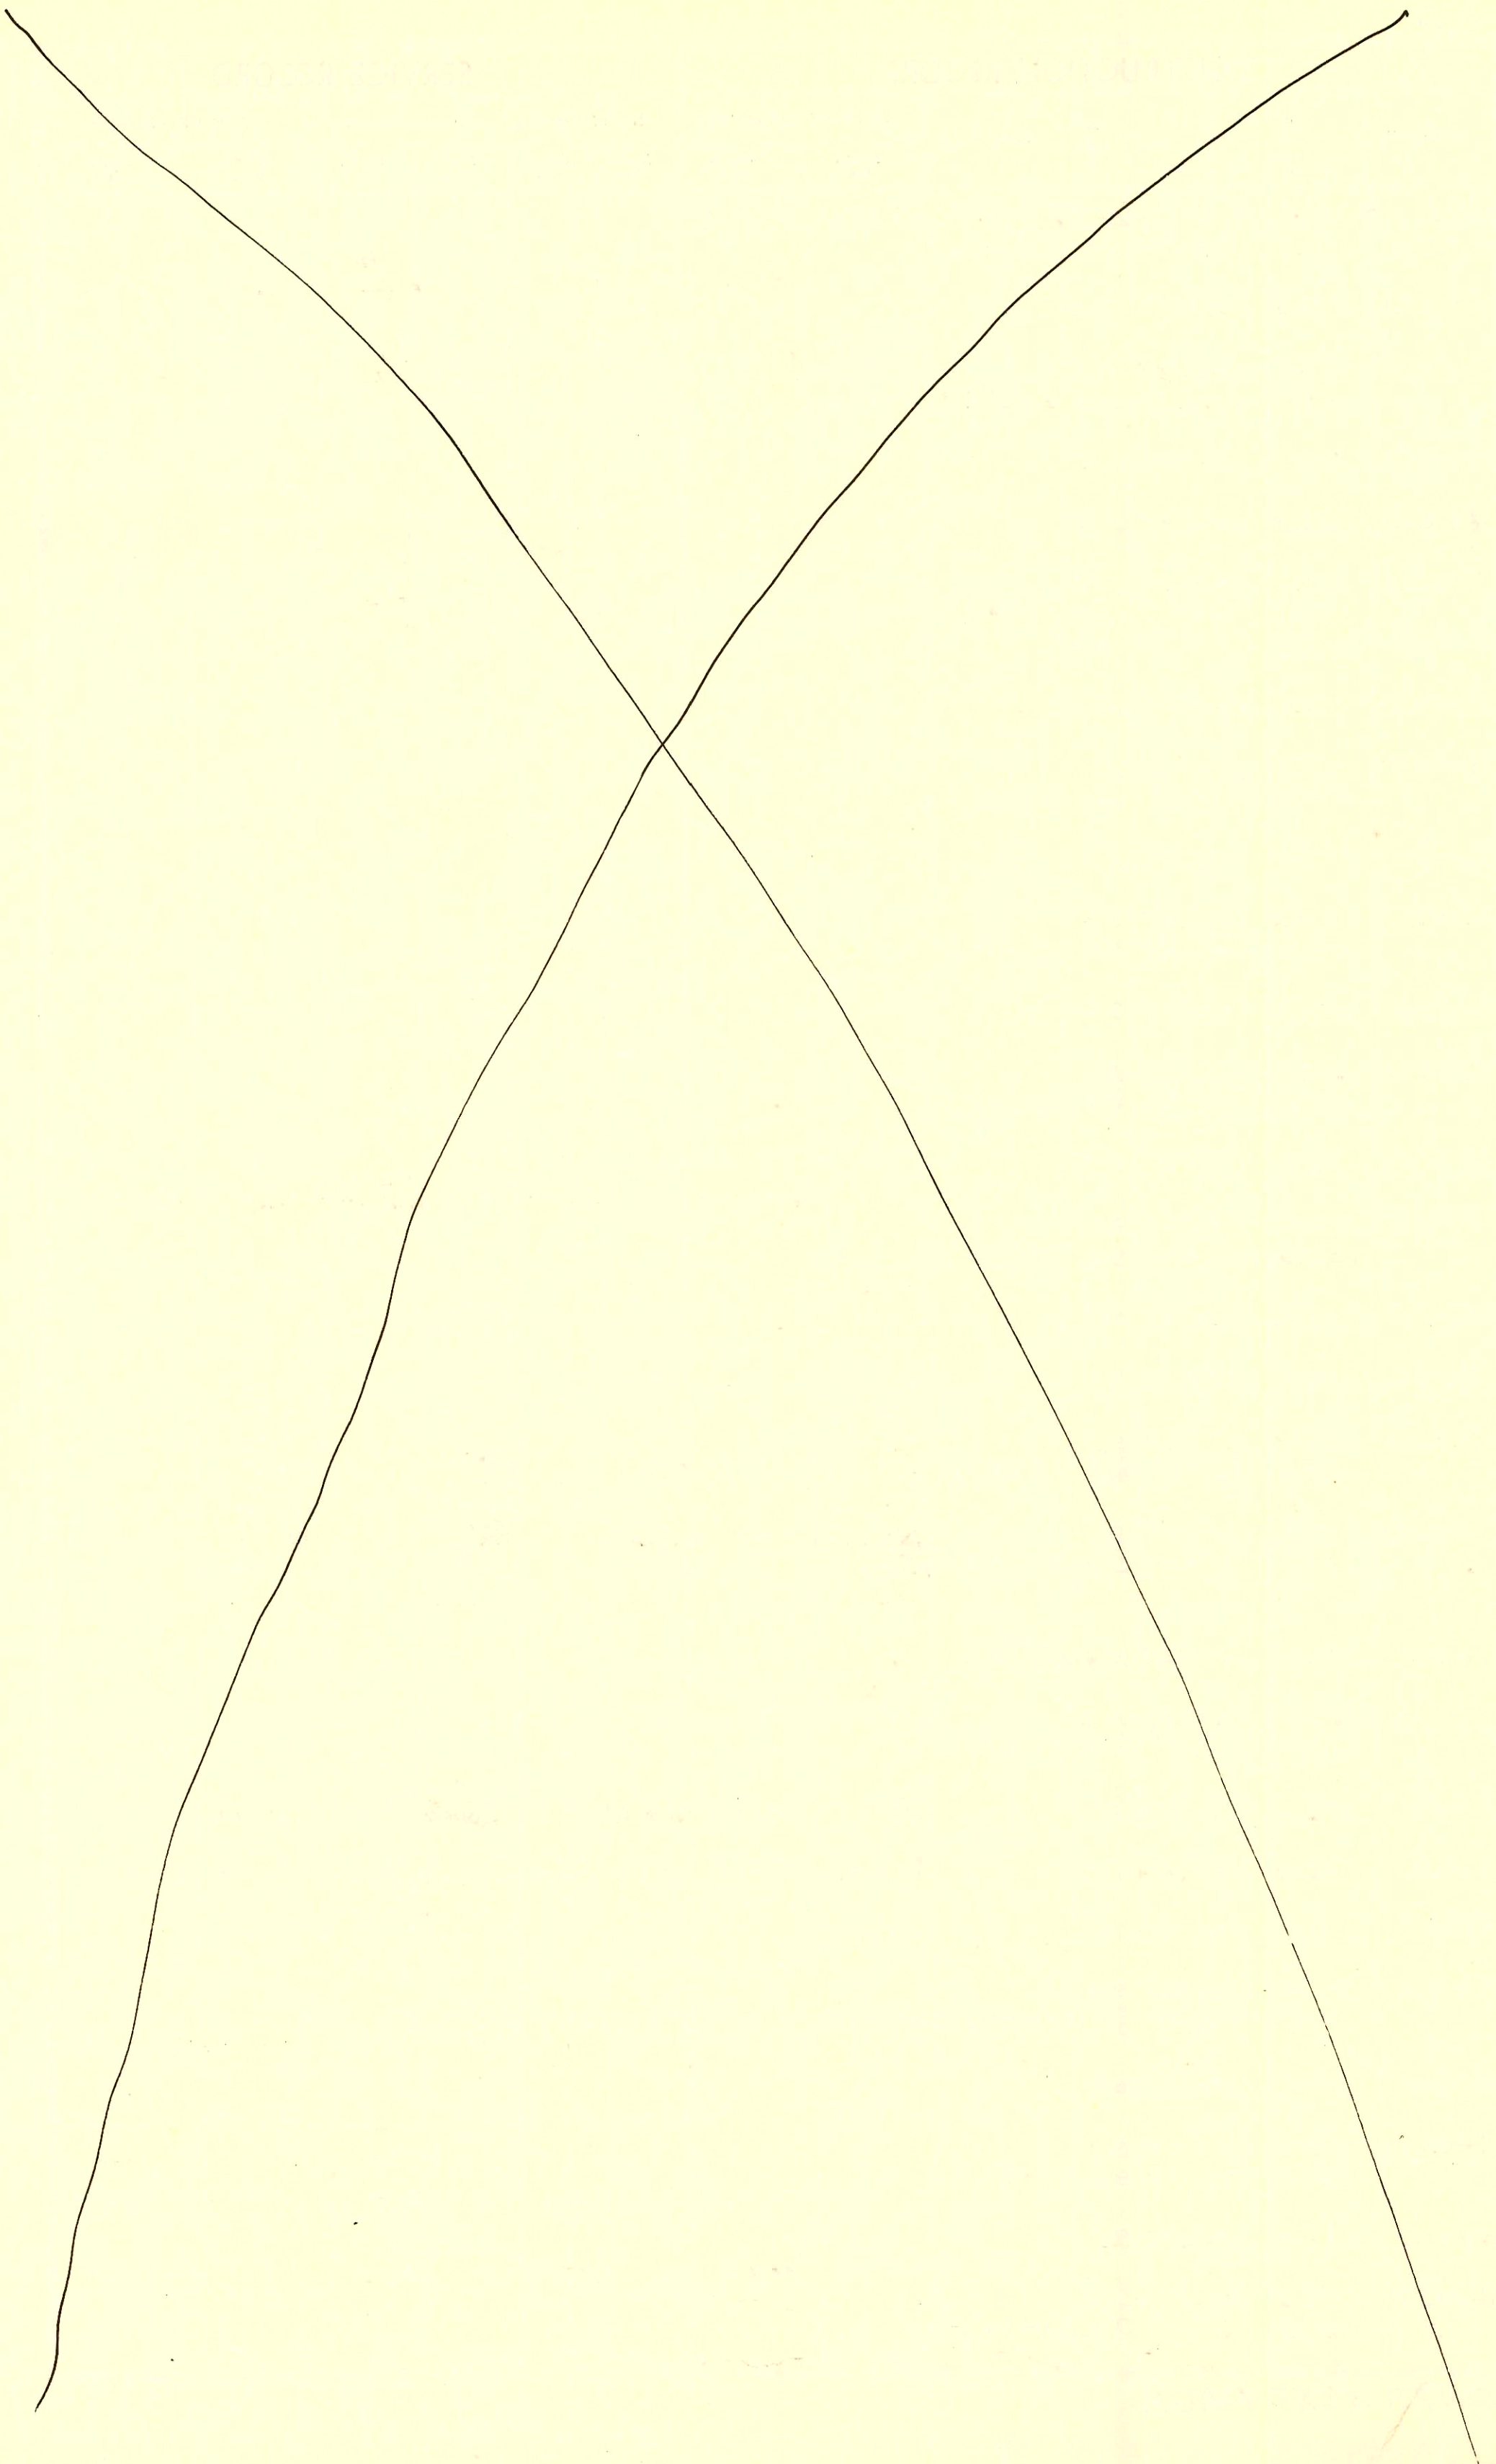

B256


Form 42-020

CONSTRUCTION RECORD

SERVICE RECORD

SAN SEWER AMARADO EST. (CONT.)												
LINE B3 (CONT.)	154.78	OUT 147.29 IN 147.39	7.5 7.4	17+89.2	1AP 17+96.7	C64108	1546 Valleyview Ct	11-18-77				
18+00	154.6	147.44	7.2									
19+00	154.3	OUT 147.89 154.31 IN 148.07	6.4 6.3 6.2	19+17.2	1AP 18+35.3	C67076	1550 Valleyview	6-26-78				
	154.23	OUT 148.32 IN 148.42	5.9 5.8	19+80.6								
20+00	154.3	148.50	5.8		1AP 20+19.4	C6704	1545 Valleyview	7-18-78				
21+00	154.6	148.94	5.7									
	156.00	148.97	7.0	21+06.3	4"STUB SW	C68249	1539 G Valleyview	9-8-78				
LINE B4	0+00	154.99	142.56	12.4	0+00=2+28.0 LINE B3							
1+00	154.2	143.01	11.2									
2+00	155.21	143.46	11.8	2+00.1	1+30.0 4"STUB NW	5845 C60532	1518 Caddy Ln Ct 1520 Caddy Ln Ct	10-26-76 3-28-76				
LINE B5	0+00	155.6	142.97	12.6	0+00=4+08.4 LINE B5							
1+00	154.5	OUT 143.47 155.24 IN 143.62	11.0 11.7 11.6	1+11.0	0+27 1+25	C62408 C66386	1428 Caddy Ln Ct 1432 Caddy Ln Ct	8-31-77 5-12-78				
2+00	153.5	143.96	9.5		1AP 2+26.0	C56748	1440 Caddy Ln Ct	8-3-77 7-16-76				
3+00	153.5	144.34	9.2		1AP 3+20.7	C61978	1448 Caddy Ln Ct	7-12-77				
	154.22	144.59	9.6	3+65.0	4"STUB SW 1AP 3+99.0	57276 C64382	1448 Caddy Ln Ct 1444 Caddy Ln Ct	12-27-76 12-8-77				
LINE B6	0+00	154.9	143.48	11.4	0+00=6+24.0 LINE B3							
1+00	153.1	143.87	9.2		0+68.6	C57784	1464 Caddy Lane	2-7-77				
	155.24	143.99	11.3	1+30.1	4"STUB NW 4"STUB NE	C56747	1452 Caddy Ln	7-16-76				
LINE B7	0+00	154.9	144.13	10.8	0+00=8+39.2 LINE B3							
1+00	153.5	144.56	8.9		1AP 0+57.6 1AP 0+67.7 1+41.5	C62608 263841 5410	1503 Caddy Ln Ct 1507 Caddy Ln Ct 1513 Caddy Ln Ct	8-18-77 11-3-77 3-22-80	12-10-77 11-23-76			
2+00	154.0	OUT 144.99 155.12 IN 145.16	9.0 10.1 10.0	2+15.8	1AP 2+81.6	C65601	1580 VALLEYVIEW	5-24-78				
3+00	154.3	145.48	8.8		1AP 3+86.9	C64850	1526 Valleyview	3-30-78				
4+00	154.2	145.85	8.4									
5+00	154.0	OUT 146.22 156.02 IN 146.41	7.8 9.7 9.6	5+23.4	1AP 4+45.6 1AP 5+16.9	C65351 C66694	1523 Valleyview 1518 Valleyview	3-14-78 6-5-78				
	156.00	146.59	9.4	5+60.7	4"STUB SW 4"STUB W	C61146 C64730	1510 Valleyview 1514 Valleyview	5-13-77 12-13-77				
LINE B8	0+00	155.0	145.16	9.8	0+00=2+15.8 LINE B7							
1+00	154.3	145.52	8.8									
	155.26	145.66	9.6	1+39.3	4"STUB SW 4"STUB SE	C66693 C61238	1473 Caddy Ln Ct 1477 Caddy Ln Ct	6-5-78 5-23-77				
LINE B9	0+00	155.1	145.16	9.9	0+00=2+15.8 LINE B7							
	155.08	145.39	9.7	0+82.8	4"STUB N	9509 5411 C64996 C6804	1534 Valleyview 1513 Caddy Ln Ct	6-24-83 3-22-82 6-29-77	2-7-78			
LINE B10	0+00	152.9	145.35	7.6	0+00=11+73.1 LINE B3							
1+00	152.4	145.68	6.7			2+08.6	59316	1534 Caddy Ln	12-29-76			
2+00	152.8	146.01	6.8			2+97.4	39317	1520 Caddy Ln	12-29-76			
3+00	152.9	146.34	6.6									
	153.75	146.58	7.2	3+74.3	4"STUB S							

B2564C

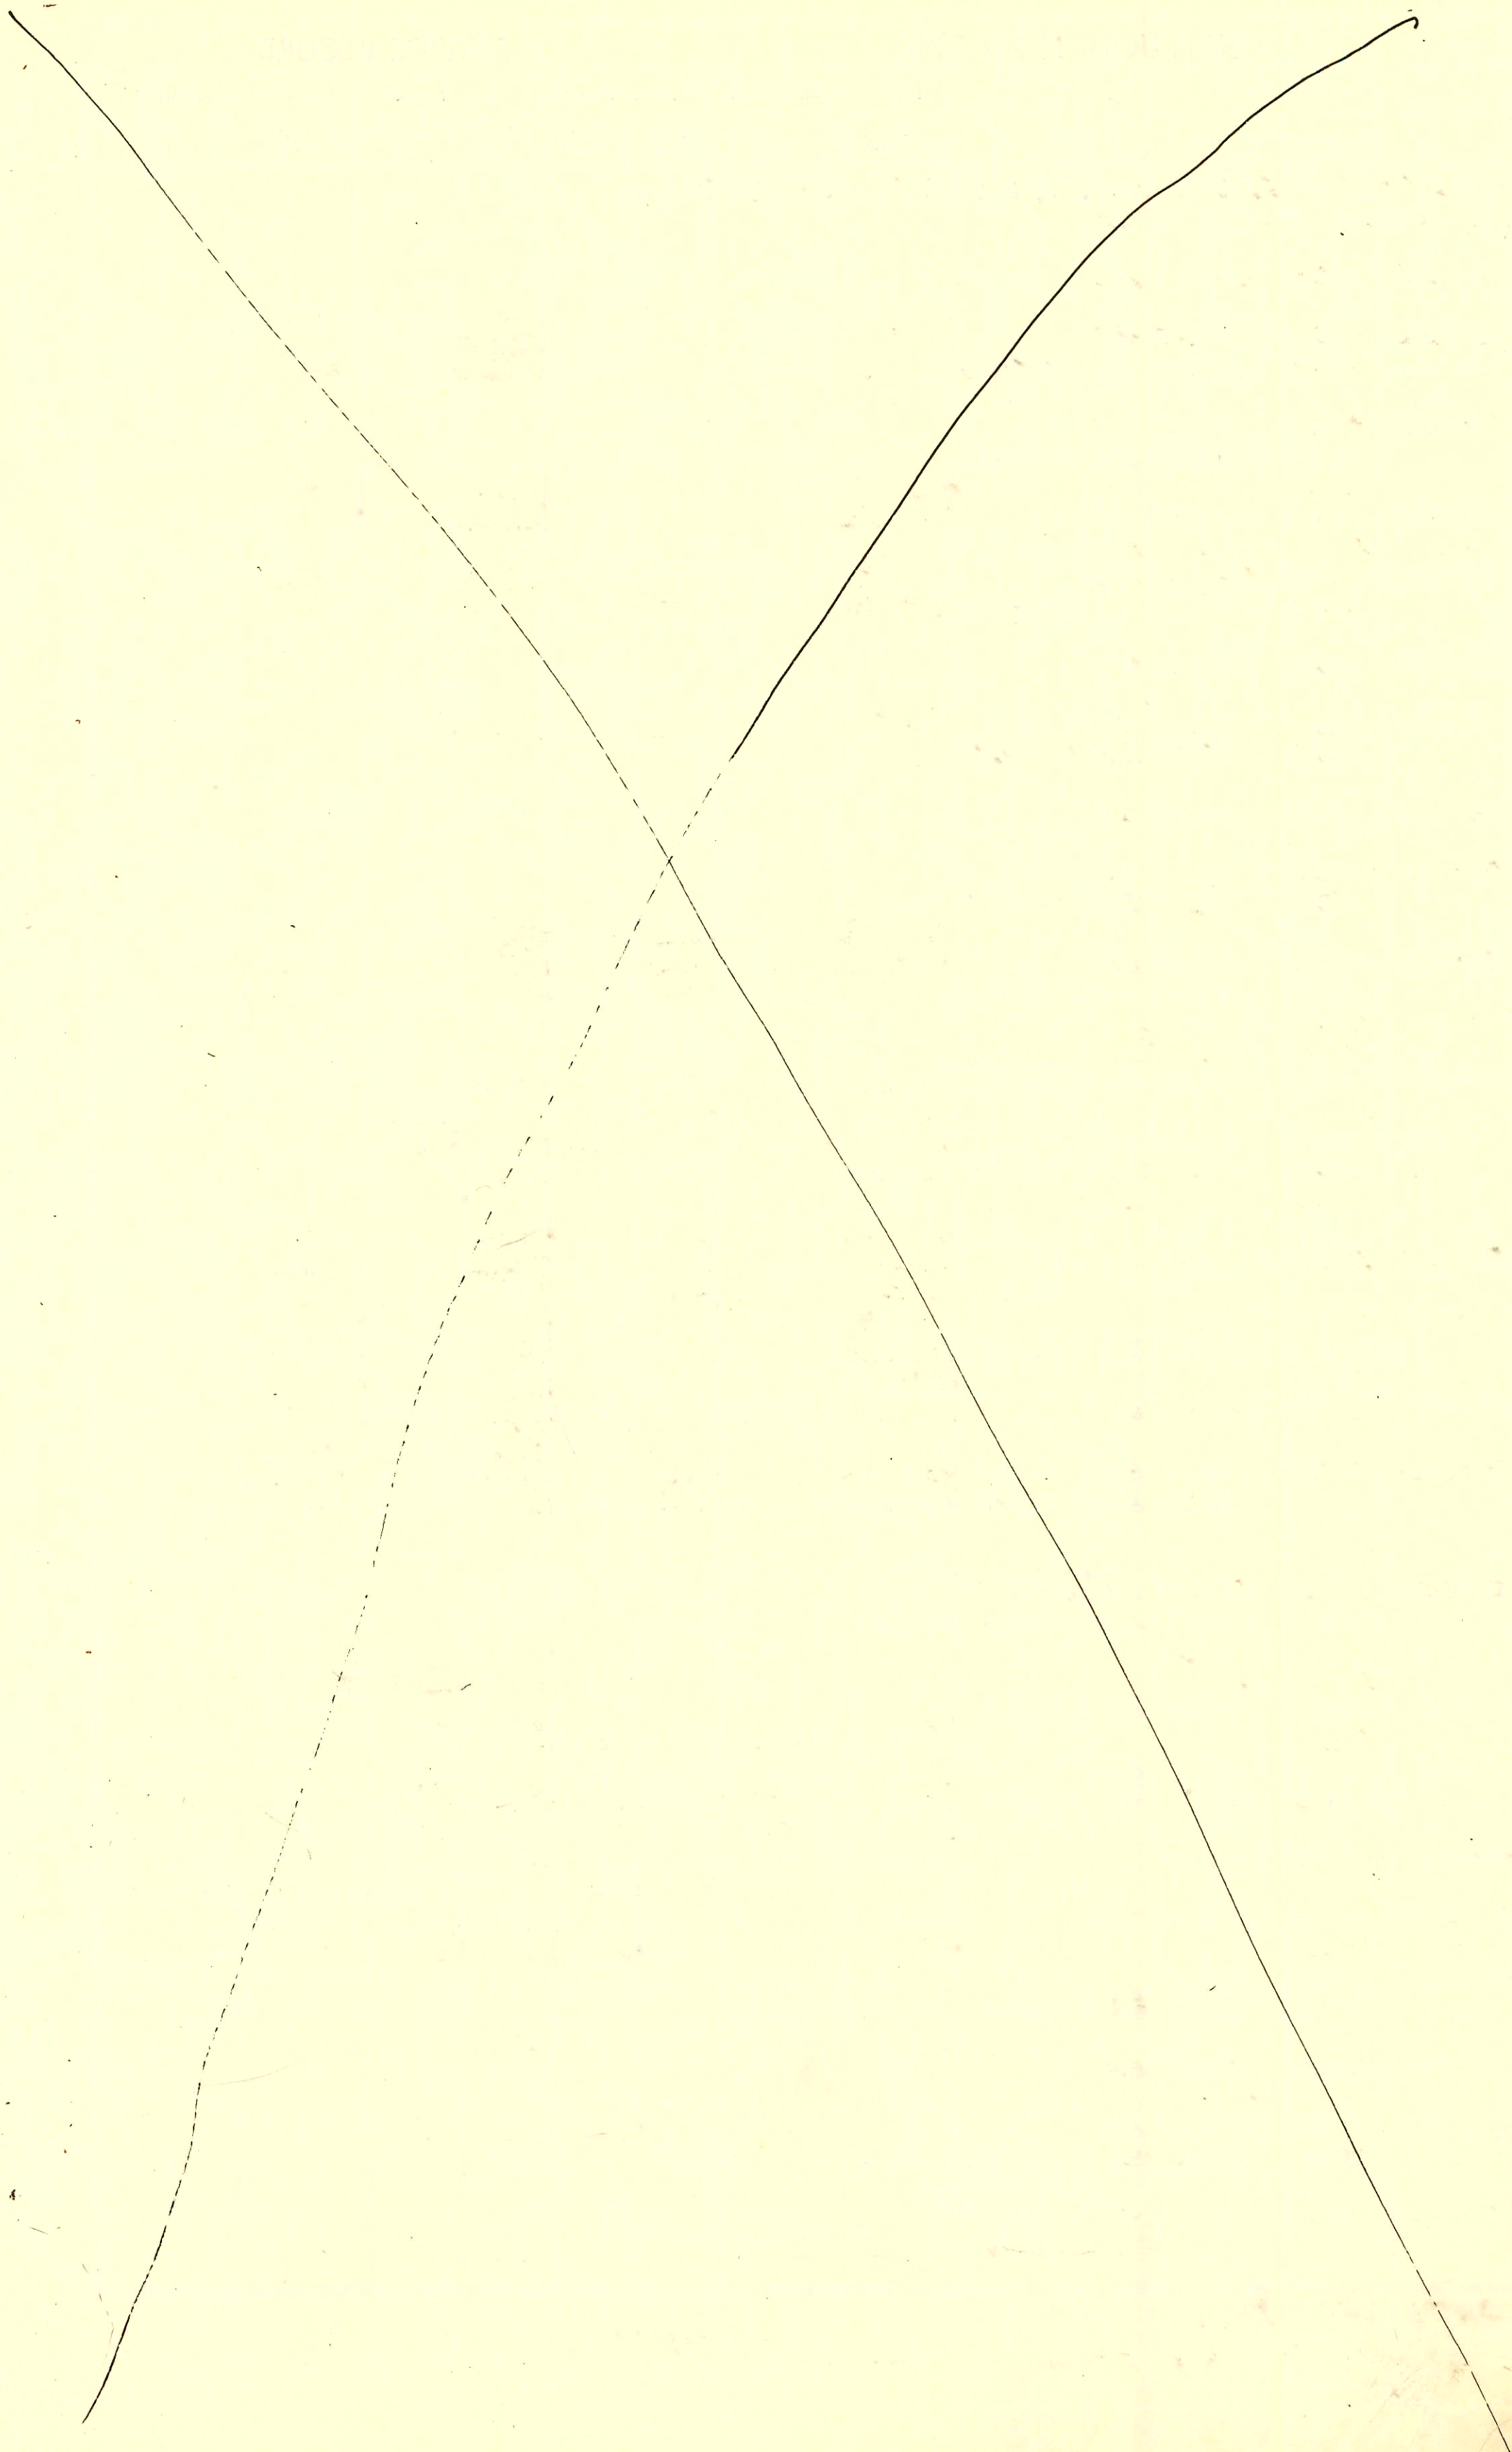

B
B256A

Form 42-020

CONSTRUCTION RECORD

SERVICE RECORD

LATERAL 18 MAIN 3 WESTLINK SAN SEWER

STATION	ELEVATION		Depth	MANHOLE	4-INCH "Y" BRANCHES		No. of Permit		House Number		DATE OF PERMITS	
	Ground	Grade			North West	South East	North West	South East	North West	South East	North West	South East
LINE 1 0+00	154.3	143.57	10.7	0+00 EXISTING								
1+00	154.8	143.77	11.0									
2+00	155.3	143.97	11.3		1+52.3		C75462		1430		11-26-77	
	155.7	144.17	11.5	2+99.2	2+86.6		C74420		1426		9-20-79	
3+00	155.7	144.17	11.5				C72800		1422		7-6-79	
4+00	155.8	144.37	11.4		4+01.5				1412		7-14-80	
5+00	155.8	144.57	11.2		4+82.5		741		1414		9-2-80	
6+00	155.7	144.77	10.9	5+99.0	5+88.4		836		1410		7-24-80	
7+00	155.4	144.97	10.4		6+27.0		#00713		406		7-14-80	
8+00	155.3	145.17	10.1									
	155.4	145.34	10.1	8+83.5			16902		1402		8-29-86	
9+00	155.3	145.47	9.8									
10+00	155.0	145.67	9.3									
	155.2	145.72	9.4	10+27.4								
11+00	155.5	145.97	9.5		10+94.4		#02260		1465		1-5-81	
12+00	155.9	146.17	9.7		11+14.7		2259		10103		1-5-81	
	156.0	146.22	9.8	12+24.7	11+89.1		788		10107		7-18-80	
13+00	156.0	146.47	9.5		13+06.7		787		10109		7-18-80	
14+00	156.0	146.67	9.3		13+52.5		#169		10113		4-25-80	
	156.0	146.76	9.2	14+44.7	13+86.6	12+61.7 tap	170	23212	10115	15202	4-25-80	6-3-91
15+00	156.2	146.87	9.3									
16+00	156.7	147.07	9.6		14+61.2		3191		10203		4-28-81	
17+00	157.2	147.27	9.9		15+28.7		3195		10205		4-28-81	
	157.2	147.30	9.9	17+13.5	15+83.8		2257		10231		1-5-81	
18+00	157.5	147.57	9.9		16+26.4		2258		10233		1-5-81	
	157.5	147.59	9.9	18+08.3	16+85.6		1145		10305		9-8-80	
					17+01.5		1144		10303		9-8-80	
					17+23.0		1057		10323		8-22-80	
					17+34.1		1058		10325		8-22-80	
					18+12.3		1606		10343		10-29-80	
					4" STUB NW		1605		10341		10-29-80	
					8" STUB W							
LINE 2 0+00	155.0	144.62	10.4	0+00 EXISTING								
1+00	155.2	144.86	10.3		0+68.4	0+73.0	C70544	C71491	1484	1442	3-9-77	4-30-77
	155.5	145.08	10.4	1+92.7	1+16.3		7119		1446		9-2-80	
2+00	155.6	145.20	10.4		2+59.6	2+07.7	C70348	C71356	1480	1450	2-26-79	4-18-79
3+00	156.0	145.40	10.6		3+04.1	3+51.8	C72779	C71734	1476	1454	7-6-79	3-10-80
4+00	156.0	145.60	10.4		4+12.1	4+73.1	#545		1472	1458	6-11-80	
5+00	155.6	145.80	9.8		5+17.6	5+05.7	C71808	C714019	1472	1462	5-7-79	8-29-79
	155.5	145.84	9.7		6+77.0		C74421	4544	1468	1466	9-20-79	6-11-80
6+00	154.5	146.10	8.4									
7+00	154.8	146.30	8.5				C76888		1469		3-18-80	
8+00	156.0	146.38	9.6	7+41.7								
9+00	156.0	146.50	9.5				#00712		10104		7-14-80	
	156.0	146.70	9.3				C72081		10118		5-30-79	
	156.0	146.73	9.3	9+14.6								
					9+75.5		#124		10202		4-21-80	


CONT'D NEXT PAGE

99-05892-0701 10/29/99 1448 N MAIZE RD - TOP at 15+10.3 4" sch PUC

B2568 E

CROSS SECTION

WATER TABLE

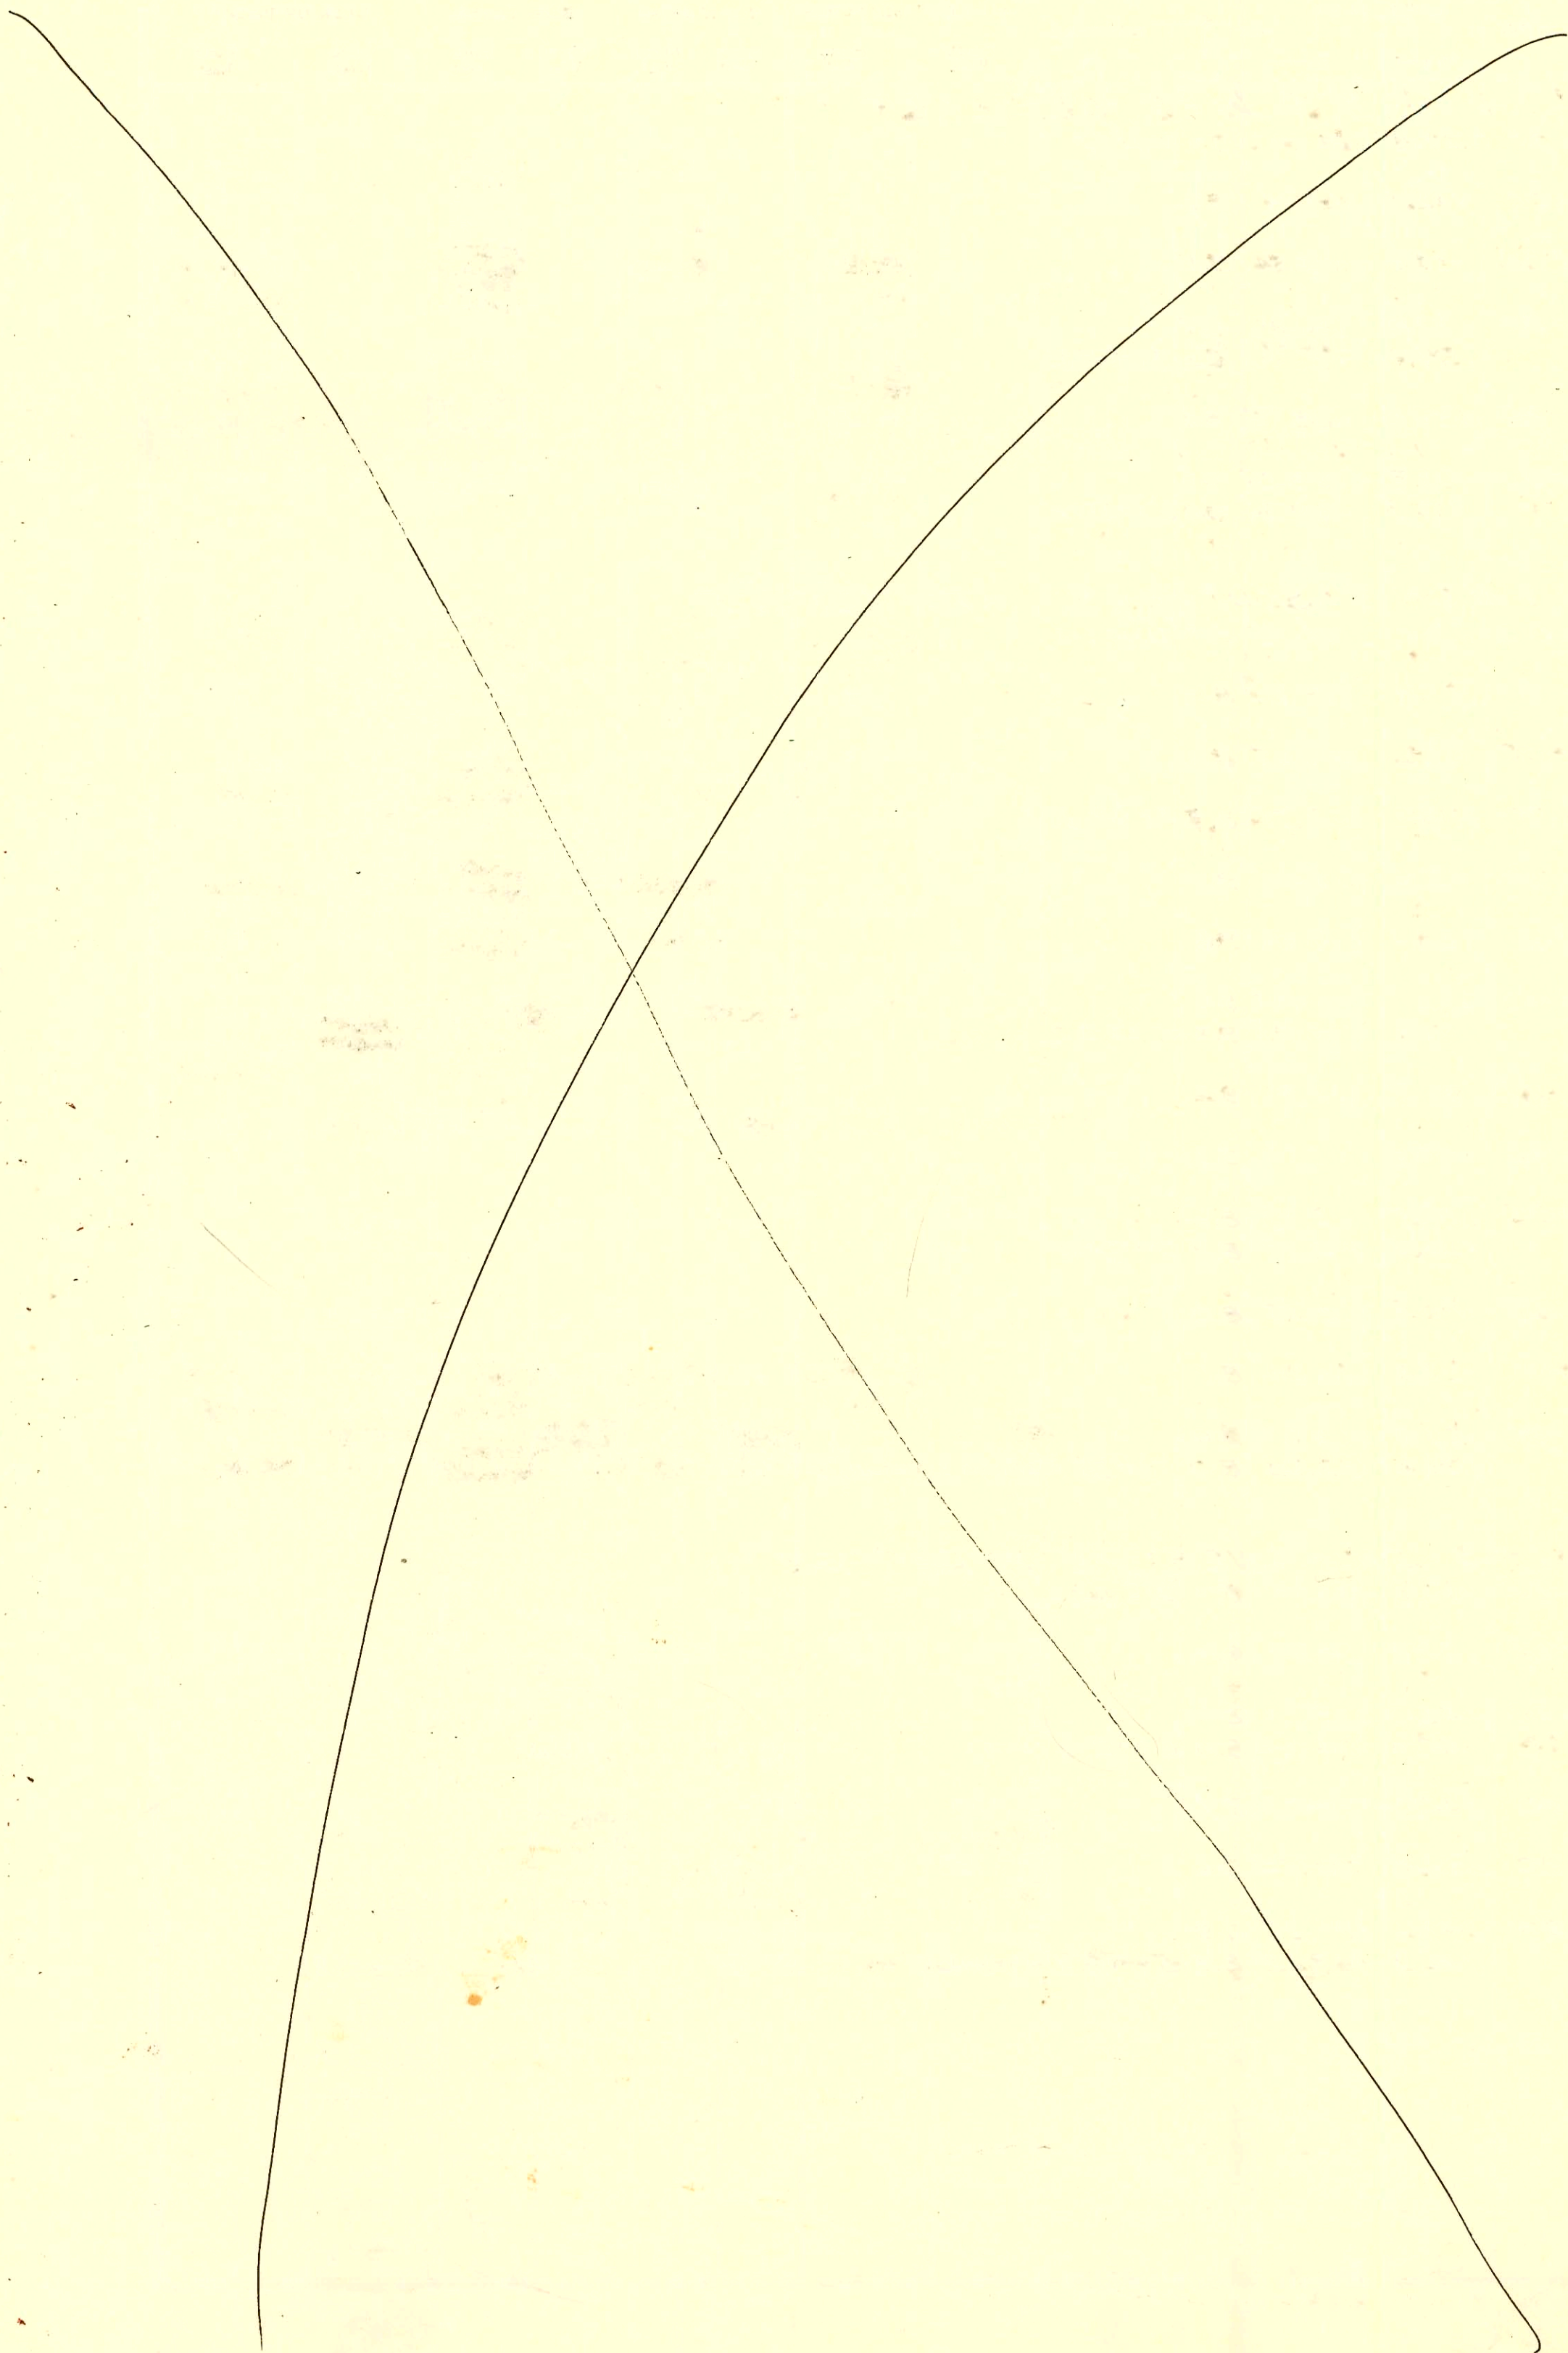

CONSTRUCTION RECORD

SERVICE RECORD

LATERAL 18 MAIN 3 WESTLINK (CONTD)

STATION	ELEVATION		Depth	MANHOLE	4-INCH "Y" BRANCHES		No. of Permit		House Number		DATE OF PERMITS	
	Ground	Grade			North West	South East	North West	South East	North West	South East	North West	South East
LINE 2 CONTR												
10+00	156.0	146.90	9.1									
11+00	155.2	147.10	8.1									
12+00	155.7	147.30	8.4			11+75.5	C74419		10254		9-20-79	
	155.9	147.32	8.6	12+10.3		11+56.8	C70886		10205		3-28-79	
									ALAMO CT			
13+00	156.6	147.50	9.1									
	157.0	147.54	9.5						10302		9-20-79	
		147.64	9.4	13+17.8		13+51.8	C74418		ALAMO CT			
14+00	158.0	147.80	10.2									
15+00	158.0	148.00	10.0			47'E 8' the	16249		10342		5-8-80	
	158.0	148.19	9.8			W. FL.			ALAMO CT			
	158.0	148.23	9.7	15+93.3								
16+00	158.0	148.30	9.7									
17+00	158.0	148.50	9.5			16+54.7	16373		10338		9-29-80	
	158.0	148.69	9.3			17+37.8	C71368		ALAMO CT		4-23-79	
	158.0	148.79	9.2	17+96.8								
18+00	158.0	148.80	9.2						10330		5-28-81	
						18+60.3	3375		ALAMO CT			
19+00	158.0	149.00	9.0									
	158.0	149.07	8.9						10326		10-29-93	
	158.0	149.17	8.8	19+35.1					ALAMO CT			
20+00	158.0	149.30	8.7									
	158.0	149.47	8.5	20+84.8		4" STUB SE	93 223627		10322		4-9-80	
							80040		ALAMO CT			
LINE 2A												
0+00	156.0	146.82	9.2	0+00=3+14.6			94-193207		10206		12-5-99	
				LINE 2		+84.6	C74885		ALAMO CT		10-15-79	
1+00	155.0	147.02	8.0						1479		10-15-79	
	155.0	147.07	7.9	1+24.8		4" STUB NW	C70837		Valleyview		3-26-79	
									10210		5-12-79	
							C71806		ALAMO CT			
LINE 2B												
0+00	155.9	147.42	8.5	0+00=12+10.3								
				LINE 2								
1+00	156.0	147.62	8.3			1+40.4			10246		8-7-79	
	156.0	147.74	8.3						ALAMO			
	156.0	147.84	8.2	1+62.2								
2+00	156.4	147.92	8.5			2+08.1			10242		10-12-79	
						2+64.7	C74833		ALAMO		4-16-79	
3+00	157.0	148.12	8.9			3+31.2	C71266		10314		8-7-79	
	157.0	148.20	8.8	3+37.5		4" STUB NW	C73428		ALAMO CT		6-11-80	
						4" STUB NE	4546		10234		9-9-80	
							1173		ALAMO CT			
LINE 2C												
0+00	157.0	147.64	9.4	0+00=13+17.8					10306		6-14-77	
				LINE 2		10+31	C72358		ALAMO CT		5-17-79	
	158.0	147.81	10.2	20+86.4		4" STUB N	C71807		10310			
									ALAMO CT			
LINE 3												
0+00	154.0	147.45	6.6	0+00=					1505		5-2-79	
				EXISTING					1489		5-10-79	
1+00	154.0	147.65	6.4			10+49.9	C71586		Valleyview		5-10-79	
	155.0	147.85	7.2			10+90.3	C71683		1509			
	155.0	147.95	7.1	1+98.2		4" STUB W	C71692		10214		6-13-79	
									ALAMO CT			
2+00	155.0	147.95	7.1			2+46.1			10218		10-2-79	
						2+90.8	C71599		ALAMO CT		5-10-79	
3+00	155.5	148.15	7.4			3+56.8	C71845		10222		5-18-79	
									ALAMO CT			
4+00	156.5	148.35	8.5	4+22.9					10226		8-6-79	
	157.0	148.53	8.4	4+89.9			C73428		ALAMO CT			
5+00	157.0	148.65	8.4									
6+00	157.5	148.85	8.7						10230		7-6-79	
	157.5	148.86	8.6	6+03.4		4" STUB W	C72798		ALAMO CT			

1509 Valleyview Ct has 2 connections to same house