


SCALE 1"=200'

MAIN 19 WAR INDUSTRIES SEWER  
 BUILT BY: MID STATES CONST. CO.  
 PROJ. NO DBKM 574055  
 BOOKED 7-30-76 FROM 1H-65

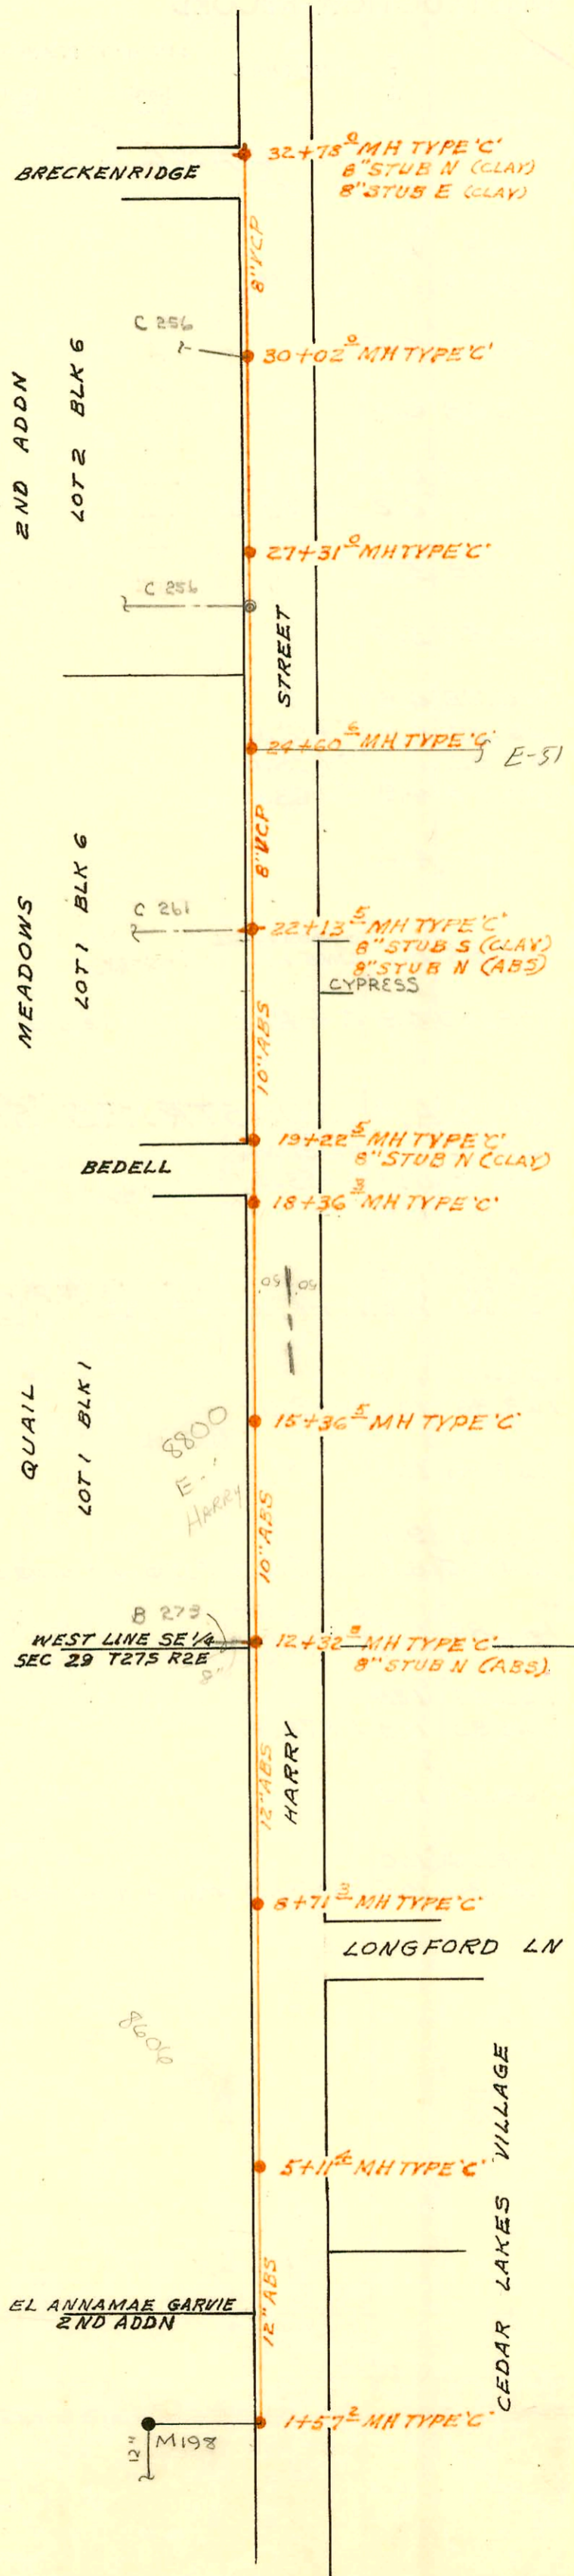

EL ANNAMAE GARVIE  
 2ND ADDN  
 12" M198

QUAIL  
 LOT 1 BLK 1  
 8800  
 E. Harry

MEADOWS  
 LOT 1 BLK 6  
 C 261

END ADDN  
 LOT 2 BLK 6  
 C 256

CEDAR LAKES VILLAGE

LONGFORD LN

HARRY

10" ABS

10" ABS

8" VCP

STREET

8" VCP

BRECKENRIDGE

