

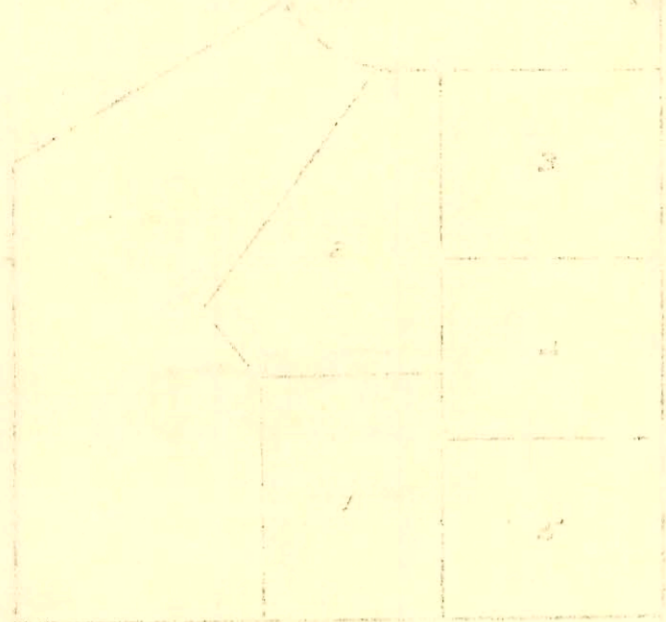


RELOCATION OF MAIN A SAN SEWER #1
BETWEEN WICHITA & MAIN-2ND TO 3RD
BUILT BY: MID STATES CONST. CO.
PROJ. NO DBKW 704018
BOOKED 8-13-76 FROM JK #4

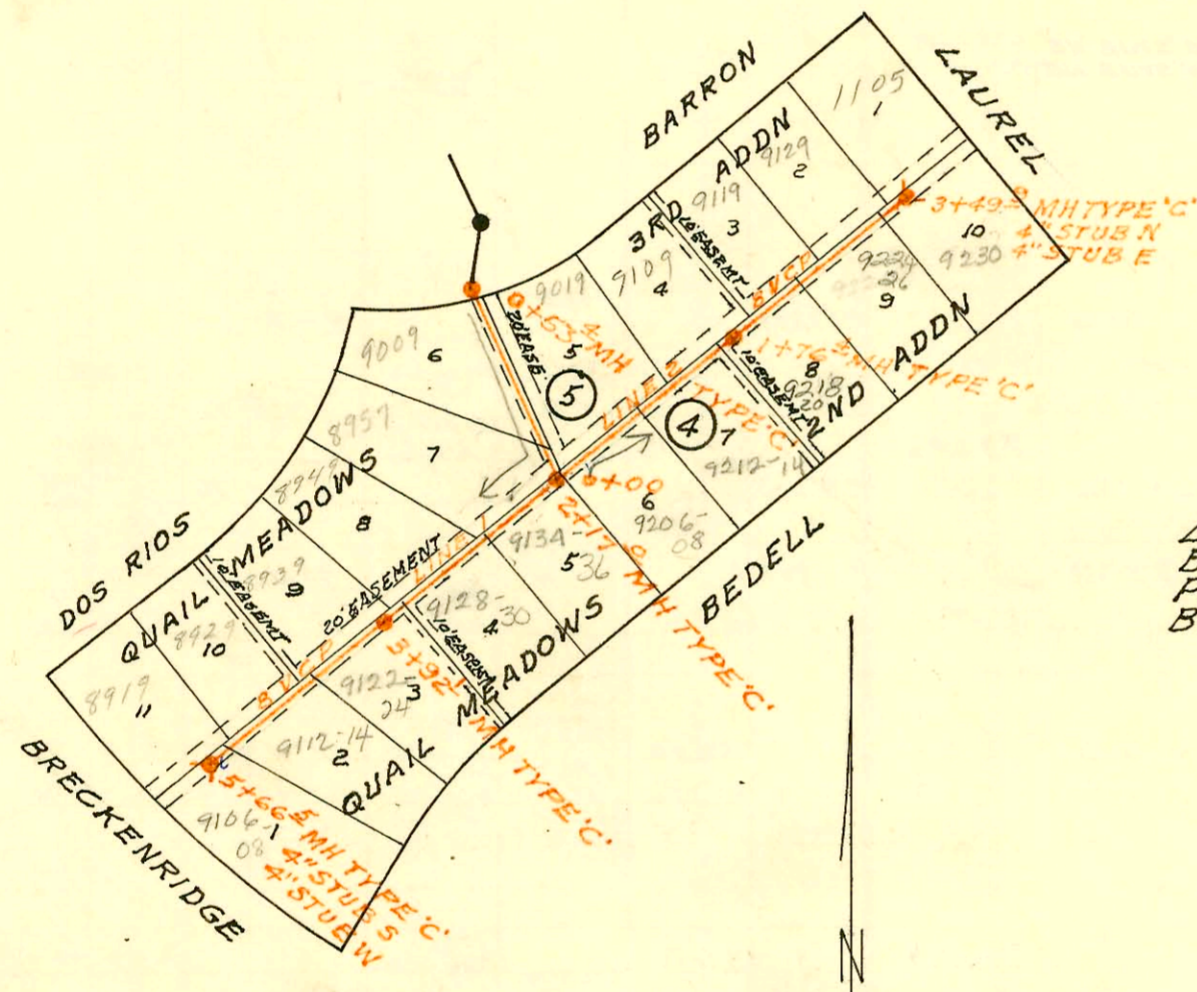

SCALE 1"=150'

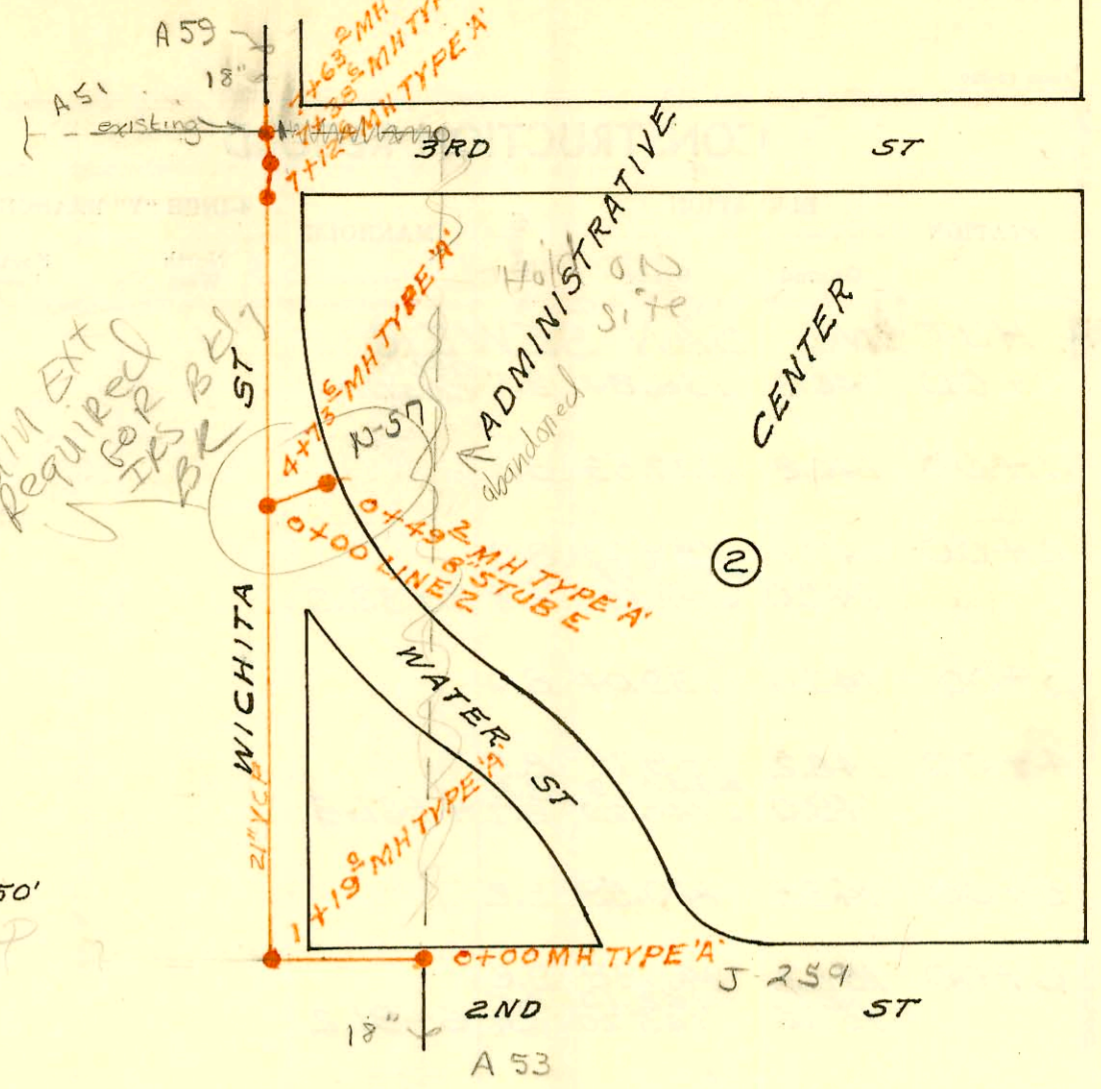

SCALE 1"=150'

LATERAL 9 MAIN 18 WAR INDUSTRIES SEWER
BUILT BY: WOODSIDE CONST. CO.
PROJ. NO DBKL 574078
BOOKED 8-18-76 FROM 261-Y

CONSTRUCTION RECORD

SERVICE RECORD

STATION	ELEVATION		Depth	MANHOLE	4-INCH "Y" BRANCHES		No. of Permit		House Number		DATE OF PERMITS	
	Ground	Grade			North West	South East	North West	South East	North West	South East	North West	South East
RELOCATION OF MAIN A SAN SEWER #1												
LINE 1 0+00	113.0	106.27	6.7	0+00								
1+00	112.8	106.37	6.4									
	114.5	106.39	8.1	1+19.0								
2+00	113.0	106.47	6.5									
3+00	113.0	106.58	6.4									
4+00	113.0	106.68	6.3									
	112.9	106.75	6.2	4+73.6								
5+00	112.7	106.78	5.9									
6+00	112.3	106.88	5.4									
7+00	111.8	106.98	4.8									
	111.8	106.99	4.8	7+12.6								
		107.02		7+38.6								
	111.9	107.04	4.9	7+63.0								
7+83	111.7	107.07	4.6									
LINE 2												
0+00	112.9	107.83	5.1	0+00=4+73.6 LINE 1								
	112.8	108.00	4.8	0+49.2		8" STUB E						
LATERAL 9 MAIN 18 WAR INDUSTRIES SEWER												
LINE 1 0+00	173.3	162.20	11.1	0+00 EXISTING								
	173.5	162.41	11.1	0+53.4								
1+00	173.9	162.53	11.4									
2+00	174.2	162.78	11.4		1+30.4	1+48	C59808	C59807	9009 Barron 8957 See Rice	9019 Barron	2-8-77	2-10-77
	174.5	162.94	11.6	2+17.0	2+79.0		C59809			9124-36 Bedell	2-8-77	
								C69101		9128-30 Bedell		10-26-78
3+00	174.2	163.13	11.1					C69099		9128-30 Bedell		10-26-78
	173.7	163.36	10.3	3+92.1	3+46.1		C6062		8949 See Rice	9122-24 Bedell	2-24-77	
					4+16.1	4+02.7	C6063	C69100	8959 See Rice	9122-24 Bedell	2-24-77	10-26-78
4+00	173.7	163.38	10.3									
5+00	173.2	163.78	9.4		5+03.0	5+39.2	C60503	C69098	8929 See Rice	9112-14 Bedell	3-23-77	10-26-78
	172.9	164.05	8.9	5+66.5	4" STUB W	4" STUB S	C60504	C69097	8919 See Rice	9106-08 Bedell	3-23-77	10-26-78
LINE 2												
0+00	174.5	162.84	11.7	0+00=2+17 LINE 1				C69102		9206-08 Bedell		10-26-78
1+00	175.9	163.44	12.5		1+49.8		C58838	1209	9109 Barron	9212-14 Bedell	11-24-76	9-12-80
	175.2	163.89	11.3	1+76.4								
2+00	175.3	164.04	11.3					2789	9119 Barron	9218-20 Bedell	4-12-79	3-10-81
					2+90.0		C71214					
3+00	175.6	164.64	11.0					2790	9119 Barron	9224-26 Bedell		3-9-81
	175.5	164.94	10.6	3+49.9	4" STUB N	4" STUB E	C58126	72895	1105 Lavel	9233-0 Bedell	10-12-76	7-11-79