


See Book I-54
 M.H. 8974 b3.9
 on 8915+17 S.
 Douglas

Privately maintained Line by
 PIZZA HUT SAN SEWER PIZZA HUT
 BUILT BY: UTILITY CONTR. INC. CORP
 PROJ. N^o DBKW 706013
 BOOKED 8-19-76 FROM SRL-5

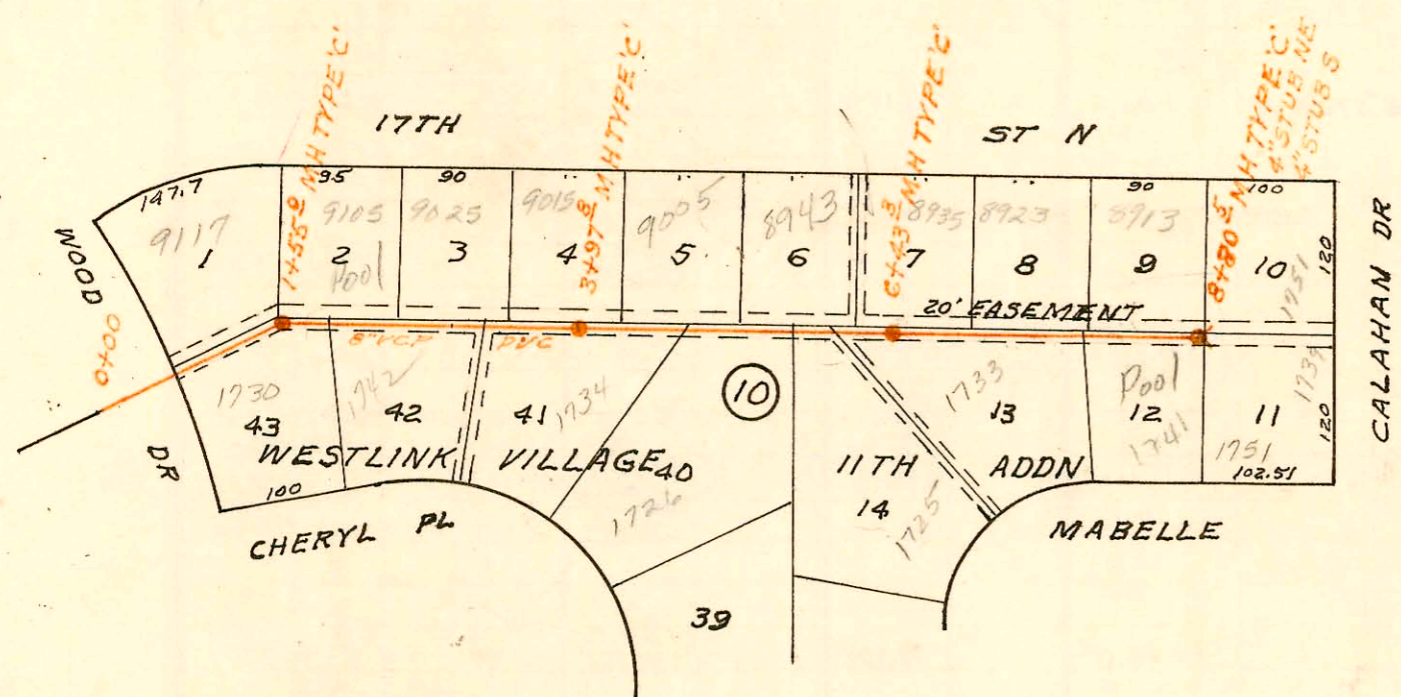

LATERAL 7 MAIN 3 WESTLINK
 BUILT BY: WB CARTER
 PROJ. N^o DBKL 574031
 BOOKED 8-24-76 FROM CLG 05
 on map

CONSTRUCTION RECORD

SERVICE RECORD

STATION	ELEVATION		Depth	MANHOLE	4-INCH "Y" BRANCHES		No. of Permit		House Number		DATE OF PERMITS	
	Ground	Grade			North West	South East	North West	South East	North West	South East	North West	South East
PIZZA HUT INC. SAN SEWER												
0+00	146.3	136.84	9.5	EXISTING								
1+00	146.8	137.53	9.3									
2+00	147.1	138.23	8.9									
	147.0	138.45	8.6									
		138.55	8.5	2+32.0								
3+00	147.0	139.04	8.0									
4+00	148.2	139.75	8.5									
	149.0	140.19	8.2									
		140.29	8.7	4+61.8								
5+00	149.8	140.59	9.2									
6+00	151.2	141.38	9.8									
	151.6	142.10	9.5									
		145.20	6.4	6+91.2								
7+00	151.6	145.35	6.3									
8+00	156.0	147.04	9.0									
9+00	158.5	148.73	9.8									
10+00	159.2	150.42	8.8									
	159.3	150.91	8.4	10+29.3	8" STUB NE 4" STUB NE	6" P.V. 4D 6" MH tap		C66609		9111 E. 30 Sauger		5-26-78
LATERAL 7 MAIN 3 WESTLINK												
0+00	159.5	149.67	9.8									
1+00	160.5	149.94	10.6		1+35.6			C57291	9117 W. 17th	1730		8-20-76
	160.7	150.09	10.6		1+55.0	1+48.1		C58770	9105 W. 17th	1742	1730 Wood Cr.	11-22-76
		150.19	10.5					C56769	9025 W. 17th	1742	Cheryl	7-19-76
2+00	161.3	150.92	10.4		2+98.6	2+69.5		C60604	9015 W. 17th	1734	Cheryl	4-4-77
3+00	162.8	152.53	10.3		3+97.8	3+60		C57292	9015 W. 17th	1734	Cheryl	8-20-76
	164.6	154.11	10.5					C56867	9015 W. 17th	1734	Cheryl	7-23-76
								C61147				5-16-77
4+00	164.7	154.14	10.6									
5+00	167.8	155.73	12.1		4+68.3	4+31.4		58265	9005 W. 17th	1726	Cheryl Pl.	10-20-76
					5+51.4	5+70		58264	8943 W. 17th	1726	Cheryl Pl.	10-20-76
					6+31.1			60191	8935 W. 17th	1726	Cheryl Pl.	3-4-76
6+00	167.7	157.31	10.4		6+43.3							
	167.7	158.00	9.7									
7+00	168.1	158.91	9.2		7+57.3	7+23.4		C59626	8923 W. 17th	1733	Maybelle	1-27-77
					8+46.2	8+33.0		C61708	8913 W. 17th	1741	Maybelle	6-22-77
8+00	170.0	160.50	9.5		8+80.5	4" STUB NE	4" STUB S	C60349	8913 W. 17th	1751	Callahan	12-29-77
	171.3	161.79	9.5					C63111	8913 W. 17th	1751	Callahan	3-11-77
												9-19-77
LATERAL 4 MAIN 2 SOUTHWEST INTERCEPTOR												
LINE 1 0+00	86.9	74.07	12.2	EXISTING								
1+17	84.4	74.24	10.2									
	84.7	74.54	10.2	1+25.0								
	84.8	74.56	10.2	1+45.0				9559697		4712 E. 50 4713 S		4-26-95
2+00	85.2	74.61	10.6		2+48.9	no meas - 01 Sept Tank		C6007	4734 S main	4714 E. 50 4715 S		2-24-77
								859687				4-26-95
3+00	85.6	74.72	10.6		3+59.8			C57236	4724 S main			8-16-76
4+00	86.1	74.84	11.3		4+35.0			C61058	4714 S main			5-6-77
	86.2	74.92	11.3	4+53.2								
5+00	85.6	75.02	10.6		5+81.9			95-12407	4704 S main	4747 S Broadway		8-11-75
6+00	85.7	75.17	10.5		6+33.8			6991	4638 main	4747 S Broadway		11-30-99
								99-01349	75-12405-7			8-11-95
7+00	86.3	75.32	11.0		7+31.8	MH tap		C60262	4634 S main			5-8-78
	86.4	75.36	11.0									

(CONTINUED ON NEXT PAGE)