

B262A

SCALE 1"=150'

NOTE
City must
make taps to
Abs - will not
charge until
further notice
12/20/01

4744 S Main
Rec'd inquiry
from Bammes about
May 1998 about
taking off sp
& cover for
Sewer
does not
pay
wants
D.L. to
to sewer
line for
Main
5/27/08

LATERAL 4 MAIN 2 SOUTHWEST INTERCEP
BUILT BY: WOODSIDE CONST. CO.
PROJ. NO DBKL 570013
BOOKED 9-1-76 FROM SS #11 JAK

4635 S Broadway - O'Reilly Auto
Refer to copy of Deed to previous owner
Wilma Matney from J. George granting her
full rights to lot and existing improvements
which incl the sewer Conn done in 1979.
Property was sold to O'Reilly Auto Parts incl.
the improvements. Attorney for O'Reilly's
says the rights to city sewer go with
the parcel of land purchased by O'Reilly.
10/31/96

Working on Septic
by Olson 10/27/07

11/13/01
8/19

4735
4757


CONSTRUCTION RECORD

SERVICE RECORD

| STATION | ELEVATION | | Depth | MANHOLE | 4-INCH "Y" BRANCHES | | No. of Permit | | House Number | | DATE OF PERMITS | |
|--|-----------|-------------------|--------------|-----------------------|--------------------------------|------------------------------|-------------------------|------------------------|---|--------------------------------------|--------------------|--------------------|
| | Ground | Grade | | | North West | South East | North West | South East | North West | South East | North West | South East |
| LATERAL 4 MAIN 2 SOUTHWEST INTERCEPTOR (CONTINUED FROM B261) | | | | | | | | | | | | |
| LINE 1 8+00 | 86.6 | 75.47 | 11.1 | | 8+85.1 | | 260392 | 2054 25253 25254 | 4624 main | 4605 Broadway 4605 Broadway | 3-16-77 | 1-29-84 1-29-84 |
| 9+00 | 86.4 | 75.62 | 10.8 | | 9+21 | | 256793 | | 4604 S. main | | 7-16-76 | |
| 10+00 | 86.0 | 75.77 | 10.2 | | | | | | | | | |
| | 86.0 | 75.77 | 10.2 | 10+03.5 | 4" PVC 40 10+15.5 TAP | | 95205177 | | 4614 NK MAIN | | 12-15-95 | |
| 11+00 | 86.0 | 75.92 | 10.1 | | | | | | | | | |
| 12+00 | 86.6 | 76.07 | 10.5 | | | | | | | | | |
| | 86.6 | 76.07 | 10.5 | 12+03.0 | | | | | | | | |
| 13+00 | 87.3 | 76.22 | 11.1 | | | | | | | | | |
| 14+00 | 86.6 | 76.37 | 10.2 | | | | | | | | | |
| | 86.5 | 76.38 IN 76.48 | 10.7 10.0 | 14+10.3 | TAP | | | | | | | |
| 15+00 | 86.7 | 76.62 | 10.1 | | 15+27.3 TAP | | 4051 | | 161 Shadydale | | 9-2-81 | |
| 16+00 | 86.4 | 76.77 | 9.6 | | | | | | | | | |
| 17+00 | 85.9 | 76.92 | 9.0 | | | | | | | | | |
| | 85.8 | 76.95 IN 77.05 | 8.9 8.8 | 17+21.0 | | | | | | | | |
| 18+00 | 85.3 | 77.17 | 8.1 | | | | | | | | | |
| | | | | | 18+63 TAP | | 13299 | | 4536 S. Mt. | | 3-18-85 | |
| 19+00 | 84.6 | 77.32 | 7.3 | | | | | | | | | |
| | 84.6 | 77.32 | 7.3 | 19+01.0 | | | | | | | | |
| 20+00 | 85.0 | 77.47 | 7.5 | | | | | | | | | |
| | 85.1 | 77.54 | 7.6 | 20+48.5 | | | | | | | | |
| 21+00 | 85.0 | 77.62 | 7.4 | | | | | | | | | |
| 22+00 | 84.5 | 77.77 | 6.7 | | | | | | | | | |
| | 83.9 | 77.82 | 6.1 | 22+39.8 | 18+31.8 TAP | | 466760 | | 220 E 44th St. | | 6-9-78 | |
| 23+00 | 84.0 | 77.92 | 6.1 | | | | | | | | | |
| | 84.2 | 78.05 | 6.2 | 23+91.7 | 8" STUB N 23+69.6 TAP | | 61892 | | 4489 S. Broadway | | 6/30/77 | |
| 24+00 | 84.3 | 78.22 | 6.1 | | | | | | | | | |
| 25+00 | 84.6 | 78.44 | 6.2 | | | | | | | | | |
| | | | | | | | 50291 | | 2005 44th St. | | 10-2-76 | |
| 26+00 | 85.5 | 78.66 | 6.8 | | | | | | | | | |
| | 85.6 | 78.67 | 6.9 | 26+05.2 | 4" SOR 35 26+27.2 TAP | | 91-18915-7 | | 160 E 44th St. | | 3-7-71 | |
| 27+00 | 86.5 | 78.85 | 7.7 | | 4" SCH 40 27+16.2 | | 2002- 03499 #3503 | | N/C 150 E 44th St. tied to exist 270W CO 6-4-CMF | | 6-16-81 | |
| | | | | | 27+16.8 TAP | | 28241 | | 150 E 44th St. | | 10-19-76 | |
| 28+00 | 87.5 | 79.05 | 8.5 | | | | | | | | | |
| 29+00 | 88.2 | 79.25 | 9.0 | | | | | | | | | |
| | 88.2 | 79.26 | 8.9 | 29+05.3 | 28+96.8 TAP | | 657029 | | 130 E 44th St. | | 8-3-76 | |
| 30+00 | 86.5 | 79.45 | 7.1 | | | | | | | | | |
| | | | | | 28+34.3 TAP | | 657591 | | 130 E 44th St. | | 9-2-76 | |
| 31+00 | 87.7 | 79.65 | 8.1 | | | | | | | | | |
| | 88.0 | 79.79 | 8.2 | 31+74.0 | 30+70.6 TAP 4" STUB S | | 657590 657588 | | 117 E 100 E 44th St. | | 9-8-76 9-2-76 | |
| LINE 2 0+00 | 86.4 | 77.20 | 9.2 | 0+00=7+31.8 LINE 1 | | | | | | | | |
| 1+00 | 86.2 | 77.60 | 8.6 | | City Tap 6" Predco Donut | 4" Predco Saddle w/ 1" 12 | 2004- 00254 | | 4605 Broadway | | 1/29/04 | |
| 2+00 | 85.8 | 78.00 | 7.8 | | | | | | | | | |
| | 86.0 | 78.10 | 7.9 | 2+25.5 | | | | | | | | |
| 3+00 | 86.5 | 78.40 | 8.1 | | | | | | | | | |
| 4+00 | 87.5 | 78.80 | 8.7 | | | | | | | | | |
| | 86.4 | 79.00 | 7.4 | 4+49.2 | 4" STUB N | | 96-5574-7 671680 | | 4635 250 Broadway | | 4-22-76 5-10-79 | |

abandoned siph tank found 4743 S. main * 92-9693-17 4-22-92 (4" PVC 40 4" city tap into new 21' section of line replaced by city)

96-21504-7 4635 S. Broadway 12-12-96 Tied into 4" ABS stub at 4+49.2, 4" PVC 40

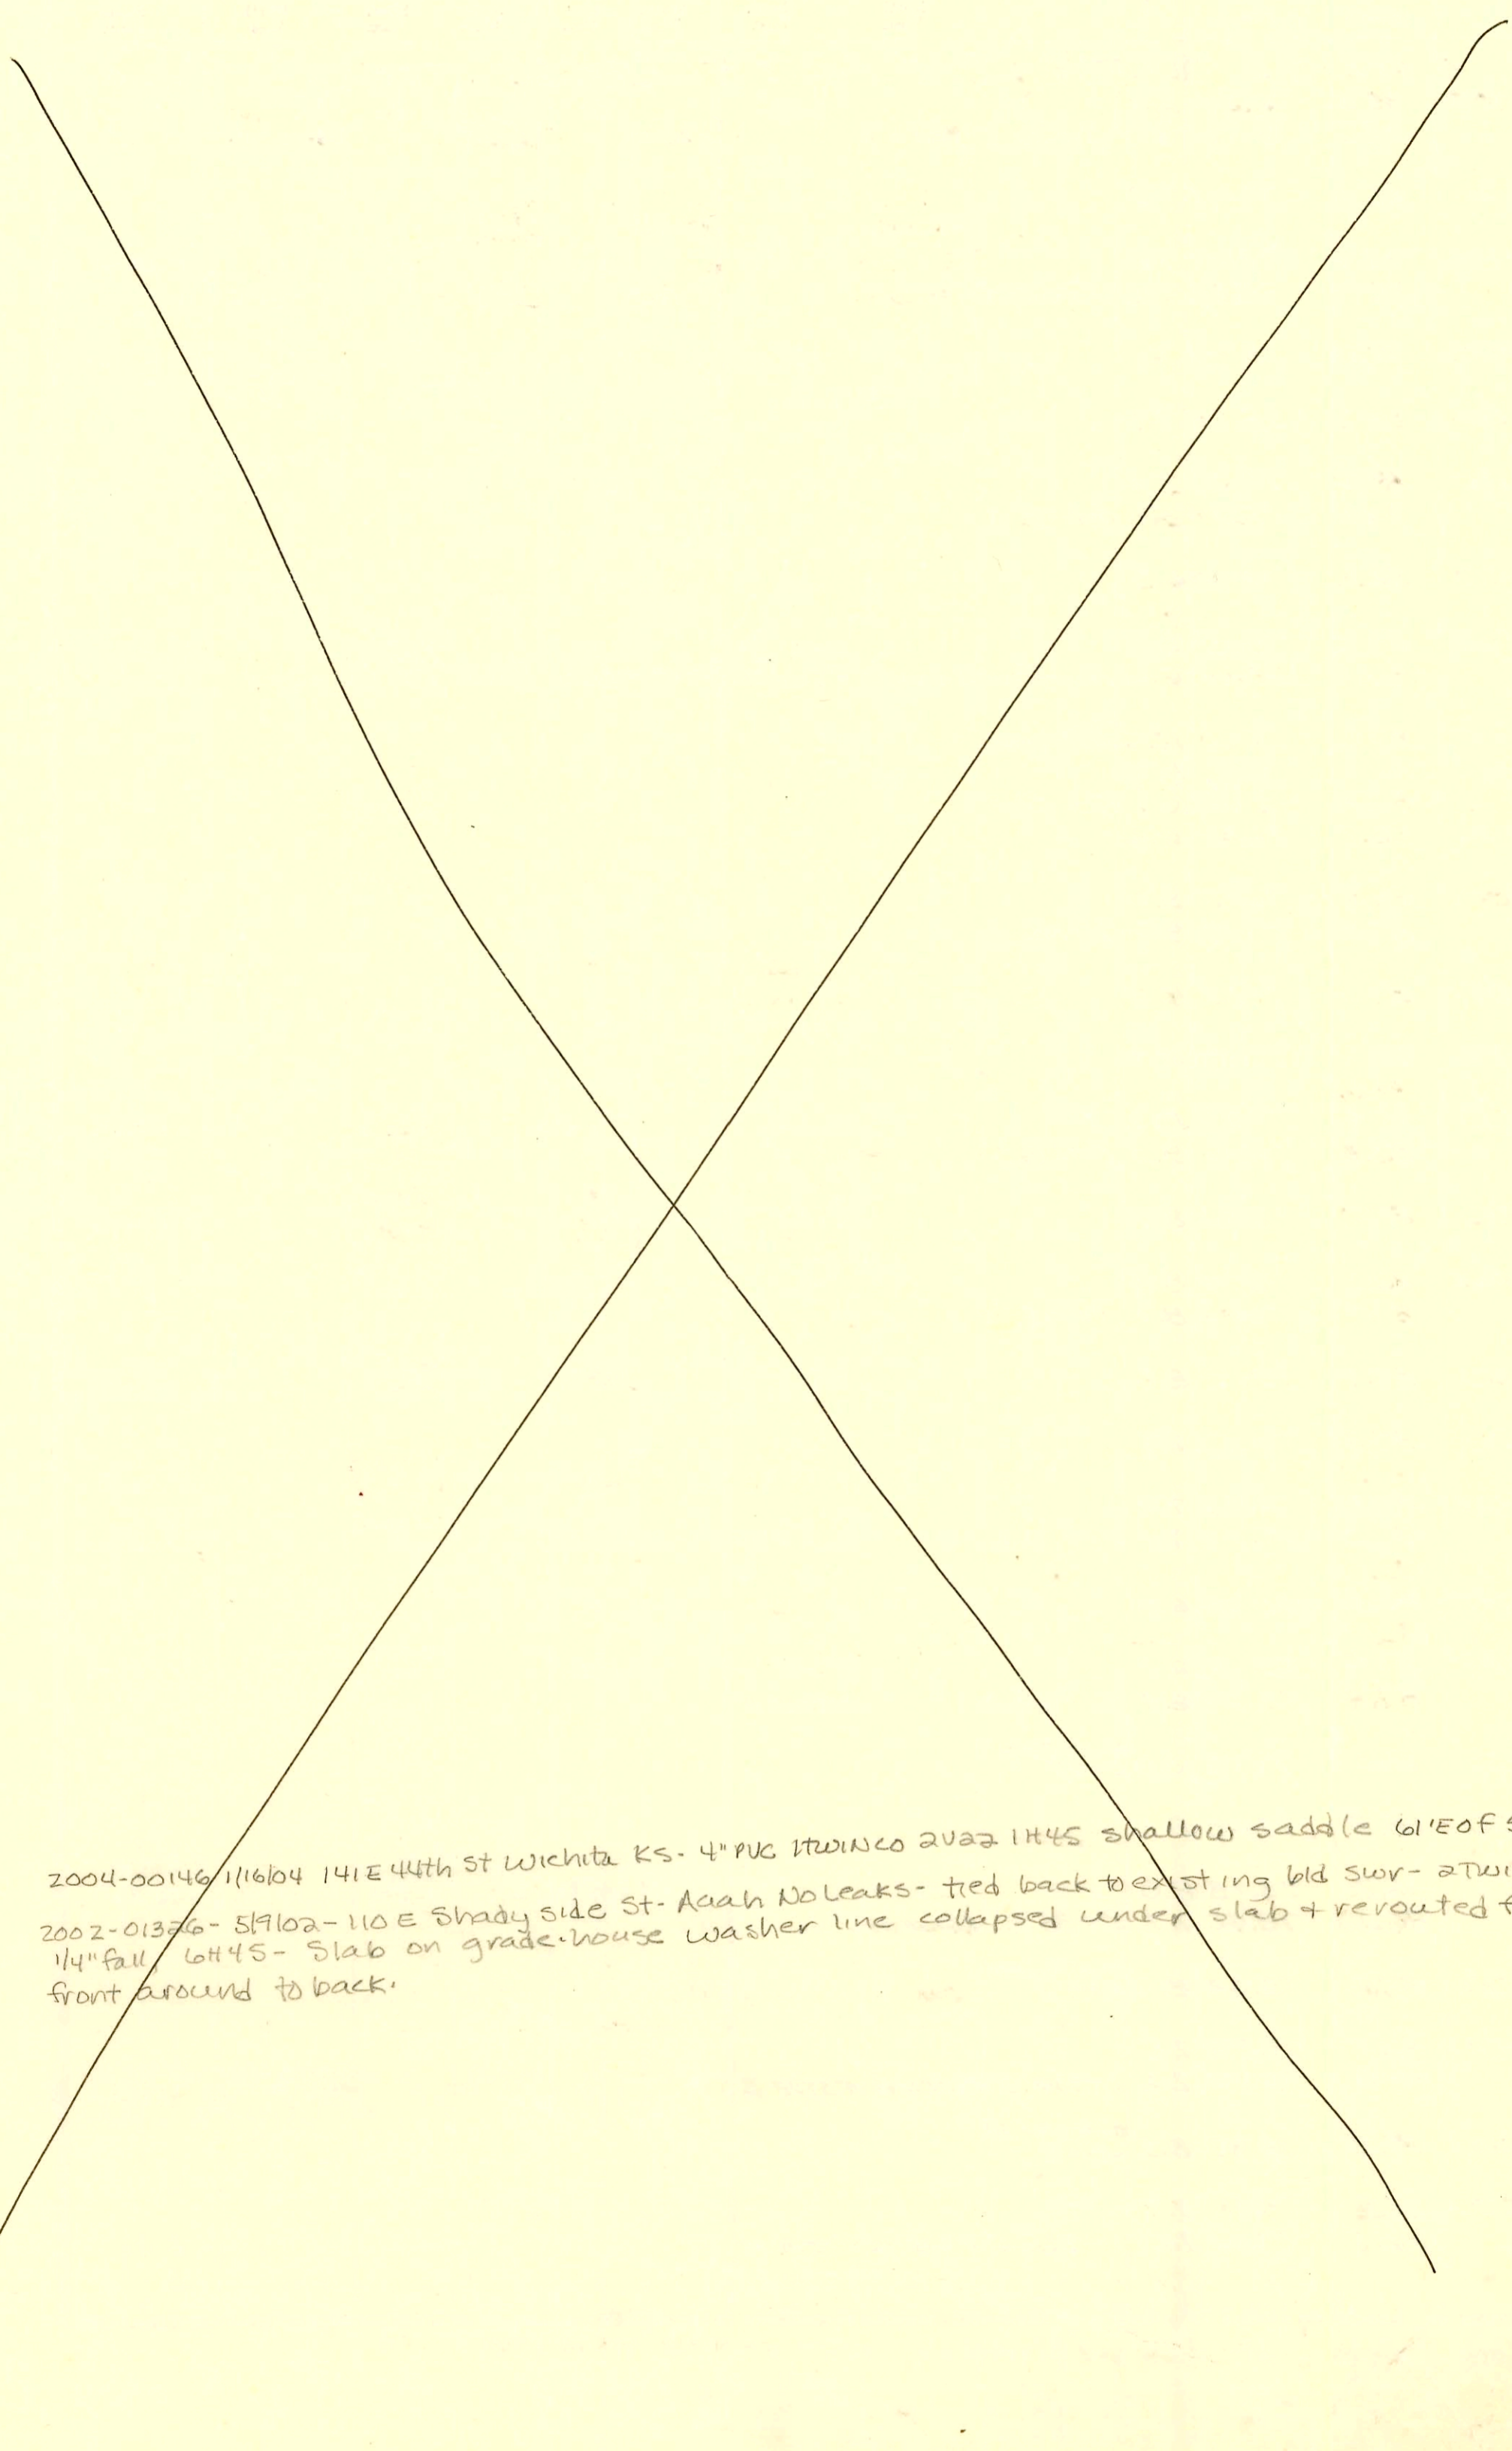

2004-00146 1/16/04 141 E 44th St Wichita KS - 4" PVC ITWINCO 2022 1H45 shallow saddle 61' E of 5100 (4137)
2002-01376-51902-110 E Shady side St. Aaah NO leaks - tied back to existing bld swr - 2TWINCO -
1/4" fall 6H45 - Slab on grade house washer line collapsed under slab + rerouted from
front around to back.

CONSTRUCTION RECORD

SERVICE RECORD


| STATION | ELEVATION | | Depth | MANHOLE | 4-INCH "Y" BRANCHES | | No. of Permit | | House Number | | DATE OF PERMITS | |
|--|-----------|-------------------------|-------------------|------------------------|--|------------------------------|----------------------------|--|---|--------------------------------|-------------------------------|------------|
| | Ground | Grade | | | North West | South East | North West | South East | North West | South East | North West | South East |
| LATERAL 4 MAIN 2 SOUTHWEST INTERCEPTOR (CONT.) | | | | | | | | | | | | |
| LINE 3 0+00 | 86.5 | 76.65 | 9.9 | 0+00=14+10.3 LINE 1 | 0+13.1 | 0+70.4 | 58239 | 275585 | 151 R Shadyside | 114 E. 45 S | 1-24-2050 | 12-3-79 |
| 1+00 | 88.4 | 76.90 | 11.5 | | | | | | | | | |
| 2+00 | 86.8 | 77.15 | 9.7 | 2+00.4 | 1+38.6 2+19.8 2+71.5 | | 258290 257730 287 | 141 Shadyside 131 R Shadyside 121 Shadyside | | 10-21-76 9-23-76 5-12-80 | | |
| 3+00 | 86.7 | 77.40 | 9.3 | | | | | | | | | |
| 4+00 | 87.2 | 77.65 77.75 | 9.6 9.5 | 3+99.5 | | | | | | | | |
| 5+00 | 87.0 | 78.00 | 9.0 | | | | | | | | | |
| 6+00 | 86.9 | 78.25 78.28 | 8.7 8.6 | 6+15.0 | | | | | | | | |
| 7+00 | 86.8 | 78.50 78.76 | 8.3 9.0 | 7+86.0 | 6+73.3 | | 262396 | | 4535 L Main | | 8-3-77 | |
| 8+00 | 88.2 | 78.80 | 9.4 | | | | | | | | | |
| 9+00 | 88.0 | 79.10 | 8.9 | | | | | | | | | |
| 10+00 | 86.9 | 79.35 79.48 | 7.6 6.8 | 10+50.8 | | 4" SOR 35 10+08.3 top | 22006 | | 4515 S. Main | | 11-18-88 | |
| 11+00 | 85.5 | 79.60 | 5.9 | | | 10+64 1/2 | 268443 | | 4513 L Main | | 8-30-78 | |
| 12+00 | 83.7 | 79.85 80.00 | 3.9 3.7 | 12+52.5 | | TAP 11+55.5 4" STUB NE | 262282 257589 | | 4501 L Main 4515 S. Main | | 7-27-77 | |
| LINE 4 0+00 | 85.8 | 77.22 | 8.6 | 0+00=17+21.0 LINE 1 | | | | | | | | |
| | 85.5 | 77.40 77.50 | 8.1 8.0 | 0+90.2 | | MH top | 97-80547 256750 | | 4537 S/D Main | | 5-18-76 | |
| 1+00 | 85.4 | 77.52 | 7.7 | | | 1+72.6 1+77.9 2+72.0 | 256828 261746 256827 | | 4553 L S. Broadway 4553 Main 4555 L Broadway | | 7-21-76 6-27-77 7-21-76 | |
| 2+00 | 84.5 | 77.72 77.91 | 6.8 6.9 | 2+97.4 | | 6" STUB SE | | | | | | |
| 3+00 | 84.9 | 77.92 | 7.0 | | | | 264159 | | 4611 L Bluff | | 12-1-77 | |
| 4+00 | 84.8 | 78.12 78.16 | 6.7 6.6 | 4+18.8 | | 6" STUB S 6" STUB SE | 264157 264158 | | 4611 L Bluff | | 11-22-77 11-22-77 | |
| LINE 5 0+00 | 85.1 | 77.71 | 7.4 | 0+00=20+48.5 LINE 1 | | | | | | | | |
| 1+00 | 85.2 | 78.01 | 7.2 | | | 0+93.2 | 260039 | | 4526 S. Market | | 2-25-77 | |
| 2+00 | 84.8 | 78.31 78.46 78.56 | 6.5 6.3 6.4 | 2+50.7 | | | | | | | | |
| 3+00 | 85.2 | 78.71 | 6.5 | | | 3+10.7 | 258091 | | 151 S. 444 S. | | 10-8-76 | |
| 4+00 | 85.4 | 79.01 | 6.4 | | | | 200446 58240 | | 141 R 444 S. 131 E 444 S. | 1-16-04 10-19-76 | 10-22-76 | |
| | 84.4 | 79.31 | 5.1 | 5+00 | 4+40 4439 4+41.0 5+22.8 TAP 6+59.4 | 4+80.5 5+08.2 6+59.4 | 267389 257829 | | 131 E 444 S. 170 R Shadyside next | 7-17-78 | 10-19-76 10-23-76 | |
| 6+00 | 85.0 | 79.61 79.91 | 5.4 5.0 | 6+99.5 | 6+34.8 see below | 4" STUB N 4" STUB S | 1590 257587 | | 121 E 444 S. 4500 S. Main | 10-28-80 9-8-76 | 4-16-96 12-11-86 | |
| LINE 6 0+00 | 85.2 | 74.65 | 10.6 | 0+00 EXISTING | | | | | | | | |
| 0+87 | 85.5 | 74.81 | 10.7 | | | | | | | | | |
| 1+00 | 85.5 | 76.10 | 9.4 | 0+99.0 | | 1+70 | 258596 | | 124 W 4726 S. | | 11-10-76 | |
| 2+00 | 85.0 | 76.50 | 8.5 | | | 2+04.4 | 258349 | | 47345 Main | 10-26-76 | 7-14-93 3/4/77 | |

#92-36548-7 - 131 Shadyside - 9" x 12" - Replaced from house towards main w/ 4" SDR35
1/4" Fall tied onto clay tile 15'± off main. 76-9807 6-25-96 100 E Shadyside - Newcomer 4" ABS

73-185097 (7-14-93) 4733 S Main (Det'd Garage) 4" SDR35 Tied Garage Line to existing Bldg Sewer.

STATE BOARD

CONSTRUCTION RECORD

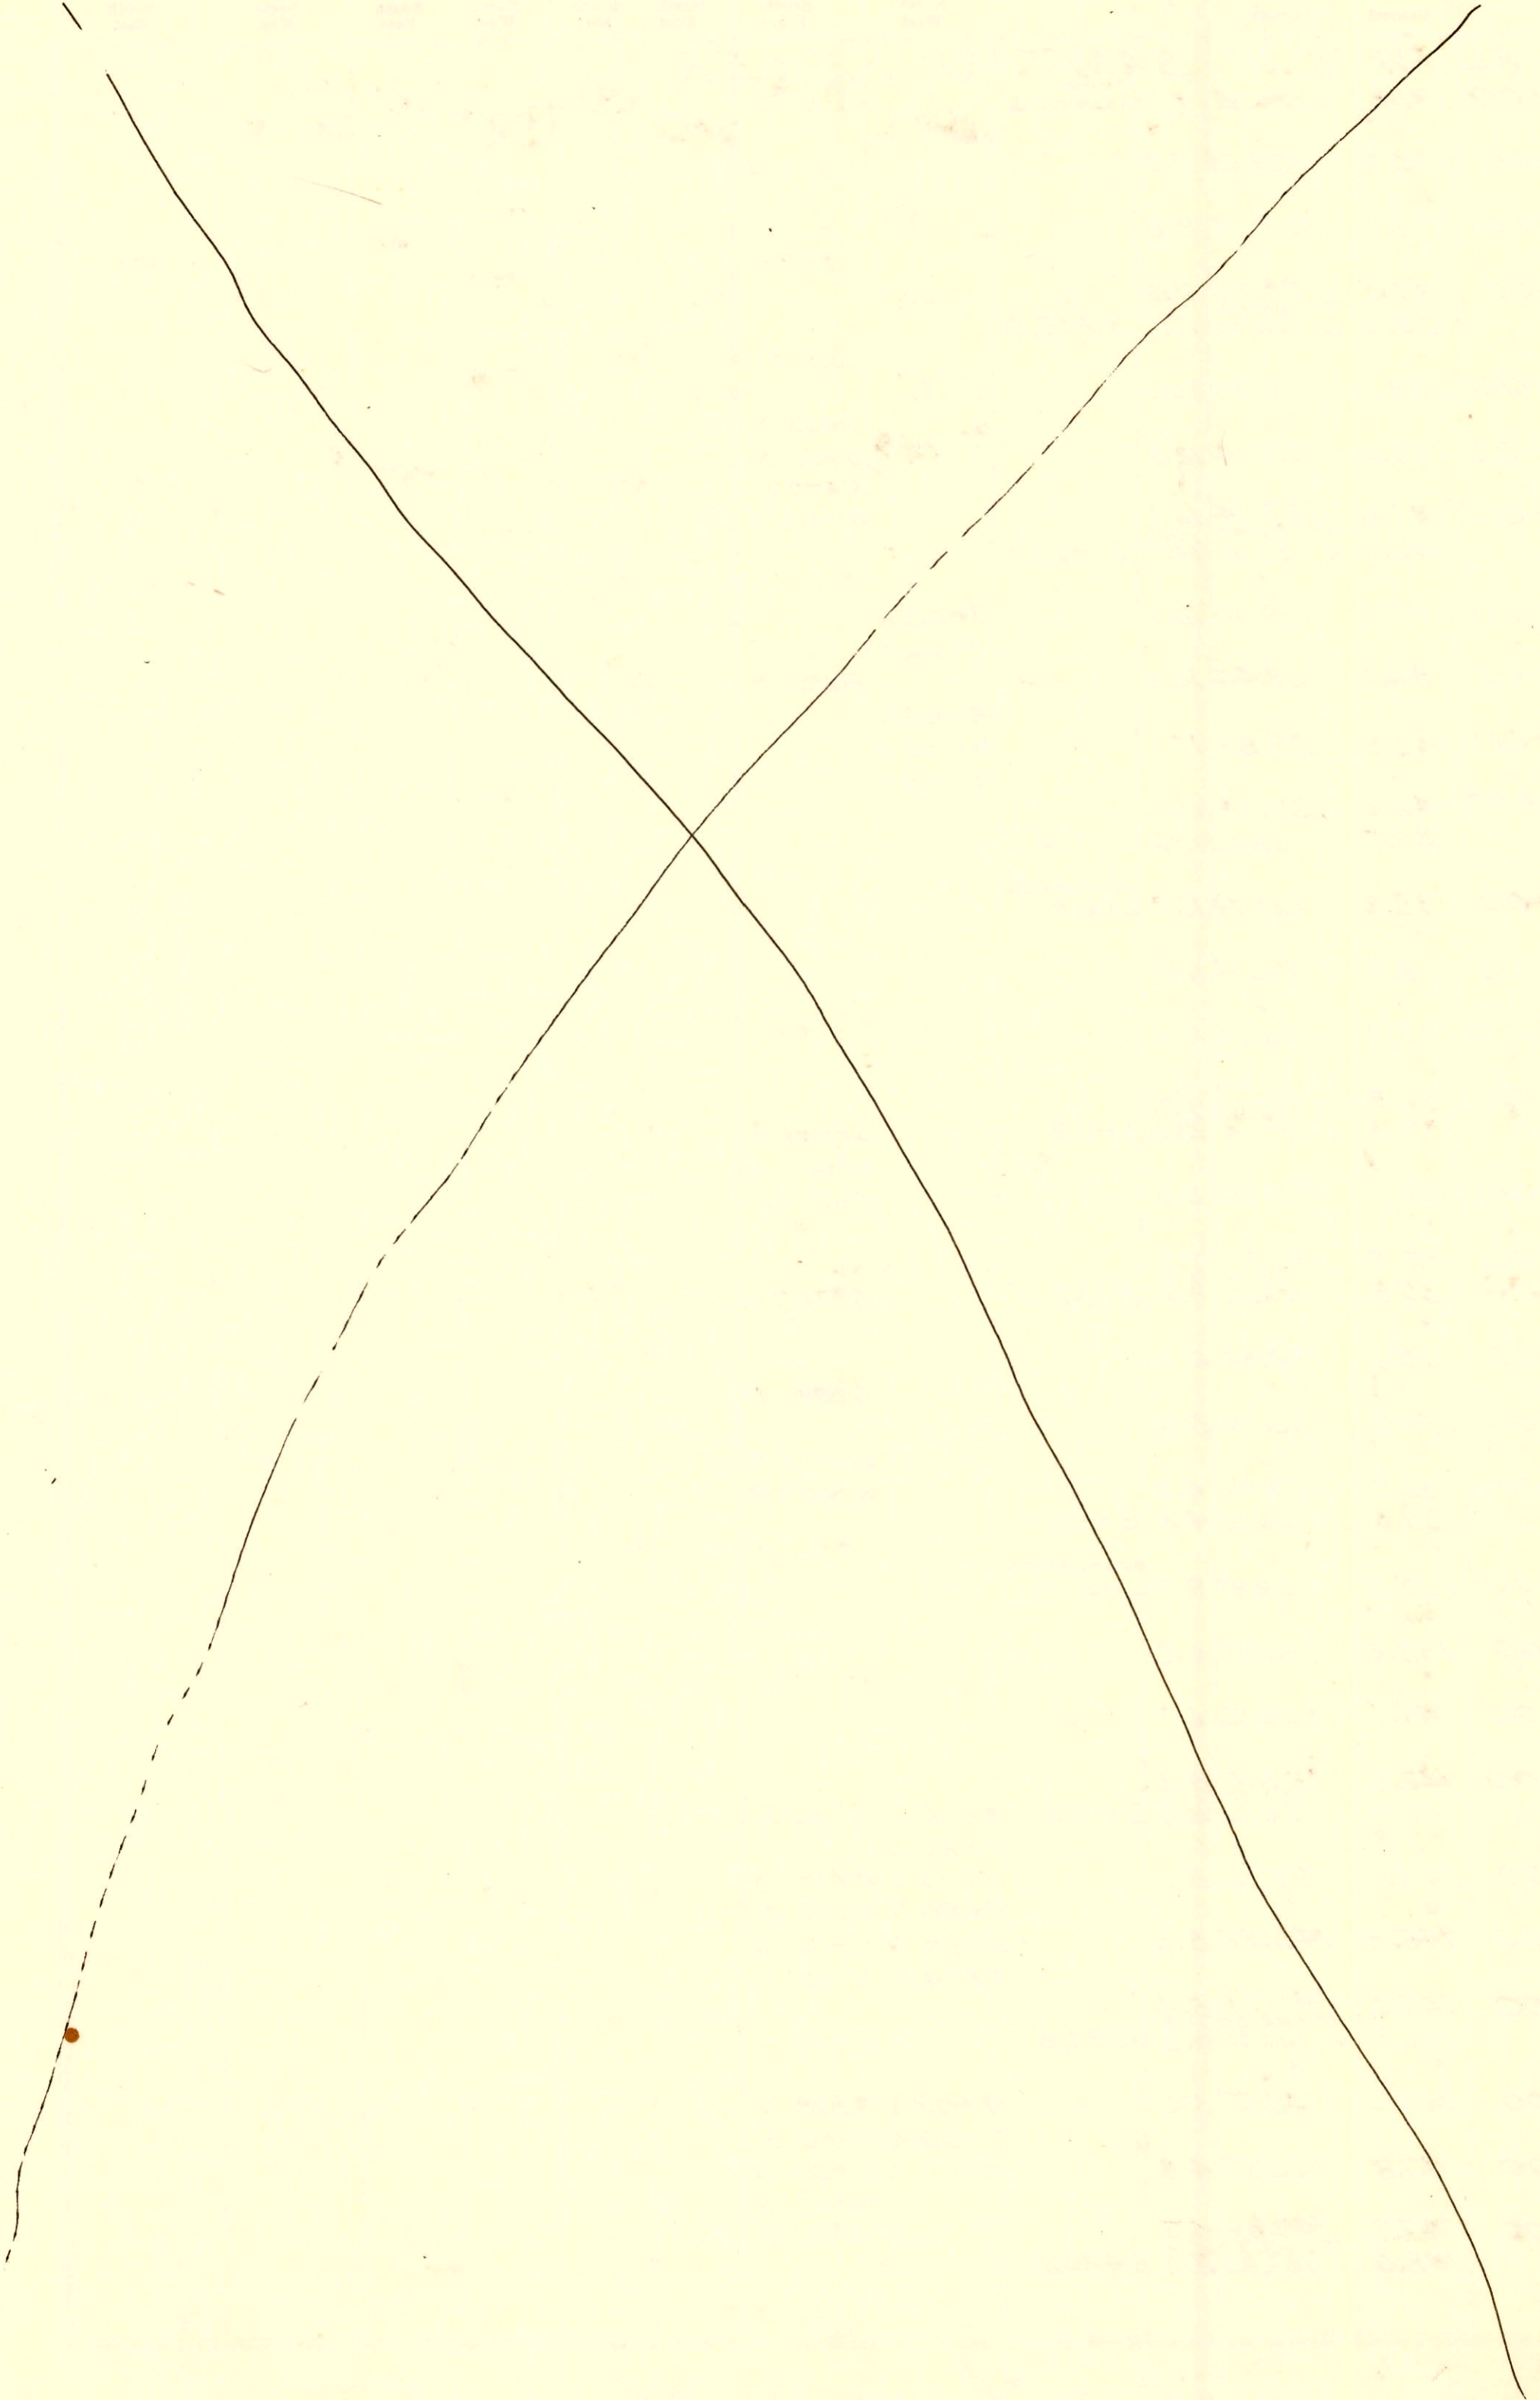

CONSTRUCTION RECORD

SERVICE RECORD

| STATION | ELEVATION | | Depth | MANHOLE | 4-INCH "Y" BRANCHES | | No. of Permit | | House Number | | DATE OF PERMITS | | | |
|--|-----------|--------------|-------------------------|-------------------|---------------------|-----------------------|------------------|------------------|--------------------------|--------------|-------------------------------|--------------------|------------|------------|
| | Ground | Grade | | | North West | South East | North West | South East | North West | South East | North West | South East | North West | South East |
| | | | | | | | | | | | | | | |
| LATERAL 4 MAIN 2 SOUTHWEST INTERCEPTOR (CONT) | | | | | | | | | | | | | | |
| LIN 6 CONT | 3+00 | 85.0 85.2 | 76.90 77.06 77.16 | 8.1 8.1 8.0 | 3+38.3 | 3+28.6 | 3+19 | C58942 C54654 | 49-0426 4724 S. Water | 4723 S. Main | see below | 12-9-99 12-2-76 | | |
| | 4+00 | 85.3 | 77.40 | 7.9 | | 4+49.1 | C58761 | | 4714 S. Water | 4725 S. Main | 11-19-76 | | | |
| | 5+00 | 85.4 85.4 | 77.80 78.20 | 7.6 7.2 | 5+73.5 | 5+67.5 5+61.8 | C54373 C54845 | | 4704 S. Water | | 4-12-76 | 3-23-76 | | |
| | 6+00 | 85.4 | 78.29 | 7.1 | | 6+58.0 | C54761 | C578 | 4640 S. Water | 4643 S. Main | 7-15-91 4-12-76 | 6-16-80 | | |
| | 7+00 | 85.7 | 78.65 | 7.1 | | 7+55.8 | C71817 | | 4634 S. Water | | 5-17-79 | | | |
| | 8+00 | 84.5 84.6 | 79.01 79.04 | 5.5 5.6 | 8+08.8 | 7+94.4 | C61174 | | 4624 S. Water | 4623 S. Main | 4-14-76 | 5-17-77 | | |
| | 9+00 | 86.2 | 79.40 | 6.8 | | 8+58.4 | C54819 | | 4620 S. Water | 4622 S. Main | 4-14-76 | 12-1-76 | | |
| | 10+00 | 86.2 86.3 | 79.80 80.00 | 6.4 6.3 | 10+49.0 | 10+01.0 | C68649 | C16875 C23822 | 207 W. 45th | 4613 S. Main | 9-29-78 | 8-22-86 8-30-89 | | |
| LIN 7 | 0+00 | 87.8 | 75.20 | 12.6 | 0+00 EXISTING | | | | | | | | | |
| | 0+60 | 87.7 | 75.32 | 12.4 | | | | | | | | | | |
| | 1+00 | 86.6 | 75.34 76.20 | 11.3 10.4 | 0+70.0 | | | | | | | | | |
| | 2+00 | 86.6 87.0 | 76.72 77.08 | 9.9 9.9 | 2+86.0 | | | | | | | | | |
| | 3+00 | 87.1 | 77.12 | 10.0 | | 3+44.5 | C68526 | | 4707 S. Water | | 9-25-78 | | | |
| | 4+00 | 87.7 | 77.52 | 10.2 | | | | | | | | | | |
| | 5+00 | 88.2 87.9 | 77.92 78.06 | 10.3 9.8 | 5+28.5 | 5+20.0 | C57878 | | 4705 S. Water | | 9-27-76 | | | |
| | 6+00 | 87.0 | 78.32 | 8.7 | | 6+36.1 | C57244 | | 4645 S. Water | | 8-17-76 | | | |
| | 7+00 | 86.7 87.7 | 78.72 79.04 | 8.0 8.7 | 7+73.6 | 7+02 | C72811 | | 4641 S. Water | | 7-6-79 | | | |
| | 8+00 | 87.7 | 79.12 | 8.6 | | 8+11.6 | 14994 | | 4631 Water | | 11-6-85 | | | |
| | 9+00 | 87.4 | 79.52 | 7.9 | | | | | | | | | | |
| | 10+00 | 87.3 87.1 | 79.92 80.02 | 7.4 7.1 | 10+18.6 | 9+56.3 | C66882 | | 4621 S. Water | | 6-16-78 | | | |
| | 11+00 | 86.9 | 80.32 | 6.6 | | 10+01.6 | C56688 | | 4607 S. Water | | 7-13-76 | | | |
| | 12+00 | 87.4 87.4 | 80.72 81.00 | 6.7 6.4 | 12+65.0 | 12+28.6 | C56686 | | 4601 S. Water | | 7-13-76 | | | |
| LIN 8 | 0+00 | 87.2 | 77.18 | 10.0 | 0+00=2+86.0 LINE 7 | | | | | | | | | |
| | 1+00 | 85.8 | 77.68 | 8.1 | | | | | | | | | | |
| | 2+00 | 86.2 86.1 | 78.18 78.40 | 8.0 7.7 | 2+35.5 | 2+05.9 | C56891 | | 316 W. 45th S. Water | | 9-21-82 5-12-76 | | | |
| LIN 9 | 0+00 | 87.2 | 78.48 | 8.7 | 0+00=3+99.5 LINE 3 | | | | | | | | | |
| | 1+00 | 86.5 86.4 | 78.98 79.00 | 7.5 7.4 | 1+04.3 | 4" STUB W 4" STUB E | | | 130 W. 45th S. | | Found by source Manl. 11-8-83 | | | |
| LIN 10 | 0+00 | 86.9 | 78.38 | 8.5 | 0+00=6+15.0 LINE 3 | | | | | | | | | |
| | 1+00 | 86.6 86.5 | 78.88 78.91 | 7.7 7.6 | 1+06.6 | 4" STUB SW 4" STUB SE | | | 140 W. 45th S. | | 1-6-78 | | | |

Repair- 1999-01426 - 4723 S. Main - AAA# NO LEAKS- Replace 6' at house - 4" SCH 40 12/21/99