


B262 A

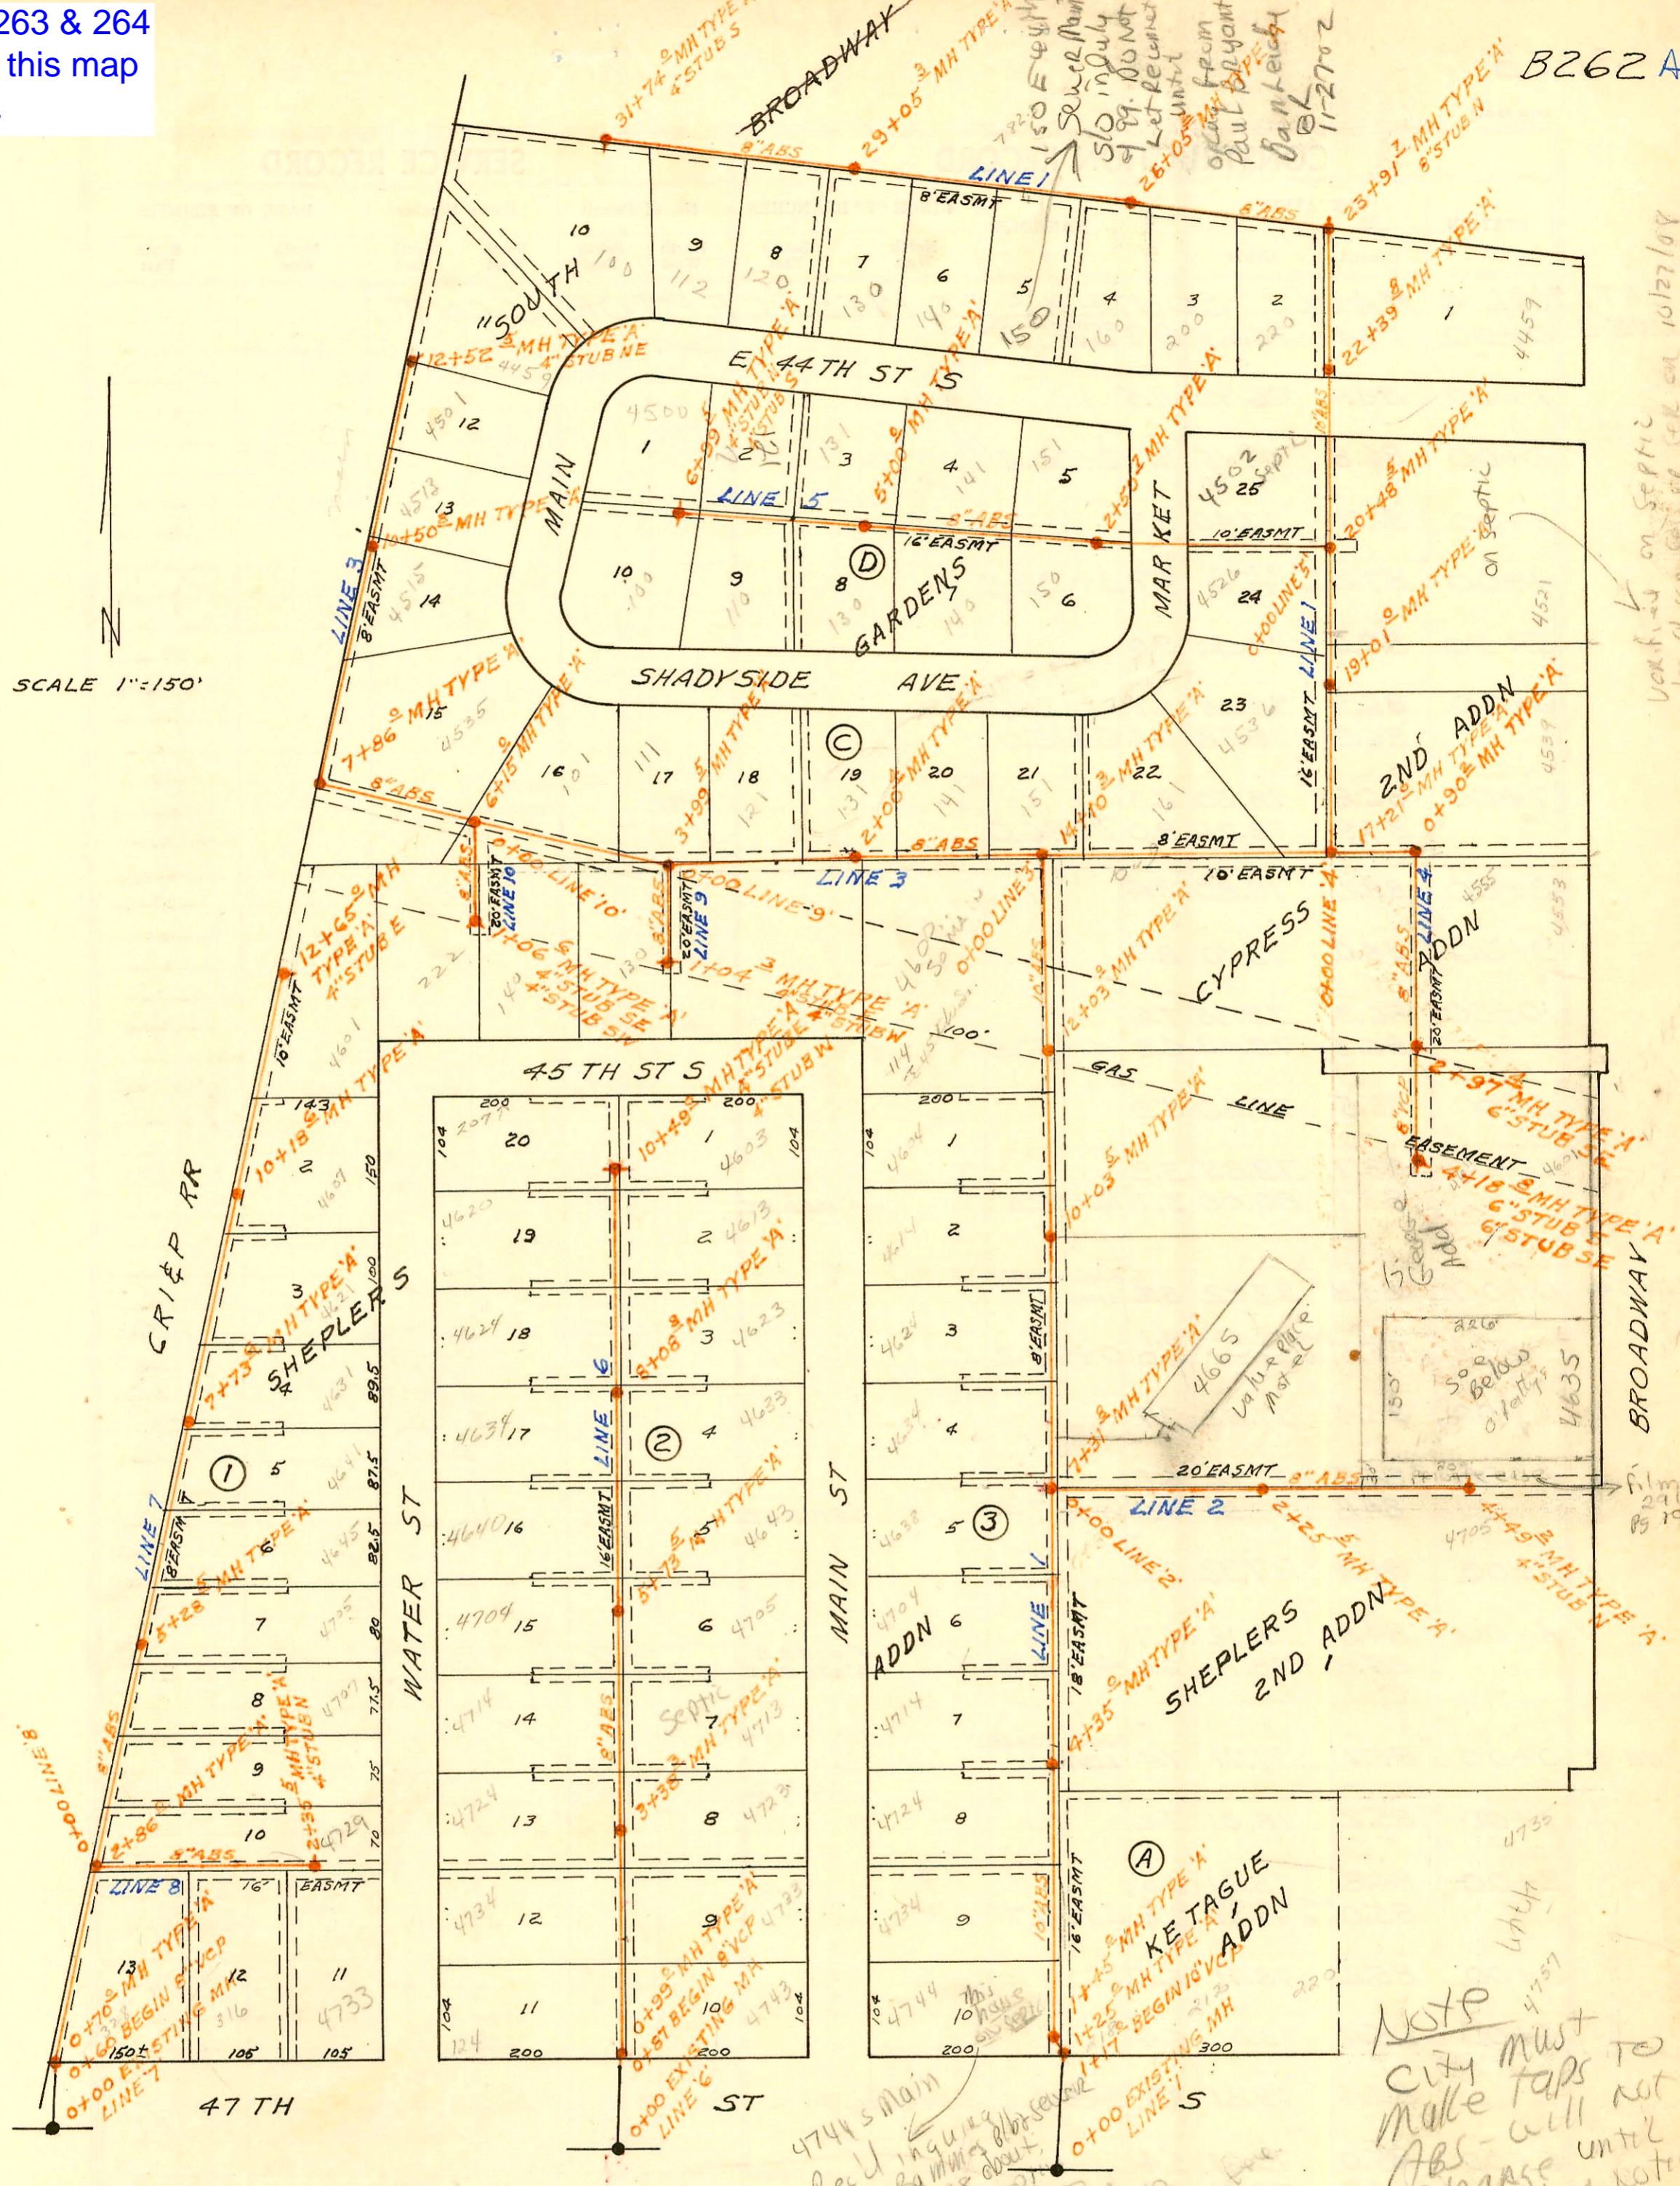

SCALE 1"=150'

Work on Septic
by Olson 10/27/04

NOTE
City must
make taps to
ABS - will not
charge until
further notice
12/20/01

4744 S Main
Rec'd Inquire
from Banning
May 1998 about
taking off sept
& sewer
does not want to
pay
wants to have
D.L. to have
line for 4731
Main. He'll
5/27/08

LATERAL 4 MAIN 2 SOUTHWEST INTERCEP
BUILT BY: WOODSIDE CONST. CO.
PROJ. NO DBKL 570013
BOOKED 9-1-76 FROM SS #11 JAK

4635 S Broadway - O'Reilly Auto
Refer to copy of Deed to previous owner
Wilma Matney from J. George granting her
full rights to lot and existing improvements
which incl the sewer Conn done in 1979.
Property was sold to O'Reilly Auto Parts incl
the improvements. Attorney for O'Reilly's
says the rights to city sewer go with
the parcel of land purchased by O'Reilly.
10/31/96


CONSTRUCTION RECORD

SERVICE RECORD

STATION	ELEVATION		Depth	MANHOLE	4-INCH "Y" BRANCHES		No. of Permit		House Number		DATE OF PERMITS	
	Ground	Grade			North West	South East	North West	South East	North West	South East	North West	South East
	LATERAL 4 MAIN 2 SOUTHWEST INTERCEPTOR (CONTINUED FROM B261)											
LINE 1 8+00	86.6	75.47	11.1		8+85.1		260392	2054 25253 25254	4624 main	4605 Broadway 4605 Broadway	3-16-77	1-29-84 1-29-84
9+00	86.4	75.62	10.8		9+21		256793		4604 S. main		7-16-76	
10+00	86.0	75.77	10.2									
	86.0	75.77	10.2	10+03.5	4" PVC 40 10+15.5 TAP		95205177		4614 NK MAIN		12-15-95	
11+00	86.0	75.92	10.1									
12+00	86.6	76.07	10.5									
	86.6	76.07	10.5	12+03.0								
13+00	87.3	76.22	11.1									
14+00	86.6	76.37	10.2									
	86.5	76.38 OUT IN 76.48	10.7 10.0	14+10.3	TAP							
15+00	86.7	76.62	10.1		15+27.3 TAP		4051		161 Shadydale		9-2-81	
16+00	86.4	76.77	9.6									
17+00	85.9	76.92	9.0									
	85.8	76.95 OUT IN 77.05	8.9 8.8	17+21.0								
18+00	85.3	77.17	8.1									
					18+63 TAP		13299		4536 S. Mt.		3-18-85	
19+00	84.6	77.32	7.3									
	84.6	77.32	7.3	19+01.0								
20+00	85.0	77.47	7.5									
	85.1	77.54	7.6	20+48.5								
21+00	85.0	77.62	7.4									
22+00	84.5	77.77	6.7									
	83.9	77.82	6.1	22+39.8	18+31.8 TAP		266760		220 E 44th St.		6-9-78	
23+00	84.0	77.92	6.1									
	84.2	78.05	6.2	23+91.7	8" STUB N TAP 23+69.6		261892		4489 S. Broadway		6/30/77	
24+00	84.3	78.22	6.1									
25+00	84.6	78.44	6.2									
					25+33.8		50291		2005 44th St		10-2-76	
26+00	85.5	78.66	6.8									
	85.6	78.67	6.9	26+05.2	4" SOR 35 26+27.2 tap 4" SCH 40 27+16.2 27+16.8 27+49.9		91-18915-7 2002- 03499 #3503 28241		160 E 44th St N/C 150 E 44th St tied to exist 270W CO 6-4-CMF		3-7-71 6-16-81 10-19-76	
27+00	86.5	78.85	7.7									
28+00	87.5	79.05	8.5									
29+00	88.2	79.25	9.0									
	88.2	79.26	8.9	29+05.3	28+96.8 TAP 28+34.3		257029 257591		130 E 44th St 130 E 44th St		8-3-76 9-8-76	
30+00	86.5	79.45	7.1									
31+00	87.7	79.65	8.1									
	88.0	79.79	8.2	31+74.0	TAP 30+70.6 4" STUB S		257590 257588		44th St 100 E 44th St		9-8-76 9-2-76	
LINE 2 0+00	86.4	77.20	9.2	0+00=7+31.8 LINE 1								
1+00	86.2	77.60	8.6		City Tap 6" Predco Donut	4" Predco Saddle w/ 1+12	2004- 00254		4605 Broadway		1/29/04	
2+00	85.8	78.00	7.8									
	86.0	78.10	7.9	2+25.5								
3+00	86.5	78.40	8.1									
4+00	87.5	78.80	8.7									
	86.4	79.00	7.4	4+49.2	4" STUB N		96-5574-7 271680		4635 250 Broadway		4-22-76 5-10-79	

abandoned siph tank found 4743 S. Main * 92-9693-17 4-22-92 (4" PVC 40 4" city tap into new 21' section of line replaced by city)

96-21504-7 4635 S. Broadway 12-12-96 Tied into 4" ABS stub at 4+49.2, 4" PVC 40

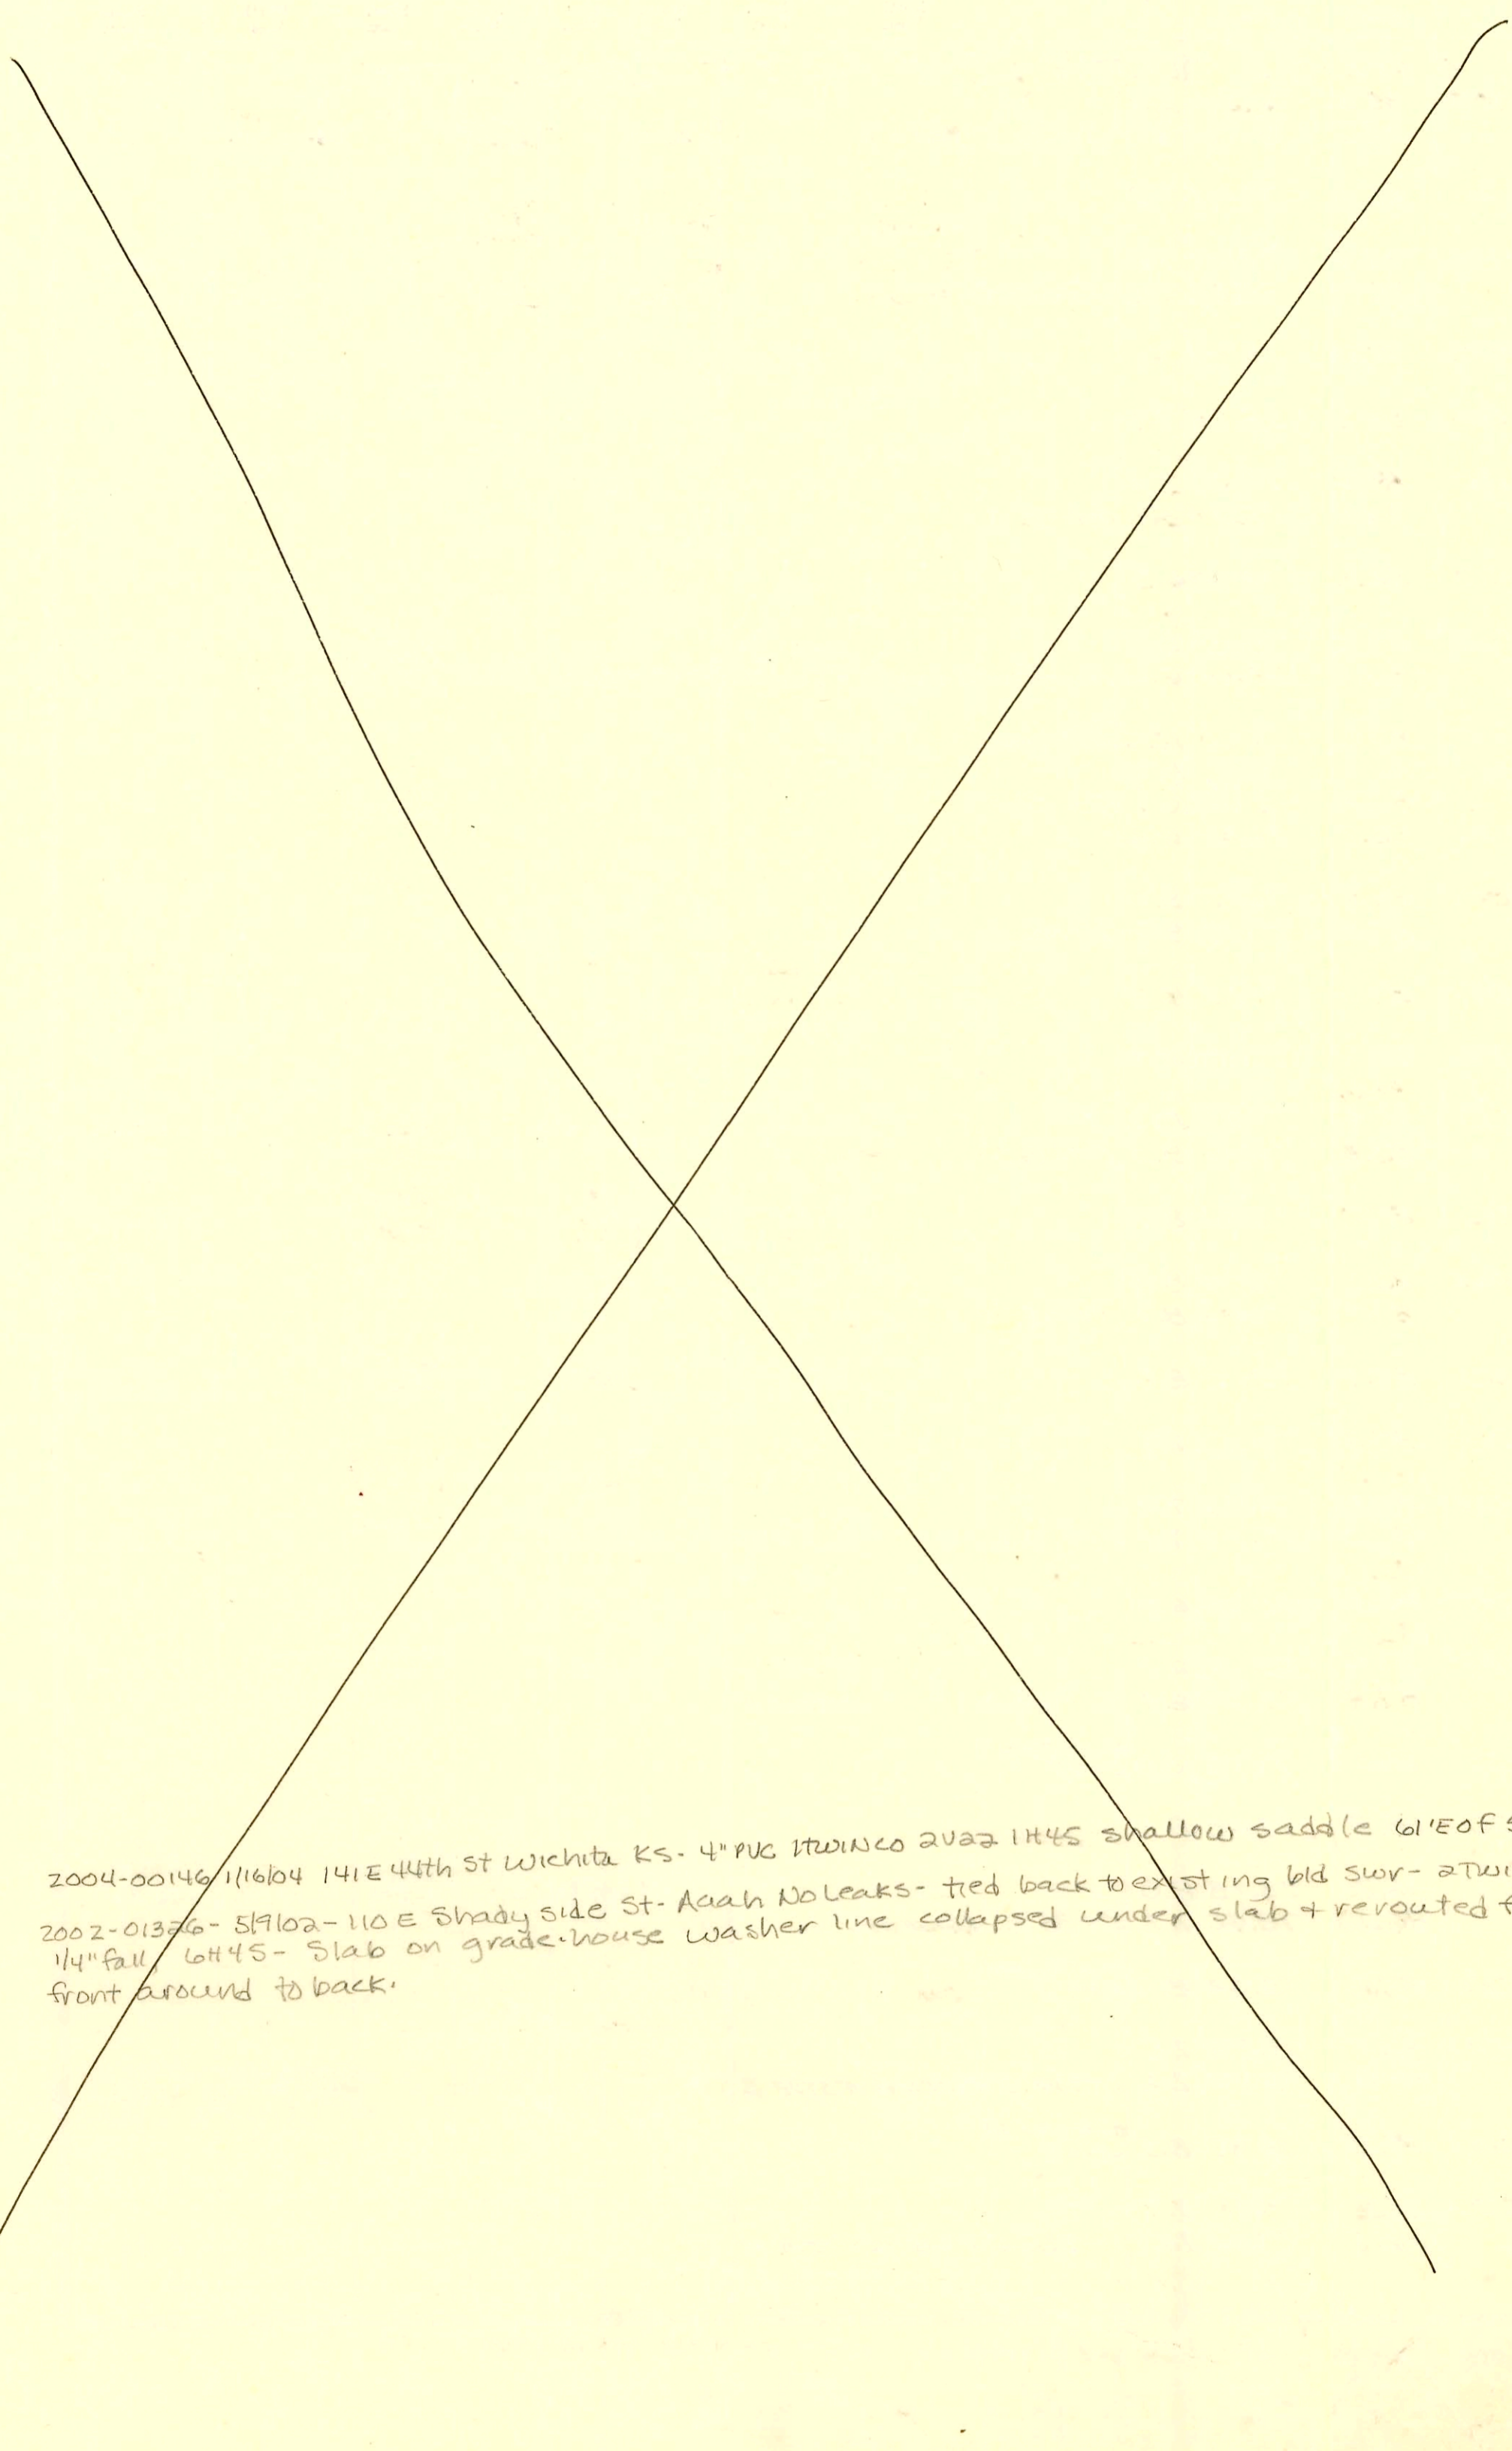

2004-00146 1/16/04 141 E 44th St Wichita KS - 4" PVC ITWINCO 2002 1H45 shallow saddle 61' E of 5100 (4137)
2002-01376- 51902- 110 E Shady side St. Aaah NO leaks - tied back to existing bld swr - 2TWINCO -
1/4" fall 6H45 - Slab on grade house washer line collapsed under slab + rerouted from
front around to back.

CONSTRUCTION RECORD

SERVICE RECORD


STATION	ELEVATION		Depth	MANHOLE	4-INCH "Y" BRANCHES		No. of Permit		House Number		DATE OF PERMITS	
	Ground	Grade			North West	South East	North West	South East	North West	South East	North West	South East
LATERAL 4 MAIN 2 SOUTHWEST INTERCEPTOR (CONT.)												
LINE 3 0+00	86.5	76.65	9.9	0+00=14+10.3 LINE 1	0+13.1	0+70.4	58239	275585	151 R Shadyside	114 E. 45 S	1-24-2080	12-3-79
1+00	88.4	76.90	11.5									
2+00	86.8	77.15	9.7	2+00.4	1+38.6 2+19.8 2+71.5		258290 257730 287	141 Shadyside 131 R Shadyside 121 Shadyside		10-21-76 9-23-76 5-12-80		
3+00	86.7	77.40	9.3									
4+00	87.2	77.65 77.75	9.6 9.5	3+99.5								
5+00	87.0	78.00	9.0									
6+00	86.9	78.25 78.28	8.7 8.6	6+15.0								
7+00	86.8	78.50 78.76	8.3 9.0	7+86.0	6+73.3		262396		4535 L Main		8-3-77	
8+00	88.2	78.80	9.4									
9+00	88.0	79.10	8.9									
10+00	86.9	79.35 79.48	7.6 6.8	10+50.8		4" SOR 35 10+08.3 top	22006		4515 S. Main		11-18-88	
11+00	85.5	79.60	5.9			10+64 1/2	268443		4513 L Main		8-30-78	
12+00	83.7	79.85 80.00	3.9 3.7	12+52.5		TAP 11+55.5 4" STUB NE	262282 257589		4501 L Main 4515 S. Main		7-27-77	
LINE 4 0+00	85.8	77.22	8.6	0+00=17+21.0 LINE 1								
	85.5	77.40 77.50	8.1 8.0	0+90.2		MH top	97-80547 256750		4537 S/D Main		5-18-76	
1+00	85.4	77.52	7.7			1+72.6 1+77.9 2+72.0	256828 261746 256827		4553 L S. Broadway 4553 Main 4555 L Broadway		7-21-76 6-27-77 7-21-76	
2+00	84.5	77.72 77.91	6.8 6.9	2+97.4		6" STUB SE						
3+00	84.9	77.92	7.0				264159		4611 L Bluff		12-1-77	
4+00	84.8	78.12 78.16	6.7 6.6	4+18.8		6" STUB S 6" STUB SE	264157 264158		4611 L Bluff		11-22-77 11-22-77	
LINE 5 0+00	85.1	77.71	7.4	0+00=20+48.5 LINE 1								
1+00	85.2	78.01	7.2			0+93.2	260039		4526 S. Market		2-25-77	
2+00	84.8	78.31 78.46 78.56	6.5 6.5 6.4	2+50.7								
3+00	85.2	78.71	6.5			3+10.7	258091		151 S. 444 S		10-8-76	
4+00	85.4	79.01	6.4									
	84.4	79.31	5.1	5+00	4+40 4439 4+41.0 5+22.8 TAP 6+59.4	4+80.5 5+08.2 6+59.4	208446 58240 267389 257829	57316 141 R 131 E 444 S	1-16-04 10-19-76 7-17-78		10-22-76 10-19-76 10-23-76	
6+00	85.0	79.61 79.91	5.4 5.0	6+99.5	6+34.8 see below	4" STUB N 4" STUB S	1590 257587	141 E 444 S 4500 S Main	10-28-80 9-8-76		4-16-96 12-11-86	
LINE 6 0+00	85.2	74.65	10.6	0+00 EXISTING								
0+87	85.5	74.81	10.7									
1+00	85.5	76.10	9.4	0+99.0		1+70	258596		12420 4726 S.		11-10-76	
2+00	85.0	76.50	8.5			2+04.4	258349		47345 Main		10-26-76	7-14-93 3/4/77

#92-36548-7 - 131 Shadyside - 9" 12" - Replaced from house towards main w/ 4" SDR35
1/4" Fall tied onto clay tile 15'± off main. 76-9807 6-25-96 100 E Shadyside - Newcomer 4" ABS

73-18509 (7-14-93) 4733 S Main (Det'd Garage) 4" SDR35 Tied Garage Line to existing Bldg Sewer.

STATE BOARD

CONSTRUCTION RECORD

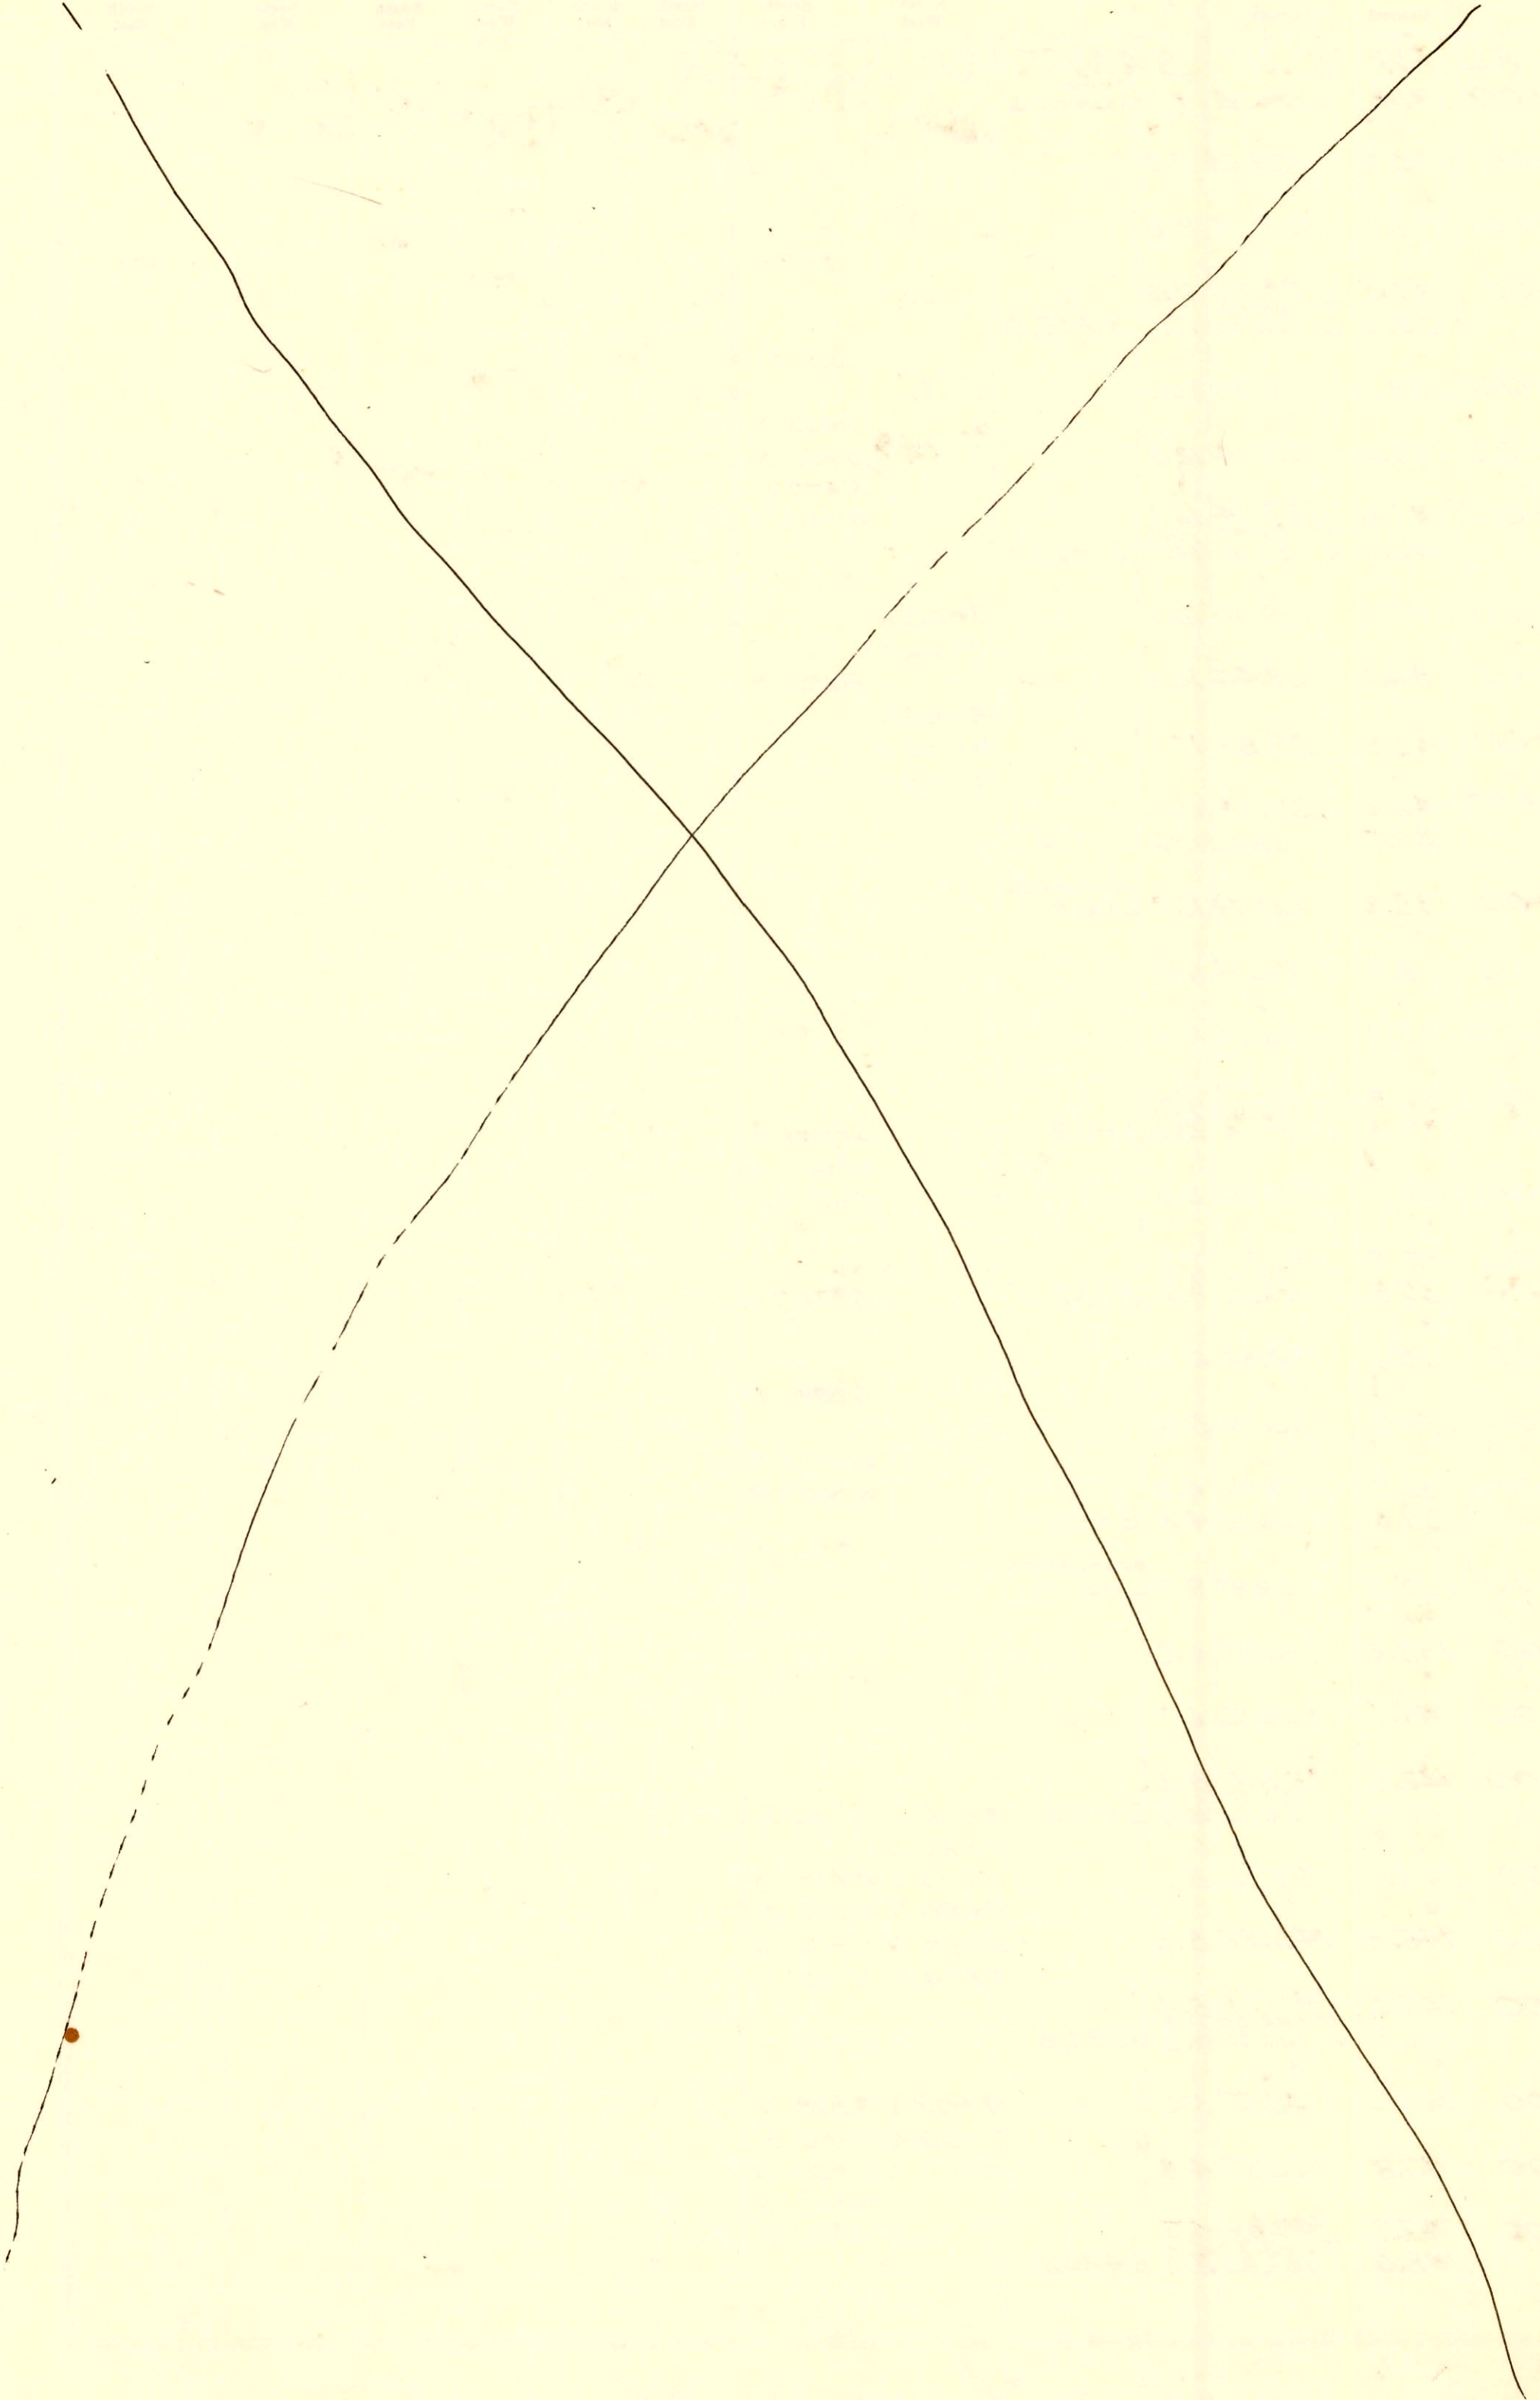

CONSTRUCTION RECORD

SERVICE RECORD

STATION	ELEVATION		Depth	MANHOLE	4-INCH "Y" BRANCHES		No. of Permit		House Number		DATE OF PERMITS	
	Ground	Grade			North West	South East	North West	South East	North West	South East	North West	South East
LATERAL 4 MAIN 2 SOUTHWEST INTERCEPTOR (CONT)												
LIN 6 CONT	3+00	85.0 85.2	76.90 77.06 77.16	8.1 8.1 8.0	3+38.3	3+28.6	3+19	C58942 C54654	49042 4724 S. Water	4723 S. Main	see below 4-6-76	12-9-99 12-2-76
	4+00	85.3	77.40	7.9		4+49.1		C58761	4714 S. Water	4725 S. Main	11-19-76	
	5+00	85.4 85.4	77.80 78.20	7.6 7.2	5+73.5	5+61.8		C54373 C54845	4704 S. Water		4-12-76	3-23-76
	6+00	85.4	78.29	7.1		6+58.0		C54671 C54761	4640 S. Water	4643 S. Main	7-15-91 4-12-76	6-16-80
	7+00	85.7	78.65	7.1		7+55.8		C71817	4634 S. Water		5-17-79	
	8+00	84.5 84.6	79.01 79.04	5.5 5.6	8+08.8			C61174	4624 S. Water	4623 S. Main	4-14-76	5-17-77
	9+00	86.2	79.40	6.8		9+58.4		C54819	4624 S. Water	4623 S. Main	4-14-76	12-1-76
	10+00	86.2 86.3	79.80 80.00	6.4 6.3	10+49.0	10+01.0		C54820 C68649	4620 S. Water 207 W. 45th	4613 S. Main 4603 S. Main	4-14-76 9-29-98	8-22-86 8-30-89
LIN 7	0+00	87.8	75.20	12.6	0+00 EXISTING							
	0+60	87.7	75.32	12.4								
		86.6	75.34 76.20	11.3 10.4	0+70.0							
	1+00	86.5	76.32	10.2								
	2+00	86.6 87.0	76.72 77.08	9.9 9.9	2+86.0							
	3+00	87.1	77.12	10.0		3+44.5		C68526	4707 S. Water		9-25-78	
	4+00	87.7	77.52	10.2								
	5+00	88.2 87.9	77.92 78.06	10.3 9.8	5+28.5			C57878	4705 S. Water		9-27-76	
	6+00	87.0	78.32	8.7		6+36.1		C57244	4645 S. Water		8-17-76	
	7+00	86.7 87.7	78.72 79.04	8.0 8.7	7+73.6			C72811	4641 S. Water		7-6-79	
	8+00	87.7	79.12	8.6		8+11.6		14994	4631 Water		11-6-85	
	9+00	87.4	79.52	7.9								
	10+00	87.3 87.1	79.92 80.02	7.4 7.1	10+18.6			C66882 C56688	4621 S. Water 4607 S. Water		6-16-78 7-13-76	
	11+00	86.9	80.32	6.6								
	12+00	87.4 87.4	80.72 81.00	6.7 6.4	12+65.0			C56686	4601 S. Water		7-13-76	
LIN 8	0+00	87.2	77.18	10.0	0+00=2+86.0 LINE 7							
	1+00	85.8	77.68	8.1								
	2+00	86.2 86.1	78.18 78.40	8.0 7.7	2+35.5	2+05.9		C6593 C66896	3/6 W. 4733 Water		9-21-82 5-12-76	
LIN 9	0+00	87.2	78.48	8.7	0+00=3+39.5 LINE 3							
	1+00	86.5 86.4	78.98 79.00	7.5 7.4	1+04.3	4" STUB W 4" STUB E		4" Permit	130 W. 45th S.	Found by source Manl. 11-8-83		
LIN 10	0+00	86.9	78.38	8.5	0+00=6+15.0 LINE 3							
	1+00	86.6 86.5	78.88 78.91	7.7 7.6	1+06.6	4" STUB SW 4" STUB SE		C64767	140 W. 45th S.		1-6-78	

Repair- 1999-01426 - 4723 S. Main - AAAH NO LEAKS - Replace 6' at house - 4" SCH 40 12/21/99