


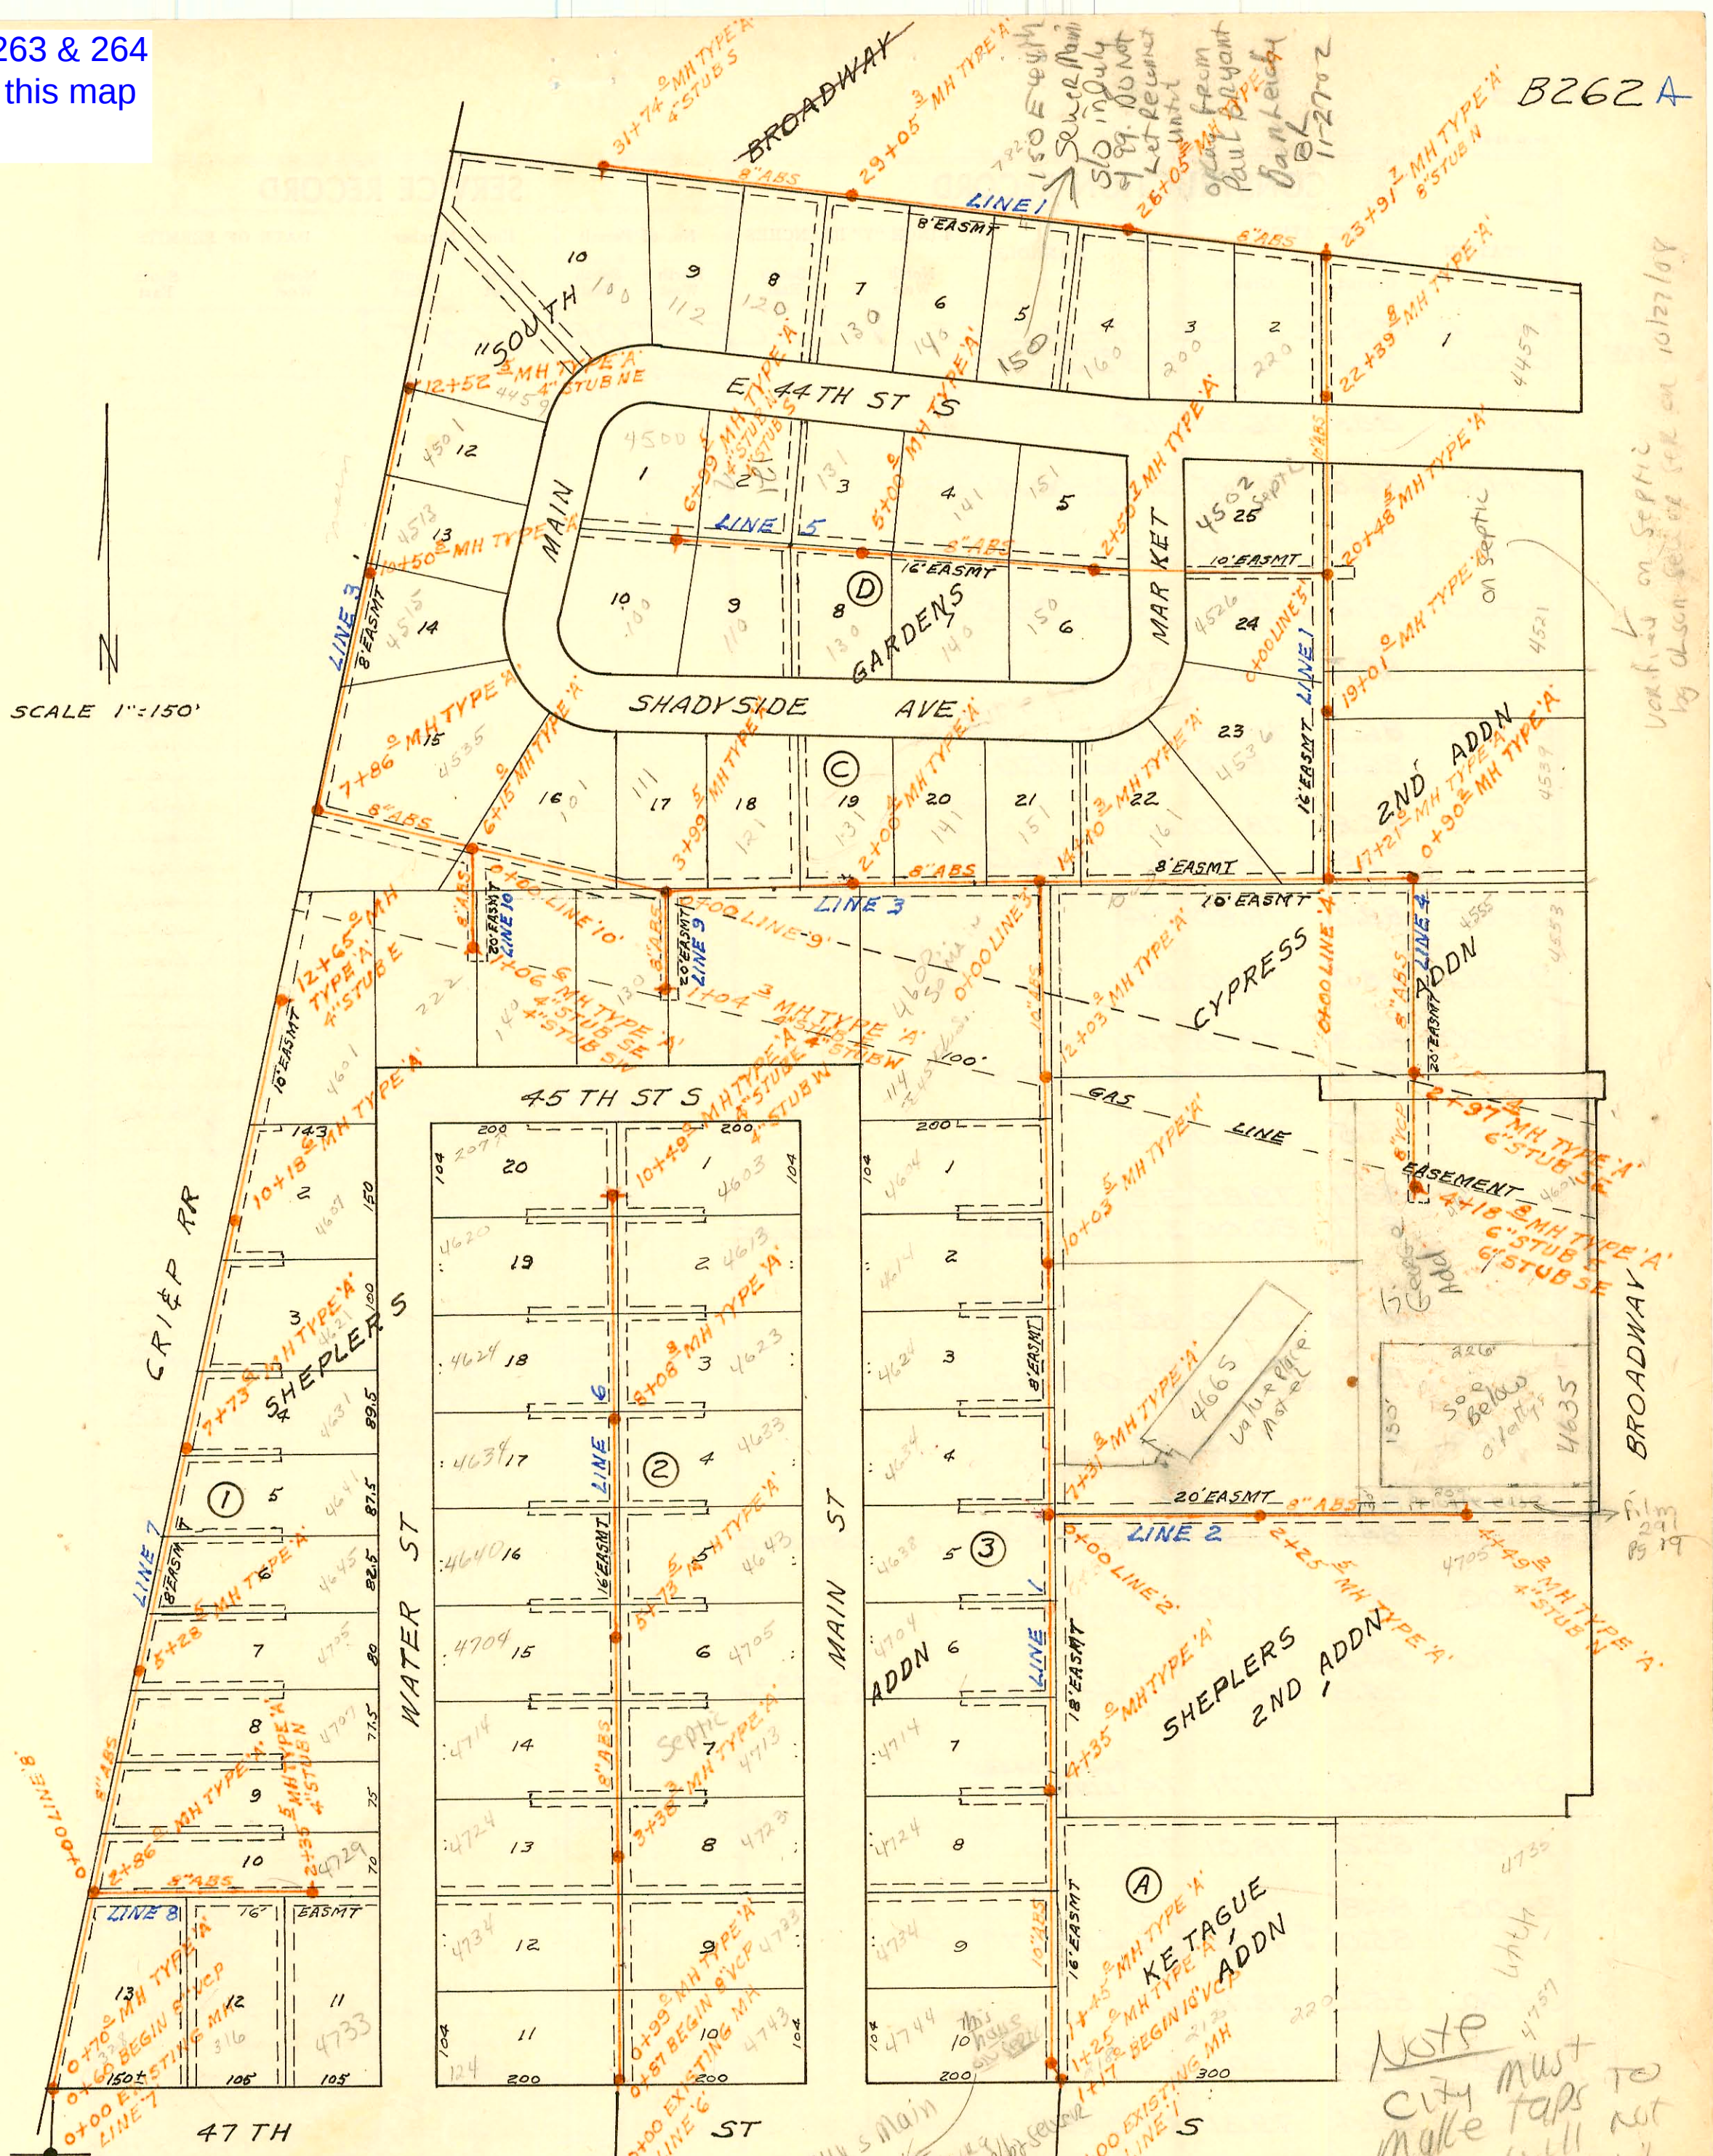

4635 S Broadway - O'Reilly Auto
Refer to copy of Deed to previous owner
Wilma Matney from J. George granting her
full rights to lot and existing improvements
which incl the sewer Conn done in 1979.
Property was sold to O'Reilly Auto Parts incl
the improvements. Attorney for O'Reilly's
says the rights to city sewer go with
the parcel of land purchased by O'Reilly.
10/31/96

4744 S Main
Rec'd inquiry
from Banning about
May 1998 about
taking off sewer
& connecting to
sewer main
does not want to
pay
wants to have
D.L. to have
line for 4734
to sewer
main. He is
5/27/98

LATERAL 4 MAIN 2 SOUTHWEST INTERCEP
BUILT BY: WOODSIDE CONST. CO.
PROJ. NO DBKL 570013
BOOKED 9-1-76 FROM SS #11 JAK

NOTE
CITY must
make taps to
ABS - will not
charge until
further notice
12/20/01

CONSTRUCTION RECORD

SERVICE RECORD

STATION	ELEVATION		Depth	MANHOLE	4-INCH "Y" BRANCHES		No. of Permit		House Number		DATE OF PERMITS	
	Ground	Grade			North West	South East	North West	South East	North West	South East	North West	South East
LATERAL 4 MAIN 2 SOUTHWEST INTERCEPTOR (CONTINUED FROM B261)												
LINE 1 8+00	86.6	75.47	11.1		8+85.1		260392	2034 25253 25254	46242. main	4605 Broadway	3-16-77	1-29-84
9+00	86.4	75.62	10.8		9+21		256743		4604 S. main	4605 Broadway	7-16-76	1-29-84
10+00	86.0	75.77	10.2									
	86.0	75.77	10.2	10+03.5	4" PVC 40	10+15.5 TAP	95205177		4604 N/C main		12-15-95	
11+00	86.0	75.92	10.1									
12+00	86.6	76.07	10.5									
	86.6	76.07	10.5	12+03.0								
13+00	87.3	76.22	11.1									
14+00	86.6	76.37	10.2									
	86.5	76.38	10.7									
	86.5	76.48	10.0	14+10.3								
15+00	86.7	76.62	10.1		15+27.3 TAP		4051		161 Shadydale		9-2-81	
16+00	86.4	76.77	9.6									
17+00	85.9	76.92	9.0									
	85.8	76.95	8.9									
	85.8	77.05	8.8	17+21.0								
18+00	85.3	77.17	8.1									
			1		18+63 TAP		13244		4536 S. Mt.		3-18-85	
19+00	84.6	77.32	7.3									
	84.6	77.32	7.3	19+01.0								
20+00	85.0	77.47	7.5									
	85.1	77.54	7.6	20+48.5								
21+00	85.0	77.62	7.4									
22+00	84.5	77.77	6.7									
	83.9	77.82	6.1	22+39.8	18+63 TAP	23+01.8	66760		220 E. 44th St.		6-9-78	
23+00	84.0	77.92	6.1									
	84.2	78.05	6.2	23+91.7	8" STUB N	23+69.6	661892		4459 S. Broadway		6/30/77	
24+00	84.3	78.22	6.1									
25+00	84.6	78.44	6.2									
					25+33.8		50291		2005 E. 44th St.		10-2-76	
26+00	85.5	78.66	6.8									
	85.6	78.67	6.9	26+05.2	4" SOR 35	26+27.2 TAP	91-18915-7		160 E. 44th St.		3-7-71	
27+00	86.5	78.85	7.7		4" SCH 40	27+16.2	2002-03499		N/C 150 E. 44th St. tied to exist	SWR w/ PVC	12/31/02	
					27+16.3		3503		150 E. 44th St.	6-16-81		
					27+44.9		28241		140 E. 44th St.	10-19-76		
28+00	87.5	79.05	8.5									
29+00	88.2	79.25	9.0									
	88.2	79.26	8.9	29+05.3	28+96.8		57029		130 E. 44th St.		8-3-76	
30+00	86.5	79.45	7.1		TAP	28+34.3	57591		130 E. 44th St.		9-8-76	
31+00	87.7	79.65	8.1		TAP	30+70.6	57590		130 E. 44th St.		9-8-76	
	88.0	79.79	8.2	31+74.0	4" STUB S		57588		100 E. 44th St.		9-8-76	
LINE 2 0+00	86.4	77.20	9.2	0+00=7+31.8 LINE 1								
1+00	86.2	77.60	8.6	City Tap 6" Predco Donut	4" Predco Saddle w/ 1+12		2004-00254		4605 Broadway		1/29/04	
2+00	85.8	78.00	7.8									
	86.0	78.10	7.9	2+25.5								
3+00	86.5	78.40	8.1									
4+00	87.5	78.80	8.7									
	86.4	79.00	7.4	4+49.2	4" STUB N		96-5574-7		4635 Broadway		4-22-76	
							271680				5-10-79	

4743 S. main * 92-9693-17 4-22-92 (4" PVC 40 4" city tap into new 21" section of line replaced by city)

96-21504-7 4635 S. Broadway 12-12-96 Tied into 4" ABS stub at 4+49.2, 4" PVC 40

2004-00146 1/16/04 141 E 44th St Wichita KS - 4" PVC ITWINCO 2022 1H45 shallow saddle 61' E of 5100 (4137)
2002-01326-51902-110 E Shady side St - Auan No leaks - tied back to existing bld swr - 2TWINCO-
1/4" fall 6H45 - Slab on grade house washer line collapsed under slab + rerouted from
front around to back.

CONSTRUCTION RECORD


SERVICE RECORD

	STATION	ELEVATION		Depth	MANHOLE	4-INCH "Y" BRANCHES		No. of Permit		House Number		DATE OF PERMITS	
		Ground	Grade			North West	South East	North West	South East	North West	South East	North West	South East
LATERAL 4 MAIN 2 SOUTHWEST INTERCEPTOR (CONT.)													
LINE 3	0+00	86.5	76.65	9.9	0+00=14+10.3 LINE 1	0+13.1	0+70.4	058202 58239	075585	151 R 114 E.	45 S	1-24-2080 10-19-76	12-3-79
	1+00	88.4	76.90	11.5									
	2+00	86.8	77.15	9.7	2+00.4	1+38.6 2+19.8 2+71.5		058290 93-295487 057730 #287		141 Shadyside 131 R Shadyside 121 Shadyside		10-21-76 9-23-76 5-12-80	
	3+00	86.7	77.40	9.3									
	4+00	87.2	77.65 77.75	9.6 9.5	3+99.5								
	5+00	87.0	78.00	9.0									
	6+00	86.9	78.25 78.28	8.7 8.6	6+15.0								
	7+00	86.8	78.50 78.76	8.3 9.0	7+86.0	6+73.3		062396		4535 S. Main		8-3-77	
	8+00	88.2	78.80	9.4									
	9+00	88.0	79.10	8.9									
	10+00	86.9	79.35 79.48	7.6 6.8	10+50.8		4" SDR 35 10+08.3 top	22006		4515 S. Main		11-18-88	
	11+00	85.5	79.60	5.9			10+64.4	068143		4513 S. Main		8-30-78	
	12+00	83.7	79.85 80.00	3.9 3.7	12+52.5		TAP 11+55.5 4" STUB NE	062282 057589		4501 S. Main 4515 S. Main		7-27-77	
LINE 4	0+00	85.8	77.22	8.6	0+00=17+21.0 LINE 1				97-80547 056750	4537 S. Main		5-18-76	
		85.5	77.40 77.50	8.1 8.0	0+90.2		MH top		056828	4538 S. Broadway		7-21-76	
	1+00	85.4	77.52	7.7			1+72.6 1+87.9 2+72.0	061746 056827		4539 S. Broadway		6-27-77 7-21-76	
	2+00	84.5	77.72	6.8									
		84.8	77.91	6.9	2+97.4		6" STUB SE						
	3+00	84.9	77.92	7.0				064159		4511 S. Broadway		12-1-77	
	4+00	84.8	78.12	6.7									
		84.8	78.16	6.6	4+18.8		6" STUB S 6" STUB SE	064159 064158		4511 S. Broadway		11-22-77 11-22-77	
LINE 5	0+00	85.1	77.71	7.4	0+00=20+48.5 LINE 1								
	1+00	85.2	78.01	7.2			0+93.2	060039		4526 S. Main		2-25-77	
	2+00	84.8	78.31	6.5									
		85.0	78.46 78.56	6.5 6.4	2+50.7								
	3+00	85.2	78.71	6.5		3+10.7		058091		4518 S. 444 S.		10-8-76	
	4+00	85.4	79.01	6.4									
		84.4	79.31	5.1	5+00	4+40 4+41 5+22.8 TAP 6+29.4	4+80.5 5+08.2 6+29.4	208446 58240 067389 057829	141 R 140 R 131 E 144 S	1-16-04 10-19-76 7-17-78 see Shadyside next		10-22-76 10-19-76 10-23-76	
	6+00	85.0	79.61	5.4		6+34.8	Soe below	15901	121 E 444 S 4500 S. Main	10-28-80 9-8-76		4-16-96 12-11-86	
		84.9	79.91	5.0	6+99.5	4" STUB N	4" STUB S	057587					
LINE 6	0+00	85.2	74.65	10.6	0+00 EXISTING								
	0+87	85.5	74.81	10.7									
		85.5	76.10	9.4	0+99.0								
	1+00	85.5	76.10	9.4		1+70		058596		124 W 472 S.		11-10-76	
	2+00	85.0	76.50	8.5		2+04.4		058349	93-185007 060197	4734 S. Main		10-26-76	7-14-93 3/4/77

#92-36548-7 - 131 Shadyside - 9/22/82 - Replaced from house towards main w/ 4" SDR 35
1/4" Fall tied onto clay tile 15'± off main.

96-98807 6-25-76 100 E Shadyside - Newcomer Main 5'±
4" ABS

93-18508-7 (7-14-93) 4733 S Main (Det'd Garage) 4" SDR 35 Tied Garage Line to
existing Bldg Sewer.

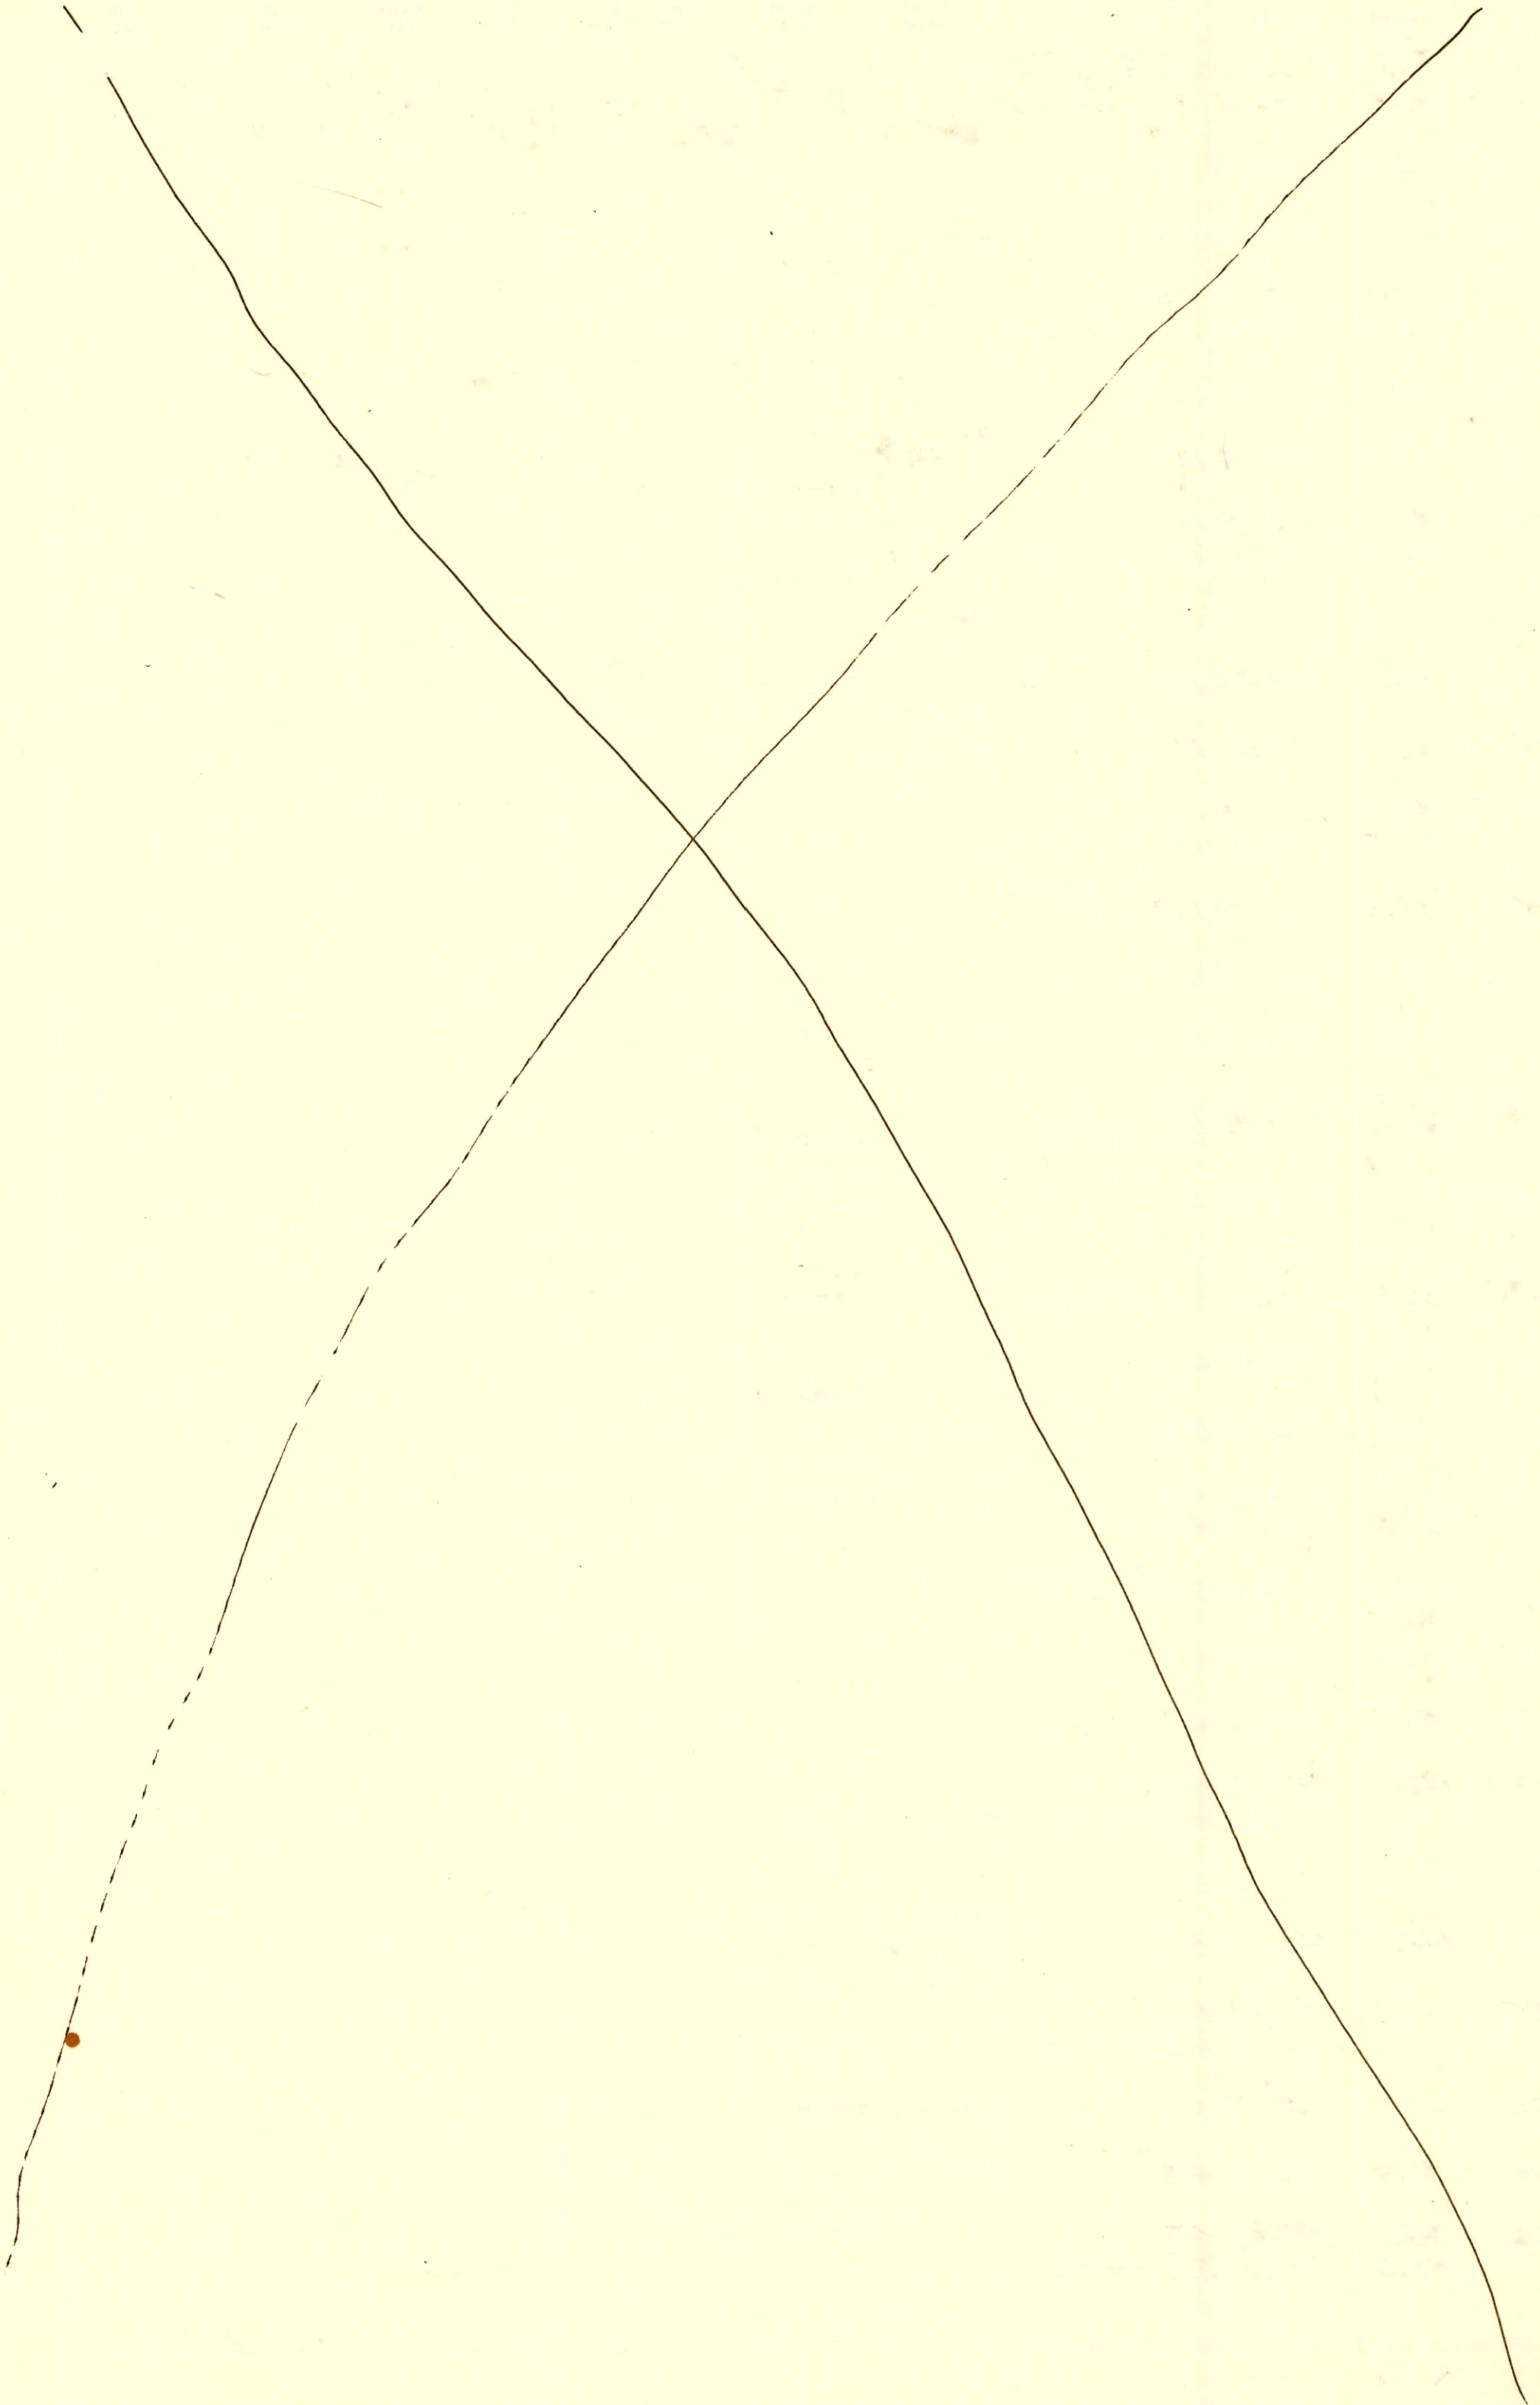

B264

Form 42-020

CONSTRUCTION RECORD

SERVICE RECORD

	STATION	ELEVATION		Depth	MANHOLE	4-INCH "Y" BRANCHES		No. of Permit		House Number		DATE OF PERMITS	
		Ground	Grade			North West	South East	North West	South East	North West	South East	North West	South East
LATERAL 4 MAIN 2 SOUTHWEST INTERCEPTOR (CONT)													
LINE 6 CONT.	3+00	85.0	76.90	8.1			3+19		C58942	4704 S. Water	4723 S. Main	see below	12-9-99
		85.2	77.96	8.0	3+38.3	3+28.6		C59654		4724 S. Water		4-6-76	12-2-76
	4+00	85.3	77.40	7.9		4+49.1		C58761		4714 S. Water	4725 S. Main	11-19-76	
	5+00	85.4	77.80	7.6		5+67.5		C54373		4704 S. Water		4-12-76	3-23-76
		85.4	78.20	7.2	5+73.5	5+61.8		C54845					
	6+00	85.4	78.29	7.1		6+58.0 top		26946.7	C578	4640 S. Water	4643 S. Main	7-15-91	6-16-80
					6+64 top			C54761				4-12-76	
	7+00	85.7	78.65	7.1		7+55.8 top		C71817		4634 S. Water	4633 S. Main	5-17-79	5-17-79
	8+00	84.5	79.01	5.5		8+94.4		C61174					
		84.6	79.04	5.6	8+08.8	8+58.4		C54819		4624 S. Water	4623 S. Main	4-14-76	
	9+00	86.2	79.40	6.8		9+08		C58700		4620 S. Water		4-14-76	12-1-76
						9+70.6		C54820					
	10+00	86.2	79.80	6.4		10+01.0 top		16875	C68649	4613 S. Water	4603 S. Main	9-29-78	8-22-86
		86.3	80.00	6.3	10+49.0	4" STUB W	4" STUB E	23822		207 W. 45th			8-30-89
LINE 7	0+00	87.8	75.20	12.6	0+00 EXISTING								
	0+60	87.7	75.32	12.4									
		86.6	75.34	11.3	0+70.0								
	1+00	86.5	76.32	10.2									
	2+00	86.6	76.72	9.9									
		87.0	77.08	9.9	2+86.0								
	3+00	87.1	77.12	10.0		3+44.5		C68526		4707 S. Water		9-25-78	
	4+00	87.7	77.52	10.2									
	5+00	88.2	77.92	10.3		5+20.0		C57878		4705 S. Water		9-27-76	
		87.9	78.06	9.8	5+28.5								
	6+00	87.0	78.32	8.7		6+36.1		C57244		4645 S. Water		8-17-76	
	7+00	86.7	78.72	8.0		7+02 top		C72811		4641 S. Water		7-6-79	
		87.7	79.04	8.7	7+73.6								
	8+00	87.7	79.12	8.6		8+11.6 top		14994		4631 Water		11-6-85	
	9+00	87.4	79.52	7.9									
						9+56.3		C66882		4621 S. Water		6-16-78	
	10+00	87.3	79.92	7.4		10+01.6		C56688		4607 S. Water		7-13-76	
		87.1	80.02	7.1	10+18.6								
	11+00	86.9	80.32	6.6									
	12+00	87.4	80.72	6.7		12+28.6		C56686		4601 S. Water		7-13-76	
		87.4	81.00	6.4	12+65.0	4" STUB E							
LINE 8	0+00	87.2	77.18	10.0	0+00=2+86.0 LINE 7								
	1+00	85.8	77.68	8.1									
	2+00	86.2	78.18	8.0		2+05.9		C55391		4733 Water		9-21-82	5-12-76
		86.1	78.40	7.7	2+35.5	4" STUB N							
LINE 9	0+00	87.2	78.48	8.7	0+00=3+39.5 LINE 3								
	1+00	86.5	78.98	7.5		1+04.3	4" STUB W 4" STUB E	4" Permit		130 W. 45th S.	Found by SOWA Manl. 11-8-83		
		86.4	79.00	7.4									
LINE 10	0+00	86.9	78.38	8.5	0+00=6+15.0 LINE 3								
	1+00	86.6	78.88	7.7		1+06.6	4" STUB SW 4" STUB SE		C64767	140 W. 45th S.		1-6-78	
		86.5	78.91	7.6									

Repair- 1999-01426 - 4723 S. Main - AAAH NO LEAKS - Replace 6' at house - 4" SCH40 12/21/99