

* NOTE: Line F maintained by City - remainder is private system.

SCALE 1"=200'

COLONIAL PARK III
 SANITARY SEWER
 BUILT BY: TRI-CO. CONST. CO.
 PROJ. NO. DBKW 705064
 BOOKED 9-7-76 FROM K-106
 (PRIVATE SYSTEM EXCEPT AS NOTED)

CONSTRUCTION RECORD

SERVICE RECORD

STATION	ELEVATION		Depth	MANHOLE	4-INCH "Y" BRANCHES		No. of Permit		House Number		DATE OF PERMITS	
	Ground	Grade			North West	South East	North West	South East	North West	South East	North West	South East
COLONIAL PARK III SANITARY SEWER												
LINE F 0+00	131.3	124.18	7.1	0+00 EXISTING								
1+00	132.5	124.64	7.9			1+10 S						
2+00	133.7	125.11	8.6									
3+00	137.0	125.57	11.4									
	138.9	126.40	12.5	3+15.0								
4+00	138.7	126.74	12.0									
5+00	139.6	127.14	12.5			4+65 S						
6+00	141.6	127.54	14.1			5+15 S						
	142.0	127.90	14.1	6+65.5		5+77 S						
7+00	142.3	128.04	14.3			6+24 S						
8+00	144.7	128.44	16.3			7+03 N						
9+00	145.9	128.83	17.1			7+66 N						
10+00	146.2	129.24	17.0			8+22 S						
	147.5	129.30	18.2	10+14.5		8+84 N						
LINE E 0+00	138.9	125.74	13.2	0+00=3+15.0 LINE F		9+39 N						
1+00	138.5	126.14	12.4			9+94 N						
2+00	137.9	126.54	11.4									
3+00	137.3	126.93	10.4									
	137.3	127.15	10.2	3+03.7		3+33.7 E						
4+00	136.5	127.50	9.0			3+94.7 E						
5+00	135.8	127.86	7.9			4+51.7 E						
	135.5	128.05	7.4	5+52.5		5+11.7 W						
6+00	135.2	128.34	6.9			5+70.7 E						
7+00	134.5	128.74	5.8			6+86.7 E						
8+00	133.9	129.14	4.8			7+47.7 E						
	133.5	129.35	4.2	8+52.4		8+08.7 E						
LINE D 0+00	138.9	129.87	9.0	0+00=3+15.0 LINE F								
1+00	139.2	132.45	6.8									
2+00	141.1	135.02	6.1									
3+00	142.8	137.60	5.2									
	142.9	138.00	4.9	3+11.6		3+38 N						
4+00	144.3	139.16	5.1			3+54 S						
5+00	145.8	140.46	5.3			3+87 N						
6+00	147.2	141.77	5.4			4+33 N						
	147.5	142.30	5.2	6+32.8		4+13 S						
7+00	147.6	142.57	5.0			4+86 N						
8+00	147.8	142.97	4.8			5+38 N						
9+00	147.9	143.36	4.5			5+94 N						
	148.0	143.80	4.2	9+84.2		5+88 S						

510 7+21.4


2000 937 1671

3232 S House 10-31-80

C55274-

94-20371-7 12-21-74 3232 S. Clifton Lot 573 - Redd. Root R. 4" sch 40

B266A

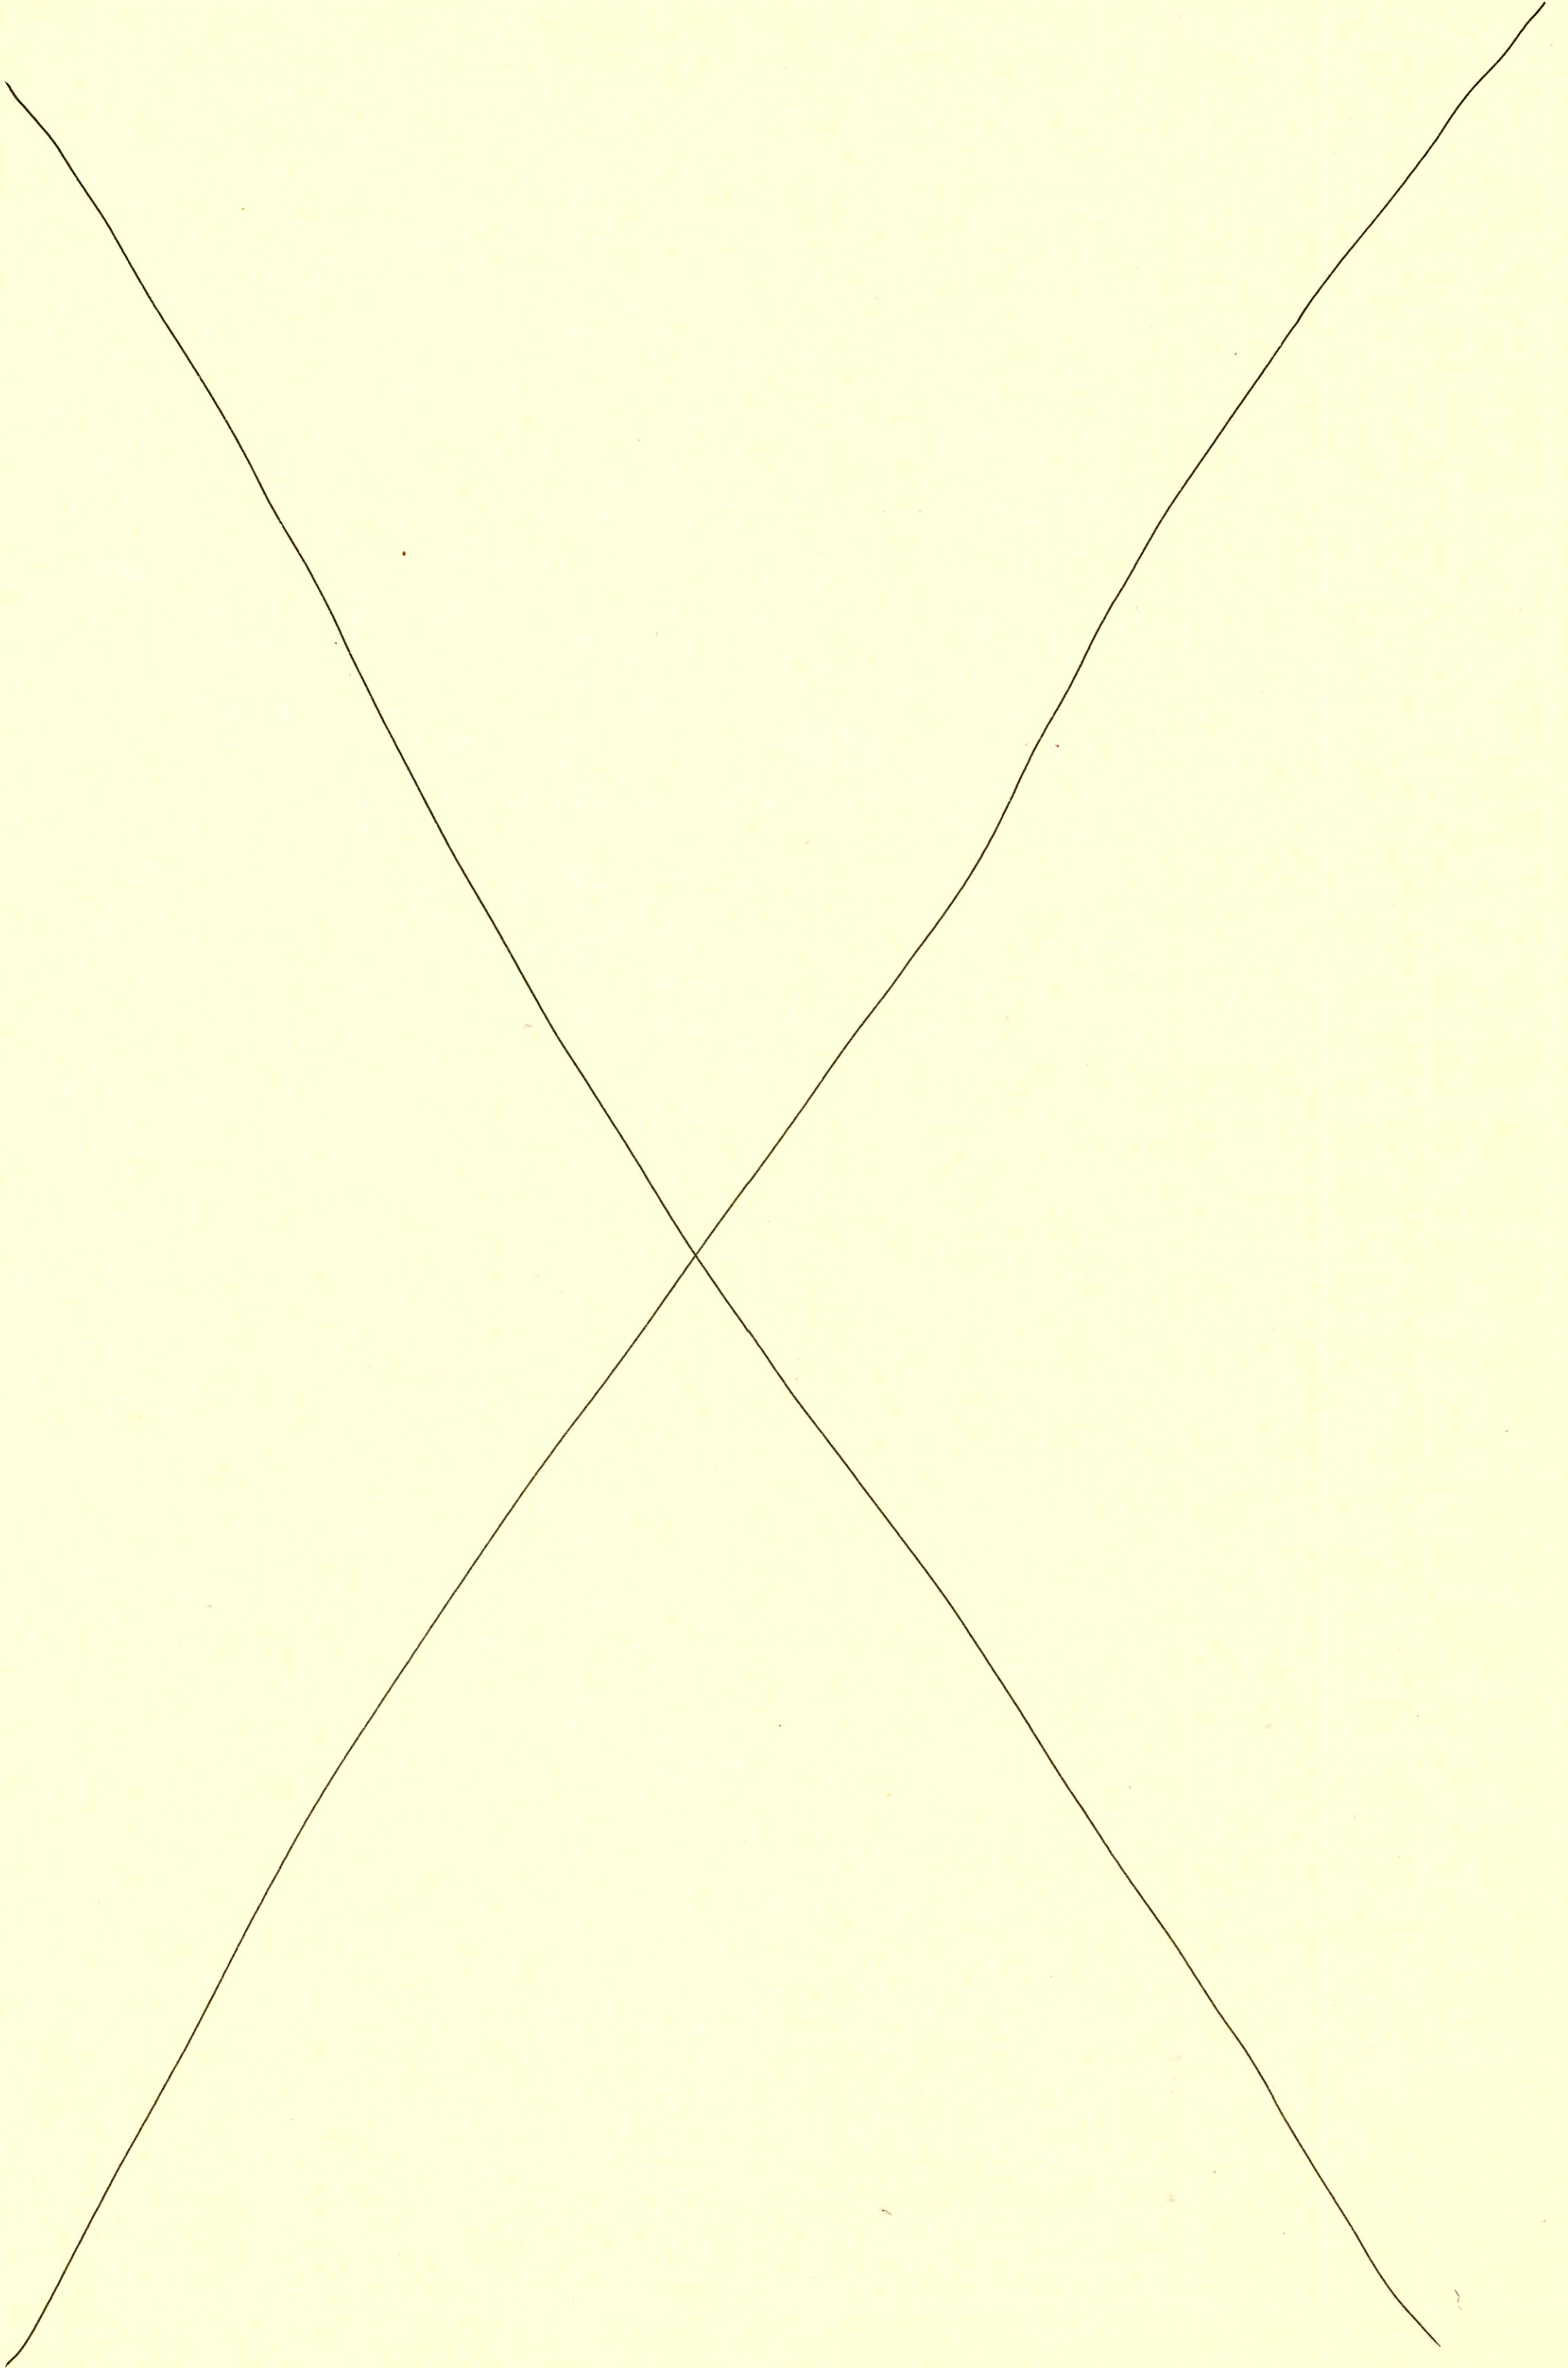

CONSTRUCTION RECORD

SERVICE RECORD

LINE D
(CONT)

LINE A

LINE B

STATION	ELEVATION		Depth	MANHOLE	4-INCH "Y" BRANCHES		No. of Permit		House Number		DATE OF PERMITS	
	Ground	Grade			North West	South East	North West	South East	North West	South East	North West	South East
COLONIAL PARK III (CONT)												
10+00	148.2	143.87	4.3		10+26 N	10+49 S						
11+00	148.9	144.33	4.6		10+73 N	11+23 N						
12+00	149.7	144.79	4.9		11+74 N	12+24 N						
13+00	150.5	145.24	5.3			12+80 S						
	150.7	145.40	5.3									
		145.50	5.2	13+34.2	13+84 W							
14+00	151.2	146.31	4.9		13+91 E							
15+00	152.0	147.55	4.5		14+30 W							
	152.3	148.10	4.2	15+44.7	14+97 W							
					6" STUB W	15+04 E						
					8" STUB N							
0+00	138.9	129.64	9.3	0+00=3+15.0 LINE F								
1+00	140.0	130.13	9.9									
2+00	140.5	130.61	9.9									
	140.0	130.97	9.0									
		131.07	8.9	2+74.5								
3+00	139.9	131.17	8.7									
4+00	139.4	131.59	7.8									
	138.8	131.90	6.9									
		132.00	6.8	4+76.5								
5+00	138.7	132.09	6.6									
6+00	138.2	132.49	5.7									
	137.6	132.83	4.8									
		132.93	4.7	6+86.2	8" STUB N							
7+00	137.5	133.07	4.4									
8+00	137.4	134.10	3.3		8+15 N	8+44 S						
					8+61 N	8+95 S						
9+00	138.5	135.13	3.4		9+13 N							
	140.2	135.50	4.7									
		135.60	4.6	9+35.6		9+43 S						
10+00	141.5	137.14	4.4		9+66 N	9+94 S						
11+00	143.5	139.53	4.0		10+12 N	10+42 S						
	145.2	141.58	3.6		10+64 N	10+93 S						
		141.68	3.5	11+85.9	11+10 N	11+44 S						
					11+62 N							
12+00	145.6	141.99	3.6			11+91 S						
13+00	147.6	144.17	3.4		12+14 N	12+43 S						
14+00	149.7	146.36	3.3		12+60 N	12+89 S						
	151.4	148.23	3.2	14+85.8	13+12 N	13+40 S						
					13+58 N	13+92 S						
					14+09 N	14+38 S						
					14+61 N							
					4" STUB N							
0+00	138.8	132.00	6.8	0+00=4+76.5 LINE A								
1+00	138.3	134.09	4.2		1+32 N							
2+00	140.2	136.17	4.0		1+84 N	1+61 S						
	141.3	137.22	4.1		2+30 N	2+13 S						
		137.32	4.0	2+50.1		2+59 S						
3+00	142.3	138.28	4.0		2+82 N							
4+00	144.2	140.19	4.0		3+29 N	3+11 S						
5+00	146.2	142.12	4.1		3+80 N	3+63 S						
		142.22	4.0	5+00.7	4+31 N	4+09 S						
					4+78 N	4+60 S						
6+00	148.2	144.39	3.8		5+31 N	5+08 S						
7+00	150.1	146.57	3.5		5+77 N	5+59 S						
	151.8	148.50	3.2	7+88.7	6+28 N	6+05 S						
					6+81 N	6+57 S						
					7+26 N	7+08 S						
					7+76 N	7+55 S						

CONSTRUCTION RECORD

SERVICE RECORD

STATION	ELEVATION		Depth	MANHOLE	4-INCH "Y" BRANCHES		No. of Permit		House Number		DATE OF PERMITS	
	Ground	Grade			North West	South East	North West	South East	North West	South East	North West	South East
COLONIAL PARK III (CONT)												
LINE C 0+00	140.0	134.25	5.8	0+00=2+74.5 LINE A								
1+00	139.5	136.05	3.5		1+32 N	1+50 S						
2+00	141.3	137.85	3.5		1+78 N	1+99 S						
3+00	143.1	139.65	3.5		2+30 N	2+48 S						
	144.0	140.57	3.4	3+50.9	2+81 N	2+99 S						
					3+27 N							
						6" STUB E						
LATERAL 10 MAIN 18 WAR INDUSTRIES SEWER												
LINE A 0+00	163.8	146.02	17.8	0+00 EXISTING	0+41	0+66.6	C60271	C60272	904 Dalton	919 Buckridge	3-8-77	5-15-78
1+00	162.8	146.50	16.3		1+21	1+99	C60272	C60278	908 Dalton	923 Buckridge	3-8-77	5-11-78
2+00	163.8	146.98	16.8		1+98	2+40	C60273	C60279	910 Dalton	927 Buckridge	3-8-77	5-15-78
	164.2	147.22	17.0	2+51.0	2+84.0		C60274		914 Dalton		3-8-77	
		147.32	16.9						918 Dalton		3-8-77	
3+00	165.0	147.52	17.5		3+49.6		C60275		920 Dalton		3-8-77	
					4+25.0		C60276		924 Dalton		3-8-77	
4+00	166.2	147.92	18.3		4+72.0	3+61	C60277	C60276	925 Dalton	933 Buckridge	3-8-77	5-4-78
	166.2	148.27	17.9	4+89.4	5+64.0		C60278		922 Dalton		3-8-77	
		152.07	14.1						938 Dalton	763 Buckridge	3-8-77	5-16-78
5+00	166.2	152.13	14.1		6+25	6+10.4	C60279	C60284	944 Dalton	963 Buckridge	3-8-77	5-4-78
6+00	166.8	152.63	14.2		7+06.4		C60262		952 Dalton	963 Buckridge	3-8-77	5-4-78
7+00	168.7	153.13	15.6		7+57.4		C60263	C60234	952 Dalton	963 Buckridge	3-8-77	5-4-78
	168.8	153.52	15.3	7+83.0	8+40.0		C60264		954 Dalton		3-8-77	
		156.53	12.3		7+08.0		C60265		954 Dalton		3-8-77	
8+00	168.8	156.62	12.2		7+70.0	8+71.6	C60266	C60261	954 Dalton	1017 Burrus	3-8-77	6-26-79
					10+24		C60267		954 Dalton		3-8-77	
9+00	168.4	157.02	11.4									
10+00	168.2	157.42	10.8									
	168.2	157.58	10.6	10+40.0								
					11+21	4" SCH 40 LIT TAP 9+90.1 Predco	C60268	99-065th	1022 Dalton	1025 Burrus	3-8-77	9-2-79
11+00	167.8	157.82	10.0		11+97.0	11+59.0	C60269	13160	1027 Dalton	1029 Burrus	3-8-77	3-7-85
12+00	167.9	158.22	9.7		12+96.4	12+39.5	C60270	7866	1034 Dalton	1033 Burrus	3-8-77	4-18-83
	168.0	158.60	9.4	12+96.0					1143	1125 Hinden		9-5-80
LINE B 0+00	166.2	148.35	17.9	0+00=4+89.4 LINE A								
1+00	164.7	148.62	16.1		1+12		C60230		937 Buckridge	941 Buckridge	5-4-78	
2+00	161.0	148.87	12.1		2+02.2	1+90.3	C60065	C60232	941 Buckridge	949 Buckridge	4-25-78	5-4-78
	160.2	148.90	11.3	2+14.2					949 Buckridge		5-4-78	
LINE C 0+00	168.8	153.65	15.2	0+00=7+83.0 LINE A	0+12		C60235		960 Buckridge	4" A6S 40 3" Fall 1/2 FT	5-11-78	
1+00	167.2	154.05	13.2		1+58	1+175.4	C60235	C60222	975 Buckridge	1013 Burrus	6-15-78	8-25-78
2+00	165.5	154.45	11.1		2+04.4		C60222		1009 Burrus	1025 Burrus	4-11-85	12-17-78
	165.2	154.50	10.7	2+13.0	4" STUB NE		13446 C60221	10803	977 Buckridge	1025 Burrus	5-4-78	4-26-84
LINE D 0+00	155.3	146.60	8.7	0+00= EXISTING								
1+00	153.5	147.00	6.5		1+81.3							
	154.5	147.33	7.2									
		147.50	7.0									
2+00	153.7	147.57	6.1		2+47.7	4" STUB W	C60223		907 Buckridge		10-11-77	
	154.2	147.76	6.4				C60223					