



LATERAL 11 MAIN 18 WAR INDUSTRIES SEWER
 BUILT BY: WOODSIDE CONST. CO.
 PROJ. N^o DBKL 575045
 BOOKED 9-24-79 FROM 270Y

SCALE 1"=150'

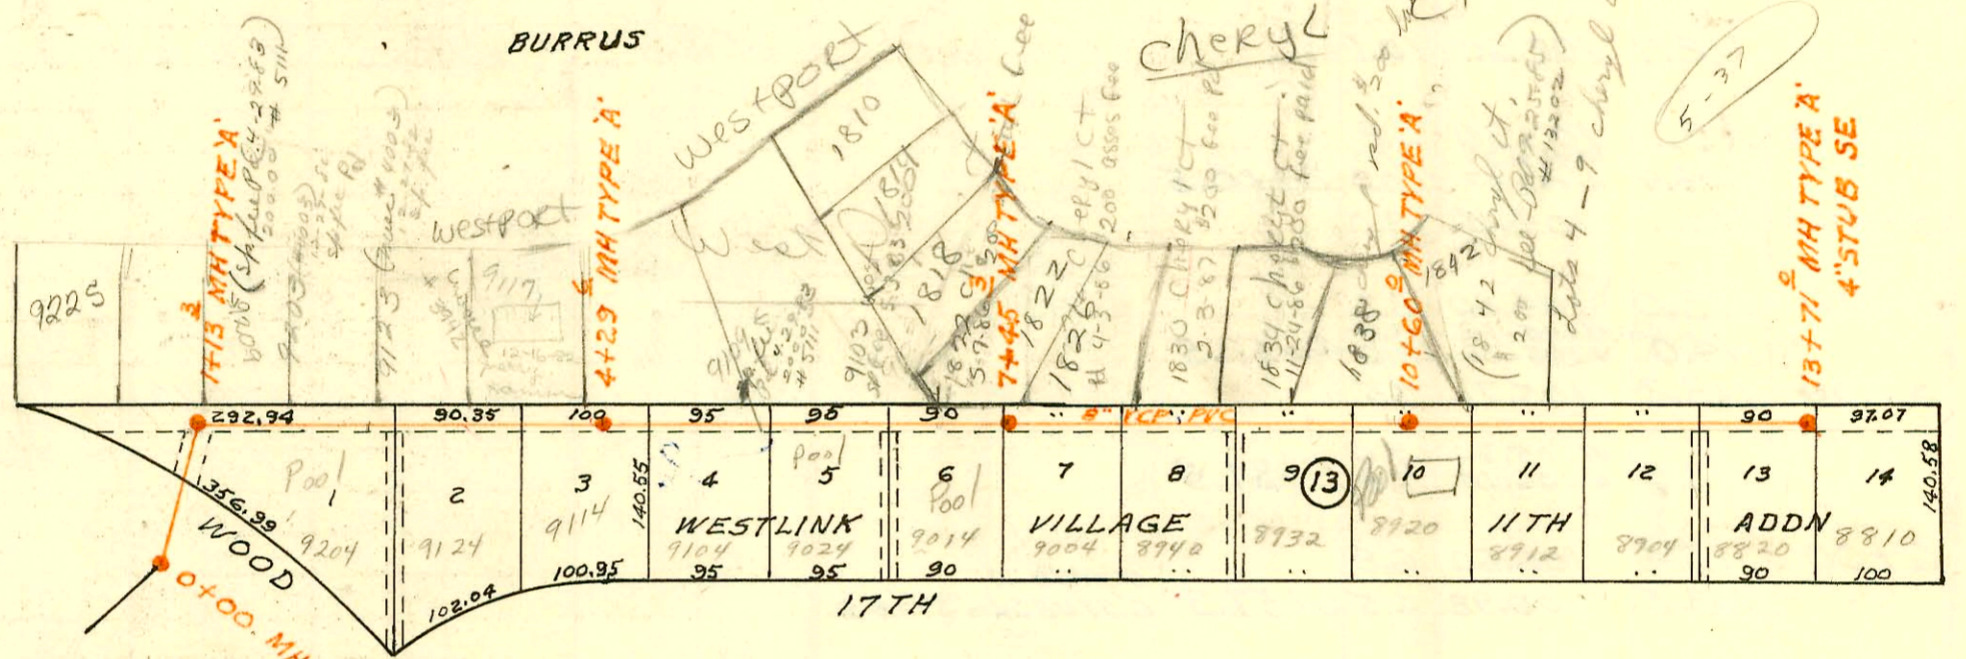

LATERAL 13 MAIN 3 WESTLINK SEWER
 BUILT BY: WOODSIDE CONST. CO.
 PROJ. N^o DBKL 574037
 BOOKED 9-28-76 FROM CLG 14

SCALE 1"=150'

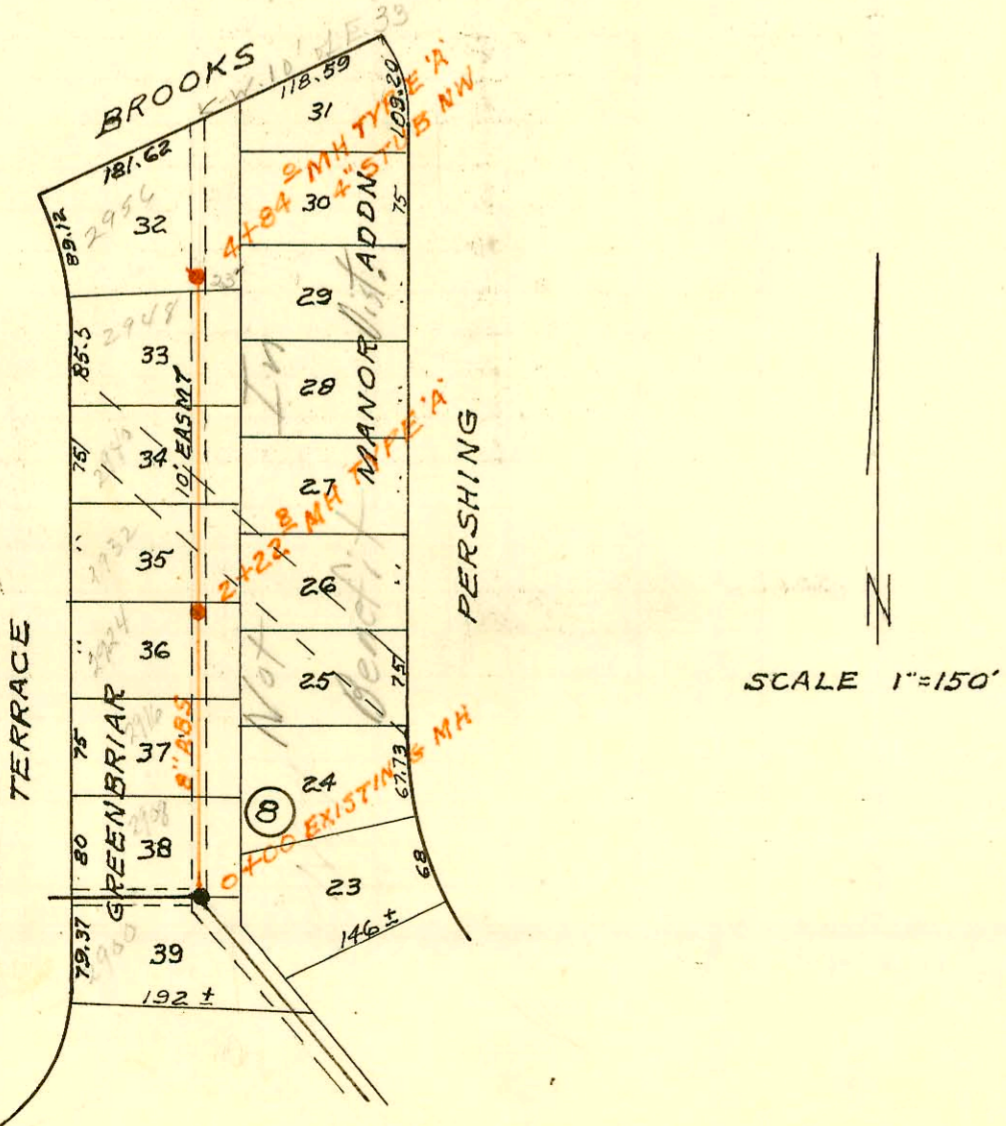

LATERAL 8 MAIN 1 SAN SEWER N^o 23
 BUILT BY: MID STATES CONST. CO.
 PROJ. N^o DBKL 576009
 BOOKED 10-5-76 FROM 1H94

SCALE 1"=150'

CONSTRUCTION RECORD

SERVICE RECORD

STATION	ELEVATION		Depth	MANHOLE	4-INCH "Y" BRANCHES		No. of Permit		House Number		DATE OF PERMITS	
	Ground	Grade			North West	South East	North West	South East	North West	South East	North West	South East
LATERAL 11 MAIN 18 W 15												
0+00	163.7	155.32	8.4	0+00								
1+00	164.8	155.79	9.0									
2+00	167.2	156.26	10.9									
	167.4	156.42	11.0	2+09.6								
3+00	167.7	156.86	10.8									
4+00	168.0	157.36	10.6									
	168.0	157.47	10.5	4+03.0								
5+00	168.2	158.06	10.1									
6+00	168.0	158.56	9.4									
7+00	167.7	159.16	8.5									
8+00	168.9	159.76	9.1									
	169.0	160.04	9.0	8+54.0								
LATERAL 13 MAIN 3 WESTLINK SEWER												
0+00	157.0	148.20	8.8	0+00								
1+00	157.3	148.80	8.5									
2+00	158.1	149.69	8.4									
3+00	159.2	150.49	8.7									
4+00	160.2	151.29	8.9									
5+00	161.7	152.37	9.3									
6+00	163.2	153.57	9.6									
7+00	165.2	154.77	10.4									
8+00	166.4	155.97	10.4									
9+00	168.0	157.17	10.8									
10+00	169.8	158.37	11.4									
11+00	170.9	159.57	11.3									
12+00	171.4	160.77	10.6									
13+00	172.0	161.97	10.0									
	172.1	162.81	9.3	13+71.0								
LATERAL 8 MAIN 1 55 N#23												
0+00	158.2	149.08	9.1									
1+00	159.3	149.28	10.0									
2+00	157.3	149.48	7.8									
3+00	153.8	149.68	4.1									
4+00	158.1	149.88	8.2									
	157.5	150.05	7.5	4+84.0								

5/10/80
 4-29-83
 \$200.00
 #311
 5/10/80
 5-2-83
 \$200.00
 #312
 Special
 7-86

#1010 (2610 W 31st St) 8-19-80 Al Henning 6199.5 N