
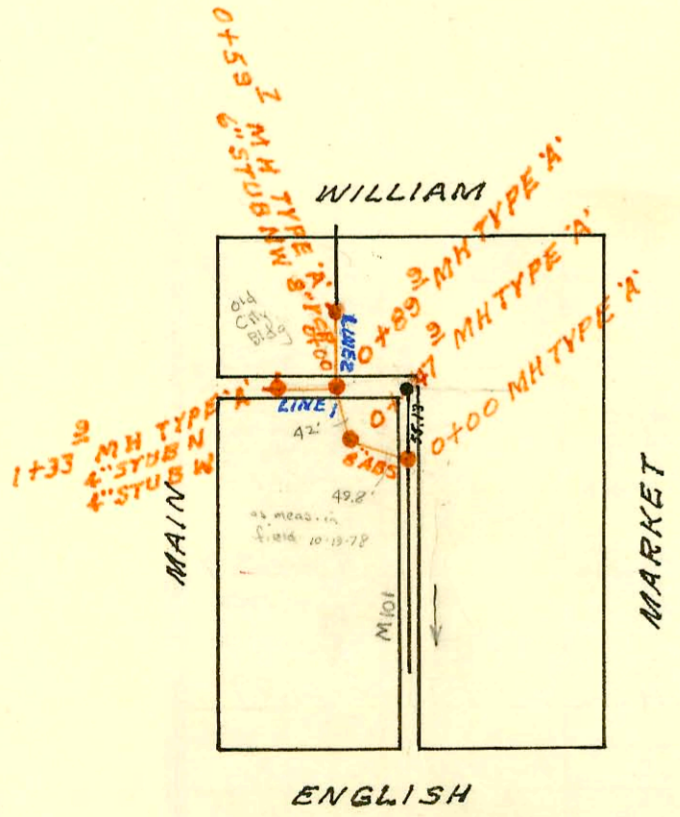


LATERAL 72 SOUTHWEST INTERCEPTOR
 BUILT BY: MID STATES CONST CO
 PROJ. N^o DBKL575005
 BOOKED 11-4-76 FROM CG15

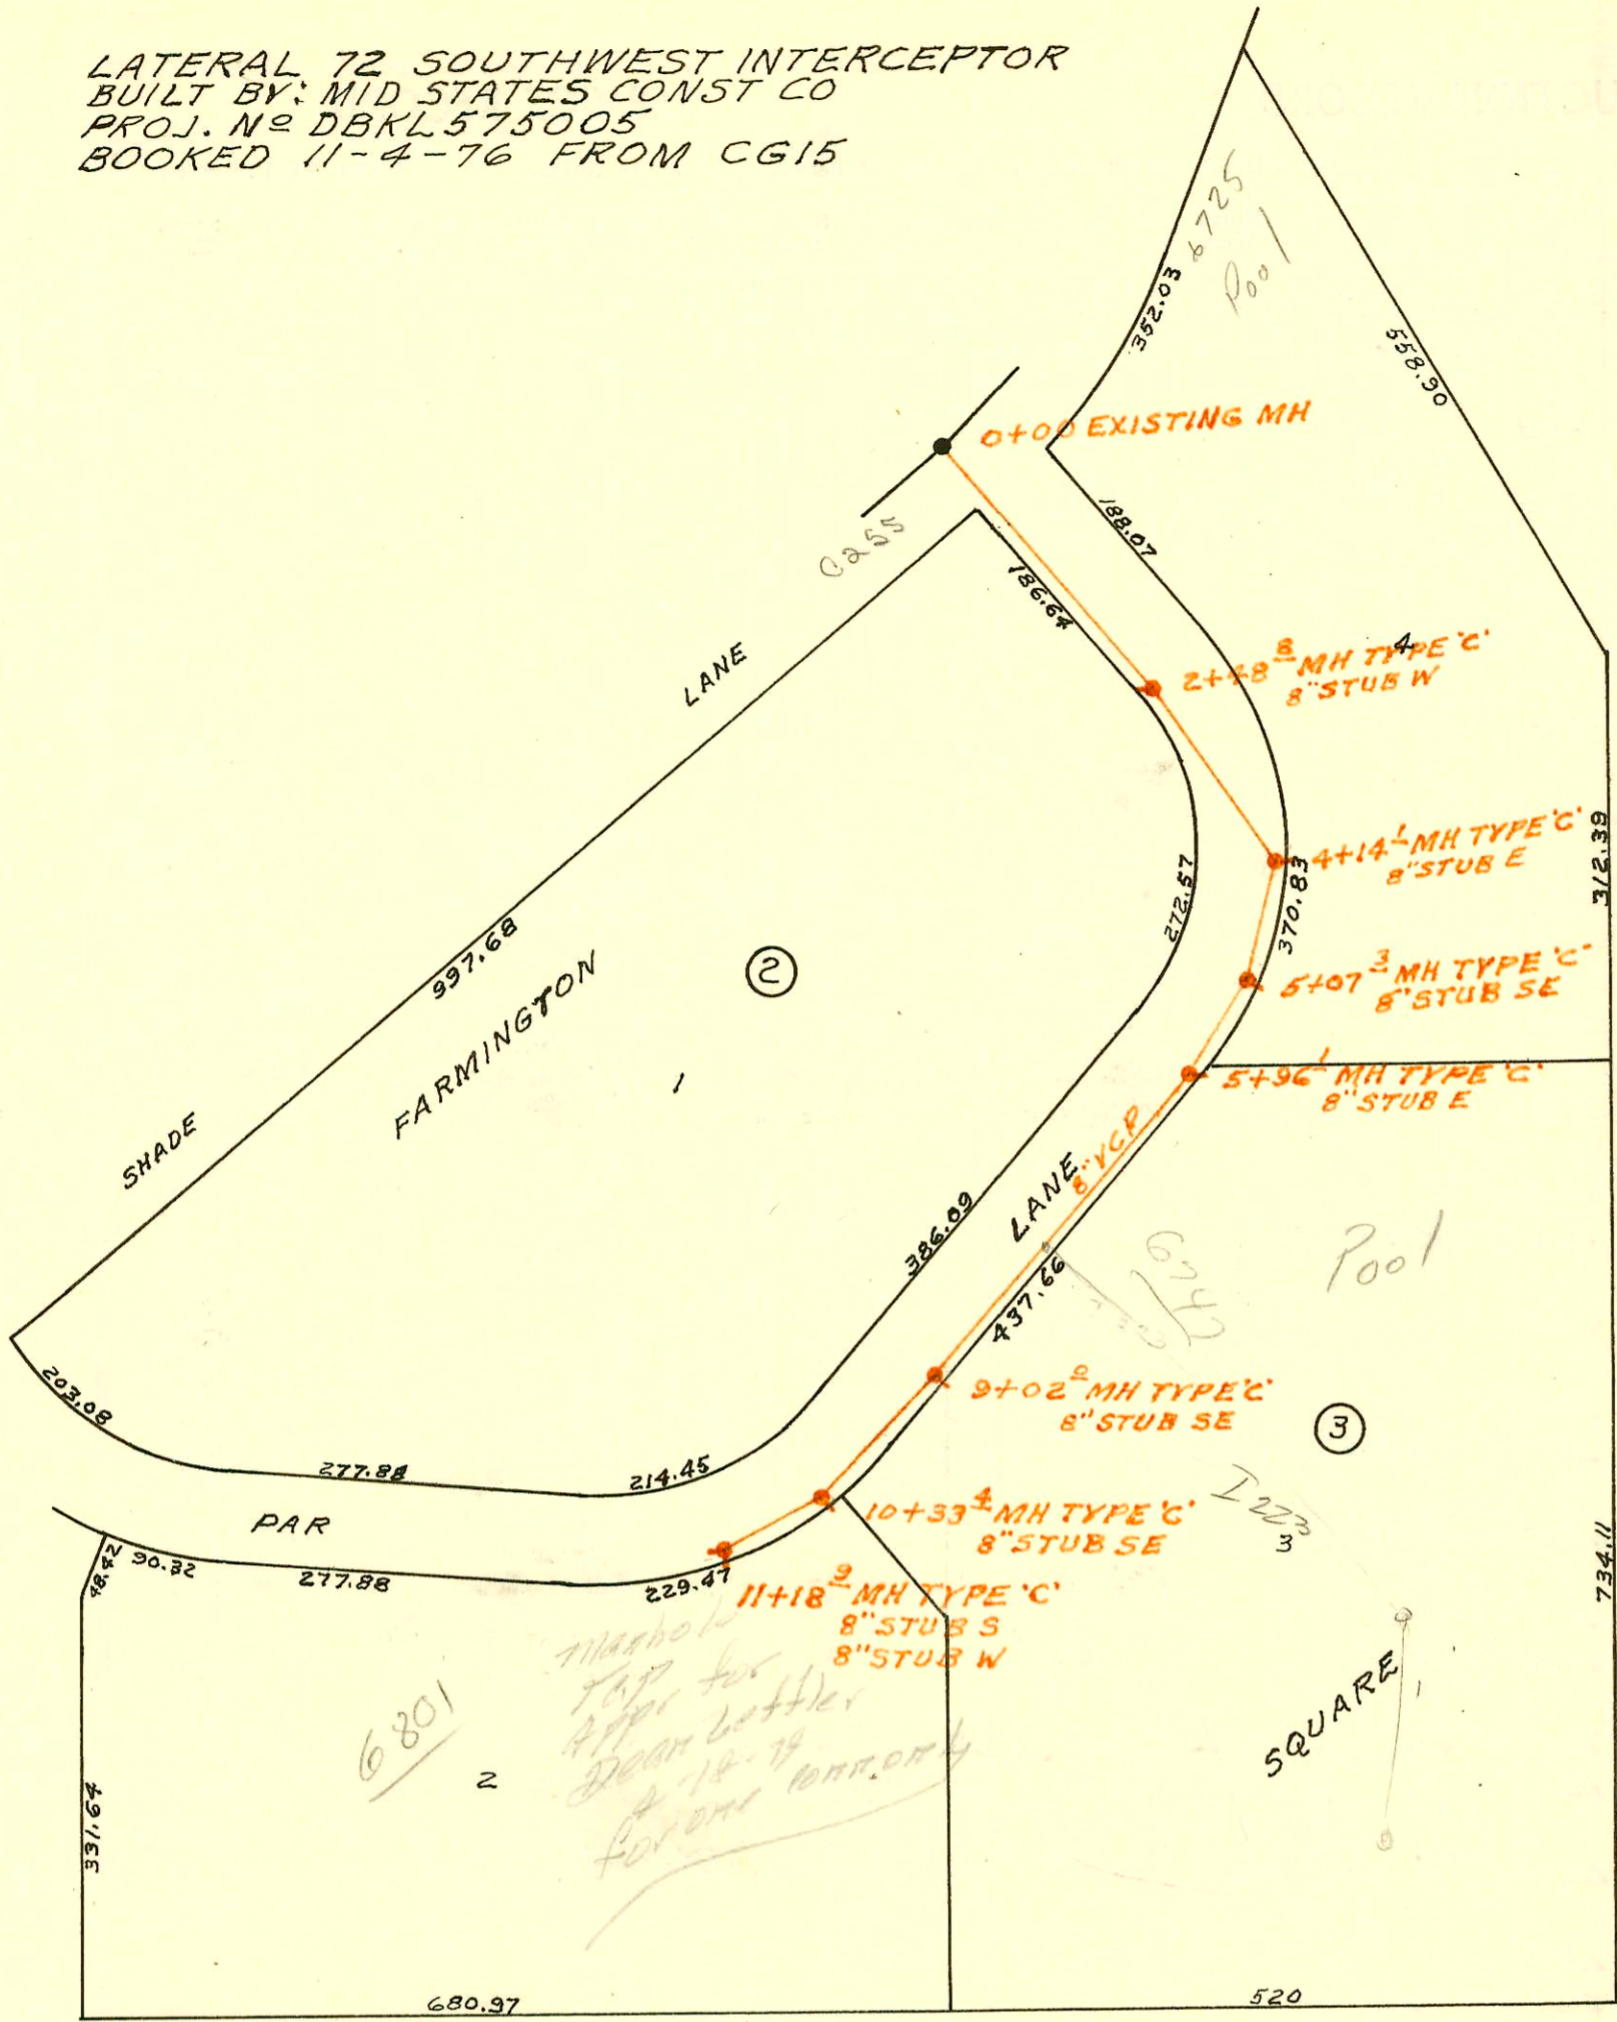

SAN SEWER RECON HERITAGE SQUARE PARK
 BUILT BY: UTILITY CONT. INC.
 PROJ. N^o WMXA517430
 BOOKED 11-5-76 FROM AR255

CONSTRUCTION RECORD						SERVICE RECORD						
STATION	ELEVATION		Depth	MANHOLE	4-INCH "Y" BRANCHES		No. of Permit		House Number		DATE OF PERMITS	
	Ground	Grade			North West	South East	North West	South East	North West	South East	North West	South East
LATERAL 72 SOUTHWEST INTERCEPTOR												
0+00	134.5	122.33	12.2	0+00 EXISTING								
1+00	136.6	122.69	13.9									
2+00	135.5	123.05	12.5									
	134.9	123.23	11.7	2+48.8	8" STUB W							
3+00	135.6	123.41	12.2									
4+00	136.2	123.77	12.4									
	136.5	124.00	12.5	4+14.1	8" STUB E							
5+00	136.4	124.41	12.0									
	136.2	124.55	11.7	5+07.3	8" STUB SE							
	135.7	125.00	10.7	5+96.1	8" STUB E							
6+00	135.7	125.12	10.6					7274				
								7273				12-29-82
7+00	136.1	125.62	10.5									
8+00	136.6	126.12	10.5									
9+00	137.6	126.62	11.0									
	137.6	126.73	10.9	9+02.0	8" STUB SE							
10+00	140.2	127.98	12.2									
	140.4	128.50	11.9	10+33.4	8" STUB SE							
11+00	141.1	129.33	11.8									
	141.2	129.52	11.7	11+18.9	8" STUB W							
					8" STUB S							
					11+06.2							
SANITARY SEWER RECON HERITAGE SQUARE PARK												
LINE 1												
0+00	114.00	105.85	8.2	0+00								
	112.5	106.07	6.4	0+47.9								
	112.6	106.17	6.4	0+89.9								
1+00	111.5	106.22	5.3									
	111.5	106.38	5.1	1+33.9								
LINE 2												
0+00	112.6	106.27	6.3	0+00 = 0+89.9 LINE 1								
	112.0	107.08	4.9	0+59.7								
97-10983-7	7-297	6801	w PAR	Bldg # 11	-	Alvin Henning	=	Installed	CO			
98-3180-7	3-5-98	6801	w PAR	Bldg # 8	-	Henning	=					
98-3181-7	3-3-98	6801	w PAR	Bldg # 11	-	Henning	=					