



LATERAL 24 MAIN 4 SWI
BUILT BY: UTILITY CONTR. INC.
PROJ. N^o DBKL 576031
BOOKED 1-6-77 FROM G2

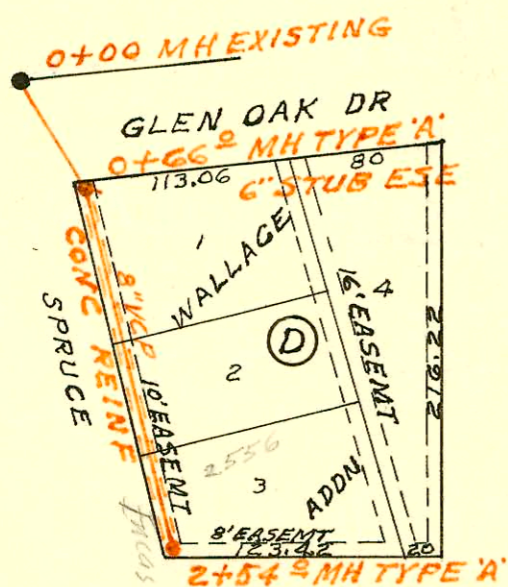

SCALE 1"=100'

LATERAL 23 DIST AS SS N^o 12
BUILT BY: UTILITY CONTR. INC.
PROJ. N^o DBKL 576044
BOOKED 1-7-77 FROM SRL 2

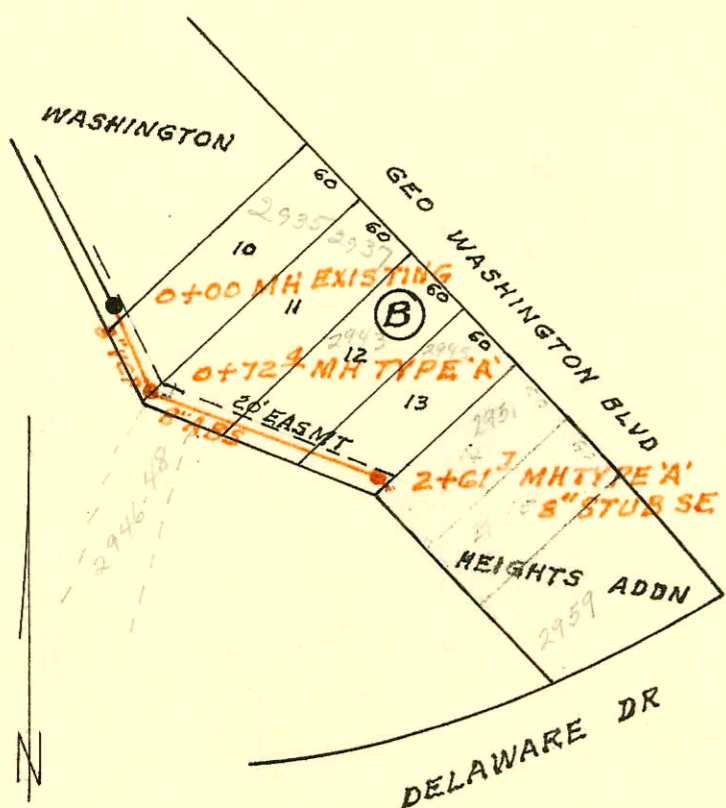


SCALE 1"=150'

LATERAL 15 MAIN 10 WAR INDUSTRIES SEWER
BUILT BY: UTILITY CONTR. INC.
PROJ. N^o DBKL 576049
BOOKED 1-7-77 FROM SRL 5


SCALE 1"=150'

Handwritten notes:
1/2 Fee in 4/24
Due for
2/4 Chris
2/24
LOT 1 BUY
CHRISTINE ST
This lot
Not incl in
Blk for Lot 24
Main 4 or
for Lot 14
Main 4 K 232, 1/10
The fee of
1,968.00
per 6' curb
3/17/77

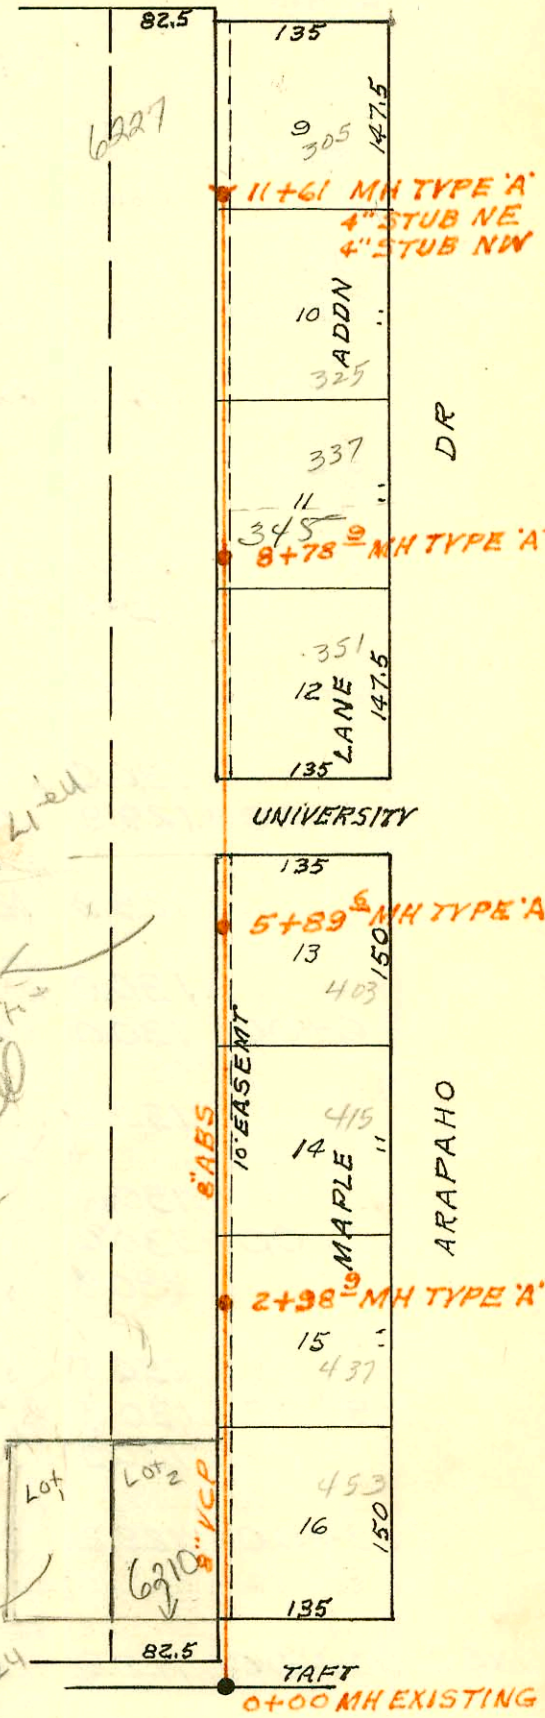

SCALE 1"=150'

LANGLAND ADDN SAN SEWER
BUILT BY: UTILITY CONTR. INC.
PROJ. N^o DBKL 706042
BOOKED 1-7-77 FROM DCD 26

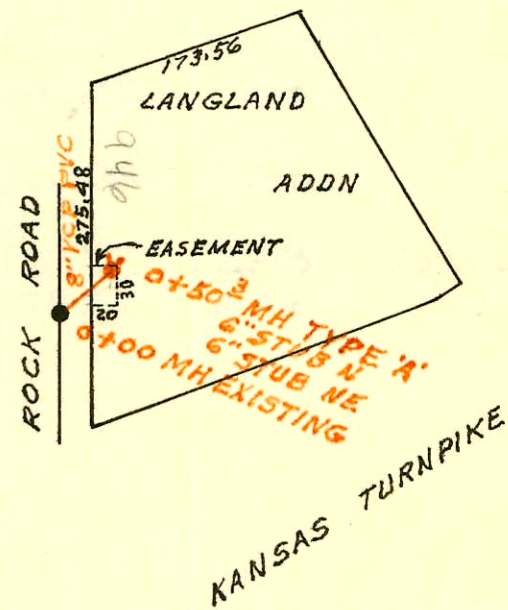

on map

CONSTRUCTION RECORD

SERVICE RECORD

STATION	ELEVATION		Depth	MANHOLE	4-INCH "Y" BRANCHES		No. of Permit		House Number		DATE OF PERMITS			
	Ground	Grade			North West	South East	North West	South East	North West	South East	North West	South East	North West	South East
LATERAL 24 MAIN 4 SOUTHWEST INTERCEPTOR														
0+00	118.7	109.32	9.4	EXISTING										
1+00	119.5	109.72	9.8		TAP 1+19.7	978141	C69116	6210 TAP	453 Arapaho	52497	10-27-78			
2+00	119.5	110.12	9.4											
	119.5	110.52	9.0	2+98.9										
3+00	119.5	110.52	9.0		2+20.4		C59177		437 Arapaho		12-20-76			
4+00	119.6	110.92	8.6											
5+00	120.0	111.32	8.7		4+16.0		C59203		415 Arapaho		12-21-76			
	119.9	111.68	8.2	5+89.6										
6+00	119.9	111.72	8.2		6+06.6		C75719		403 S Arapaho		12-13-79			
7+00	120.1	112.12	8.0		7+32.9		C75722		351 S Arapaho		12-13-79			
8+00	120.0	112.52	7.5											
	120.3	112.84	7.5	8+78.9	8+88.9 TAP		17603		345 Arapaho		1-6-87			
9+00	120.4	112.92	7.5		9+46.8		C66280		334 Arapaho		5-11-78			
10+00	120.4	113.32	7.1		10+66.1		C65189		325 Arapaho		3-1-78			
11+00	120.5	113.72	6.8											
	120.5	113.97	6.5	11+61.0	4" STUB NW	4" STUB NE	C59753	C59400	6227 W. Maple	303 Arapaho	1-7-77			
LATERAL 23 DIST AS SS N#12														
0+00	95.0	90.61	4.4	EXISTING										
1+00	94.7	90.74	4.0	0+66.0	6" STUB ESE									
2+00	93.6	91.01	2.6		1+50 6"E									
	93.3	91.12	2.2	2+54.0	2+05.5 6"E		C63377		2556 S Spruce		10-5-77			
LATERAL 15 MAIN 10 WAR INDUSTRIES SEWER														
0+00	139.3	129.50	9.8	EXISTING	TAP 0+25.6		C59607		2935 Des Wash Blvd		1-25-77			
	140.7	130.22	10.5	0+72.4										
1+00	141.5	130.72	10.8		TAP 0+75.4		C59608		2937 Des Wash Blvd		1-25-77			
2+00	143.4	132.32	11.1		1+50.7		C59967		2943 Des Wash Blvd		2-16-77			
	143.7	133.38	10.3	2+61.7	8" STUB SE		C59968		2945 Des Wash Blvd		2-16-77			
LANGLAND ADDN SAN SEWER														
0+00	133.5	128.38	4.6	EXISTING										
	138.8	128.88	9.9	0+50.3	6" STUB N 6" STUB NE	14 TAP	12893	17438	946 S Rock Rd	946 S Rock Rd	10-26-84	12-11-86		