



DON YORK 2ND ADDN SAN SEWER
 BUILT BY: MID STATES CONST. CO.
 PROJ. NO DBKW 705070
 BOOKED 1-10-77 FROM G6

on map

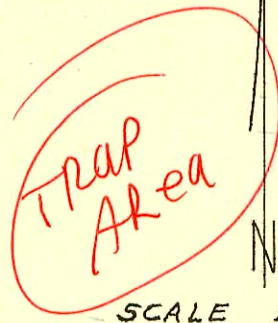


SCALE 1"=150'

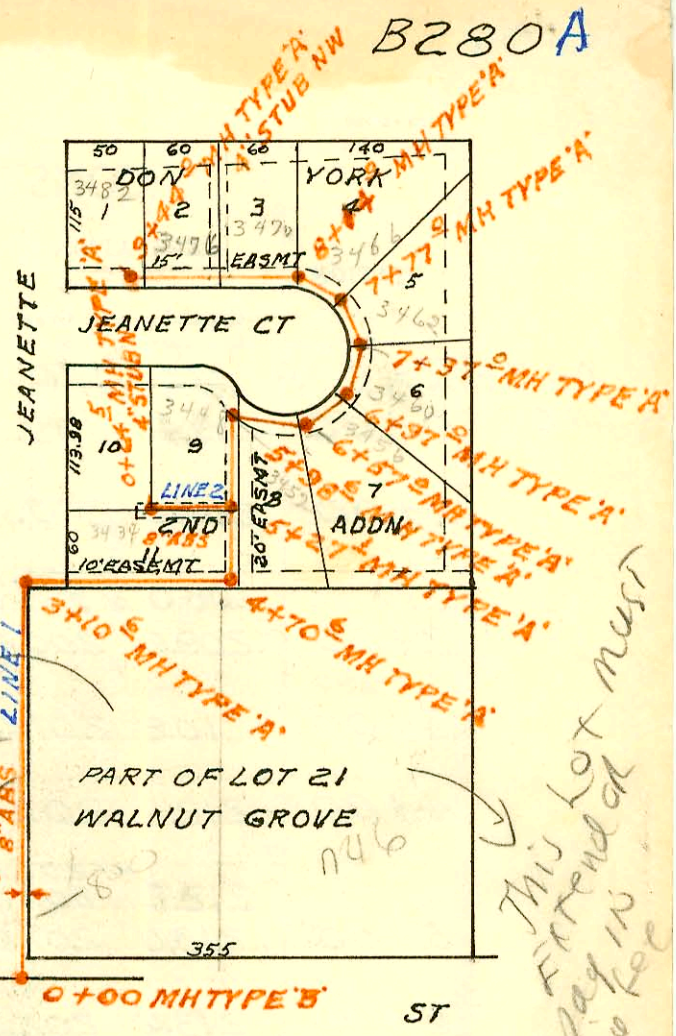

LATERAL 41 MAIN 1 SWI
 BUILT BY: MID STATES CONST. CO.
 PROJ. NO DBKL 575035
 BOOKED 1-10-77 FROM 1H84

on map

SCALE 1"=150'

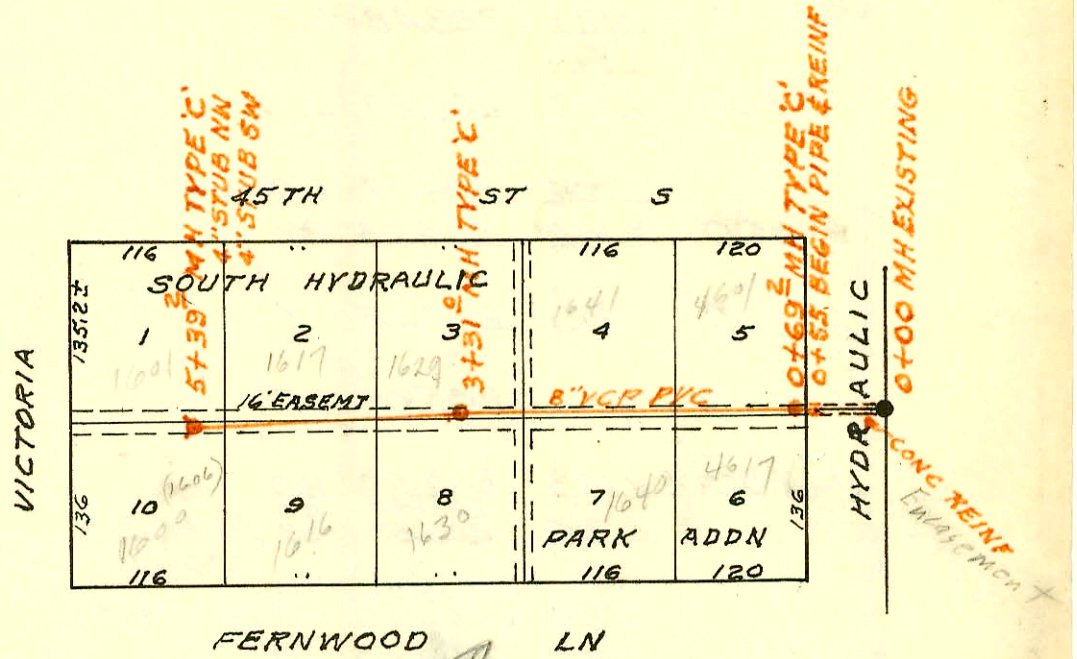

possible water problem in this area per drawing 20,306 BK

CONSTRUCTION RECORD

SERVICE RECORD

STATION	ELEVATION		Depth	MANHOLE	4-INCH "Y" BRANCHES		No. of Permit		House Number		DATE OF PERMITS	
	Ground	Grade			North West	South East	North West	South East	North West	South East	North West	South East
DON YORK 2ND ADDN SAN SEWER												
LINE 1 0+00	132.4	123.06	9.3	0+00								
1+00	131.6	123.31	8.3									
2+00	131.0	123.56	7.4									
3+00	130.0	123.81	6.2									
	128.5	OUT 123.84 IN 123.94	4.7 4.6	3+10.6								
4+00	130.2	124.16	6.0									
	130.0	OUT 124.34 IN 124.43	5.7 5.6	4+70.6								
5+00	129.9	124.51	5.4									
	129.9	124.58	5.3	5+27.1	5+23.5		C59370		3434 Jeanette		2-17-77	
	130.0	OUT 124.76 IN 124.86	5.2 5.1	5+98.6	5+44.0		C59371		3448 Jeanette		2-19-77	
6+00	130.0	124.86	5.1									
	130.3	125.00	5.3	6+57.0	6+51.0		C59372		3452 Jeanette Ct		2-17-77	
	130.6	125.10	5.5	6+97.0	6+81.5		C59373		3456 Jeanette Ct		2-18-77	
7+00	130.6	125.11	5.5									
	130.8	125.20	5.6	7+37.0	7+24.5		C59374		3460 Jeanette Ct		2-18-77	
	130.5	125.30	5.2	7+77.0	7+57.2		C58891		3462 Jeanette Ct		7-26-76	
8+00	130.8	125.36	5.4									
	130.3	125.39	4.9	8+14.0	8+20.1		C56888		3460 Jeanette		7-26-76	
	129.2	125.61	3.6		8+68.6		C56889		3470 Jeanette Ct		7-26-76	
9+00	129.2	125.72	3.5	9+44.0	8+87.2		C56890		3476 Jeanette Ct		7-26-76	
				4" STUB NW			C56887		3482 Jeanette Ct		7-26-76	
LINE 2 0+00	129.9	124.68	5.2	0+00 = 5+27.1 LINE 1								
	130.0	124.84	5.2	0+64.5	4" STUB N							
LATERAL 41 MAIN 1 SOUTHWEST INTERCEPTOR												
0+00	84.14	70.44	13.7	EXISTING								
1+00	84.2	70.91 74.00	13.3 10.2	0+69.2								
1+00	84.2	74.12	10.1		1+08.2		10741	24173	1601 S Hydraulic	4617 Hydraulic	4-18-84	10-27-87
2+00	84.8	74.52	10.3									
	84.0	74.92	9.1		2+24.5	2+14.2	C10882	C59580	1641 W. 45th St	1640 Farnwood	3-26-79	1-25-77
3+00	84.0	75.04	9.0	3+31.0								
	84.0	75.04	9.0		3+48		C59570	C59588	1630 Farnwood		1-24-76	
4+00	84.1	75.32	8.8		4+04.5				1629 E. 45th St		1-24-77	
	84.5	75.72	8.8		4+76.7	4+61.7	C59647	C59630	1617 E. 45th St	1616 Farnwood	1-27-77	1-26-77
5+00	84.6	75.87	8.7	5+39.2	4" STUB NW	4" STUB SW	C59646	C67379	1601 E. 45th St	1600 (1606) Farnwood	1-27-77	7-14-78