


SERVICE RECORD


CONSTRUCTION RECORD

US 54 HIGHWAY

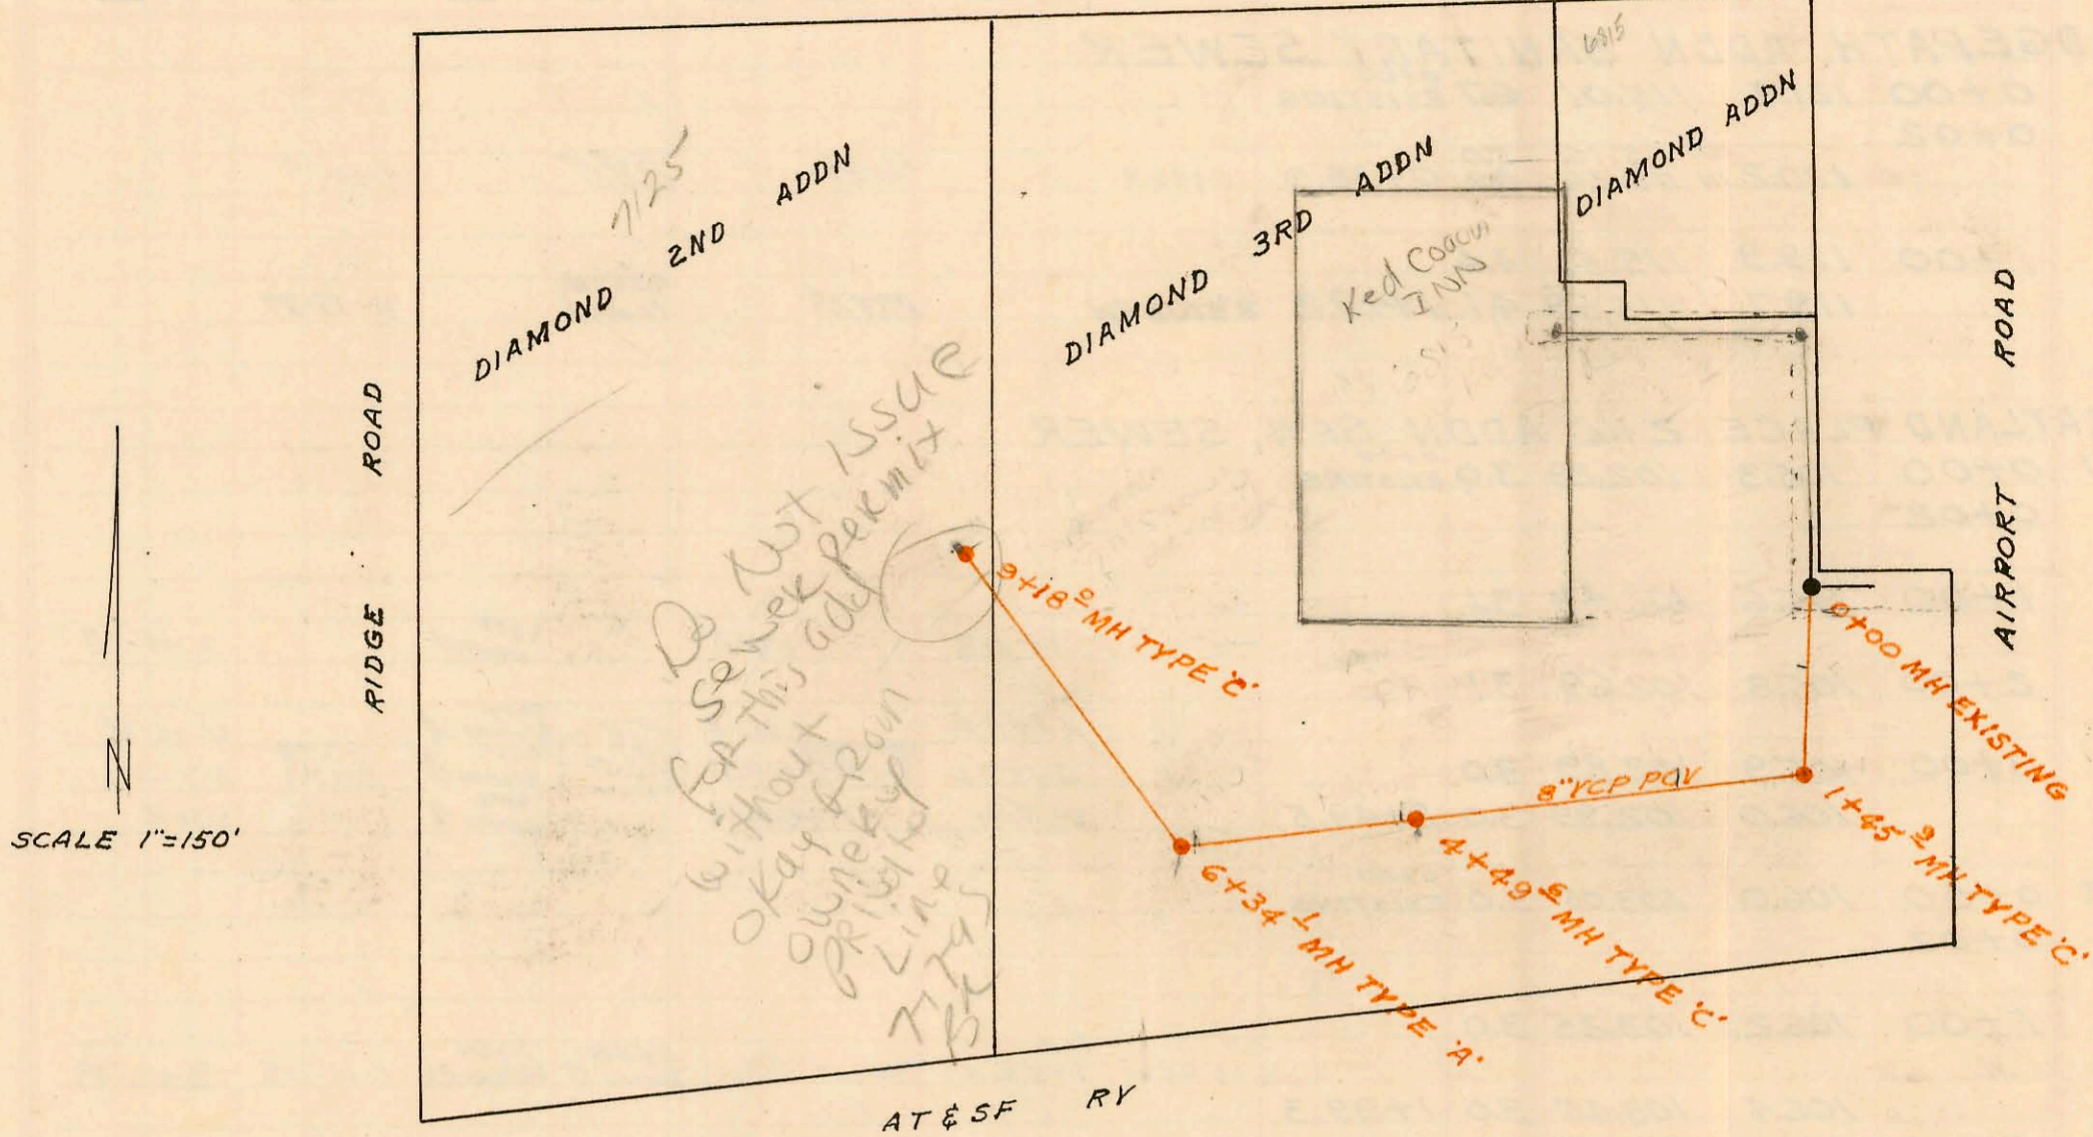

SCALE 1"=150'

DIAMOND MOTOR INN SAN SEWER
 BUILT BY: MID STATES CONST. CO.
 PROJ. N^o DBKW 706022
 BOOKED 3-1-77 FROM LER 7

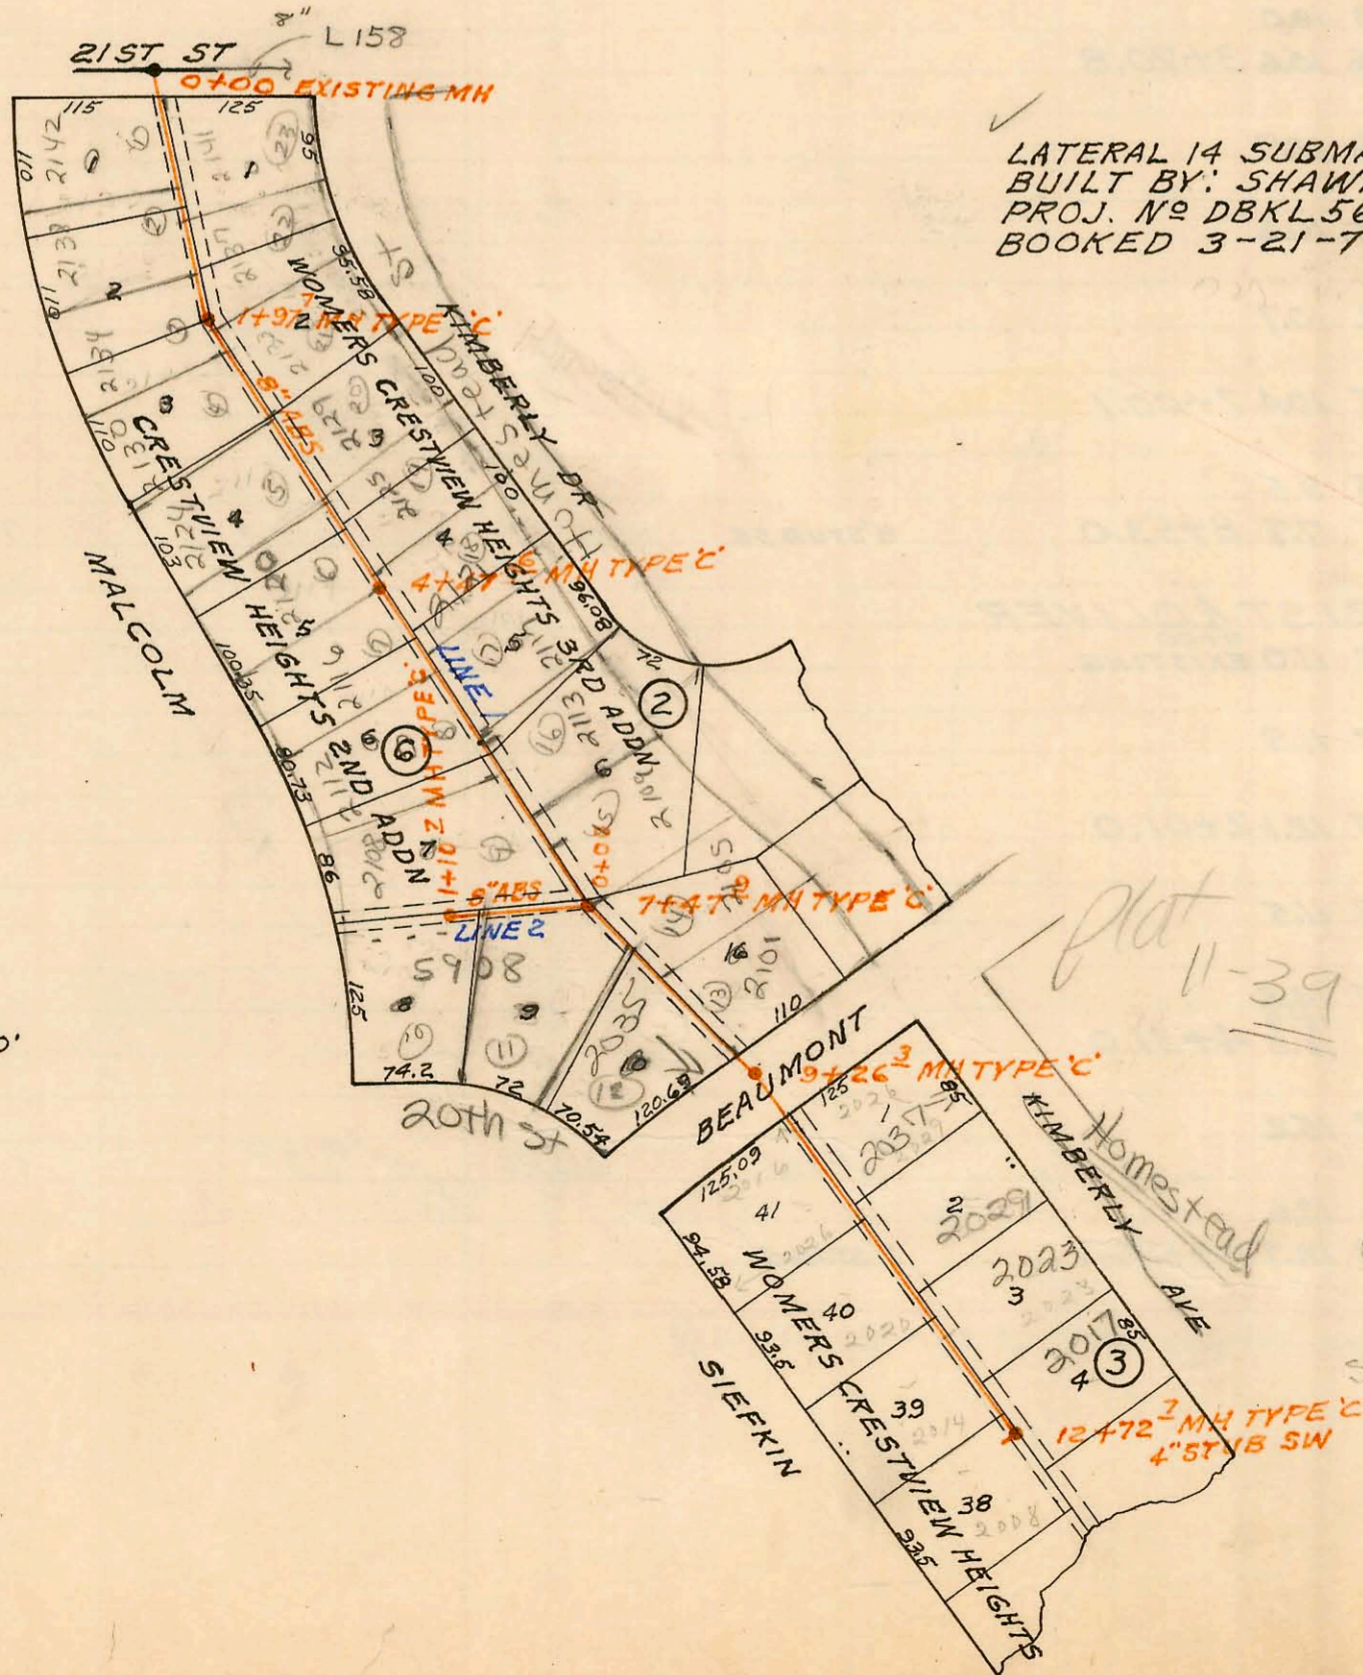

SCALE 1"=150'

LATERAL 14 SUBMAIN 5 SS N^o23
 BUILT BY: SHAWNEE CONST. CO.
 PROJ. N^o DBKL 566043
 BOOKED 3-21-77 FROM 1H77

Plot 11-39

