


West St
SCALE 1"=300'

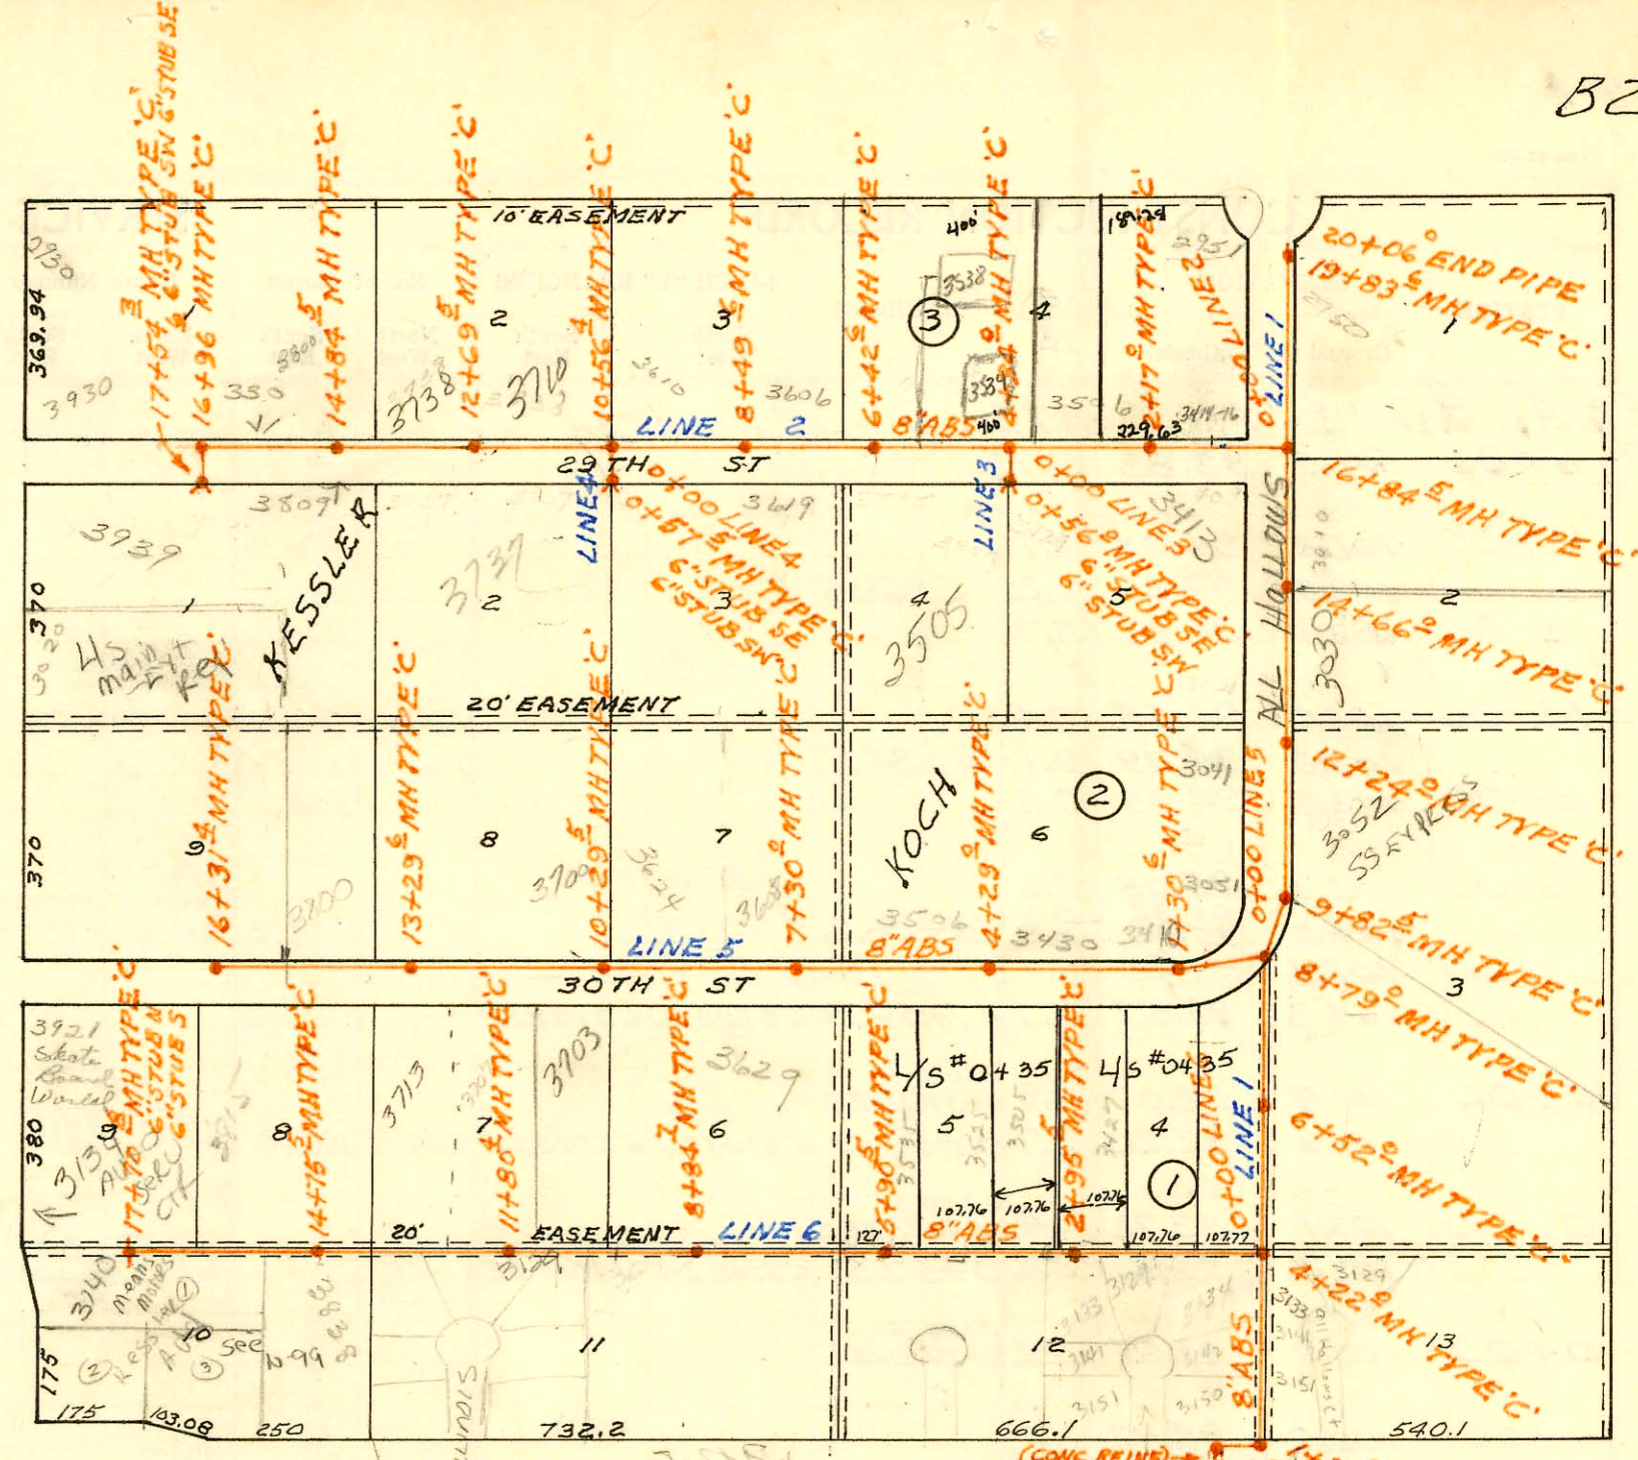

See Book C-288 for Comd. Map of 31st St


LATERAL 80 SOUTHWEST INTERCEPTOR
BUILT BY: MID STATES CONST. CO.
PROJ. N^o DBKL 575072
BOOKED 4-5-77 FROM AR 755

CONSTRUCTION RECORD

SERVICE RECORD

STATION	ELEVATION		Depth	MANHOLE	4-INCH "Y" BRANCHES		No. of Permit		House Number		DATE OF PERMITS	
	Ground	Grade			North West	South East	North West	South East	North West	South East	North West	South East
LATERAL 80 SOUTHWEST INTERCEPTOR												
LINE 1	0+00	99.4	86.00	13.4	0+00 EXISTING							
	0+02	99.4	86.08	13.3								
		99.7	86.20	13.5								
			86.30	13.4	0+51.6							
	1+00	100.0	86.42	13.6								
		100.0	86.47	13.5								
			86.57	13.4	1+21.3	1+55.2	1+65.3	266059	3141	3150	7-27-81	4-25-78
	2+00	100.2	86.77	13.4		2+42.8	2+63.9	261076	3142	3151	11-17-77	
									3786	3151		7-27-81
	3+00	100.3	87.15	13.2						3134		11-14-77
						3+32.7		063972		3134		
	4+00	100.0	87.27	12.7								
		99.9	87.33	12.6								
			87.43	12.5	4+22.0							
	5+00	100.0	87.62	12.4								
	6+00	100.0	87.87	12.1								
		100.1	88.00	12.1	6+52.0							
	7+00	100.2	88.12	12.1								
	8+00	100.3	88.37	11.9								
		100.9	88.57	12.3								
			88.67	12.2	8+79.0							
	9+00	100.7	88.72	12.0								
		101.0	88.93	12.1								
			89.03	12.0	9+82.5							
	10+00	101.1	89.07	12.0								
	11+00	101.3	89.32	12.0								
	12+00	101.7	89.57	12.1					98194307	3952		10-13-78
		101.7	89.63	12.1	12+24.0					All Hollows		
	13+00	102.2	89.82	12.4								
	14+00	102.7	90.07	12.6								
		102.7	90.24	12.5	14+66.0	4" SDR 35	14+18 TAP		911477	3039		4-24-81
	15+00	102.5	90.32	12.2						All Hollows		
										3010		5-14-80
	16+00	102.3	90.57	11.7								
		101.6	90.78	10.8								
			90.88	10.7	16+84.5							
	17+00	101.5	90.92	10.6								
	18+00	101.6	91.17	10.4								
	19+00	101.6	91.42	10.2								
		102.1	91.63	10.5	19+83.6				976247	3950		4-18-77
	20+06	102.2	91.69	10.5						All Hollows		
LINE 2												
	0+00	101.6	90.88	10.7	0+00 = 16+84.5 LINE 1							
	1+00	101.0	91.13	9.9		4" SDR 35	1+18.6 TAP					
	2+00	101.4	91.38	9.9								
		101.5	91.43	10.1	2+17.0							
	3+00	101.7	91.63	10.1								
	4+00	102.0	91.88	10.1								
		101.9	92.07	9.8	4+34.0							
	5+00	101.6	92.23	9.4								
	6+00	101.4	92.48	8.9								
		102.3	92.59	9.7	6+42.6	6+16.6 TAP						
	7+00	101.4	92.73	8.7								
	8+00	101.2	92.98	8.2								
		101.5	93.10	8.4	8+49.6							
	9+00	101.7	93.23	8.5								
	10+00	101.0	93.48	7.5								
		103.1	93.62	9.5								
			93.92	9.4	10+56.4	10+19.5 TAP	10+26 TAP		11651	3610 W		8-1-84
									18181	3710 W		4-22-87

(CONT'D NEXT PAGE)

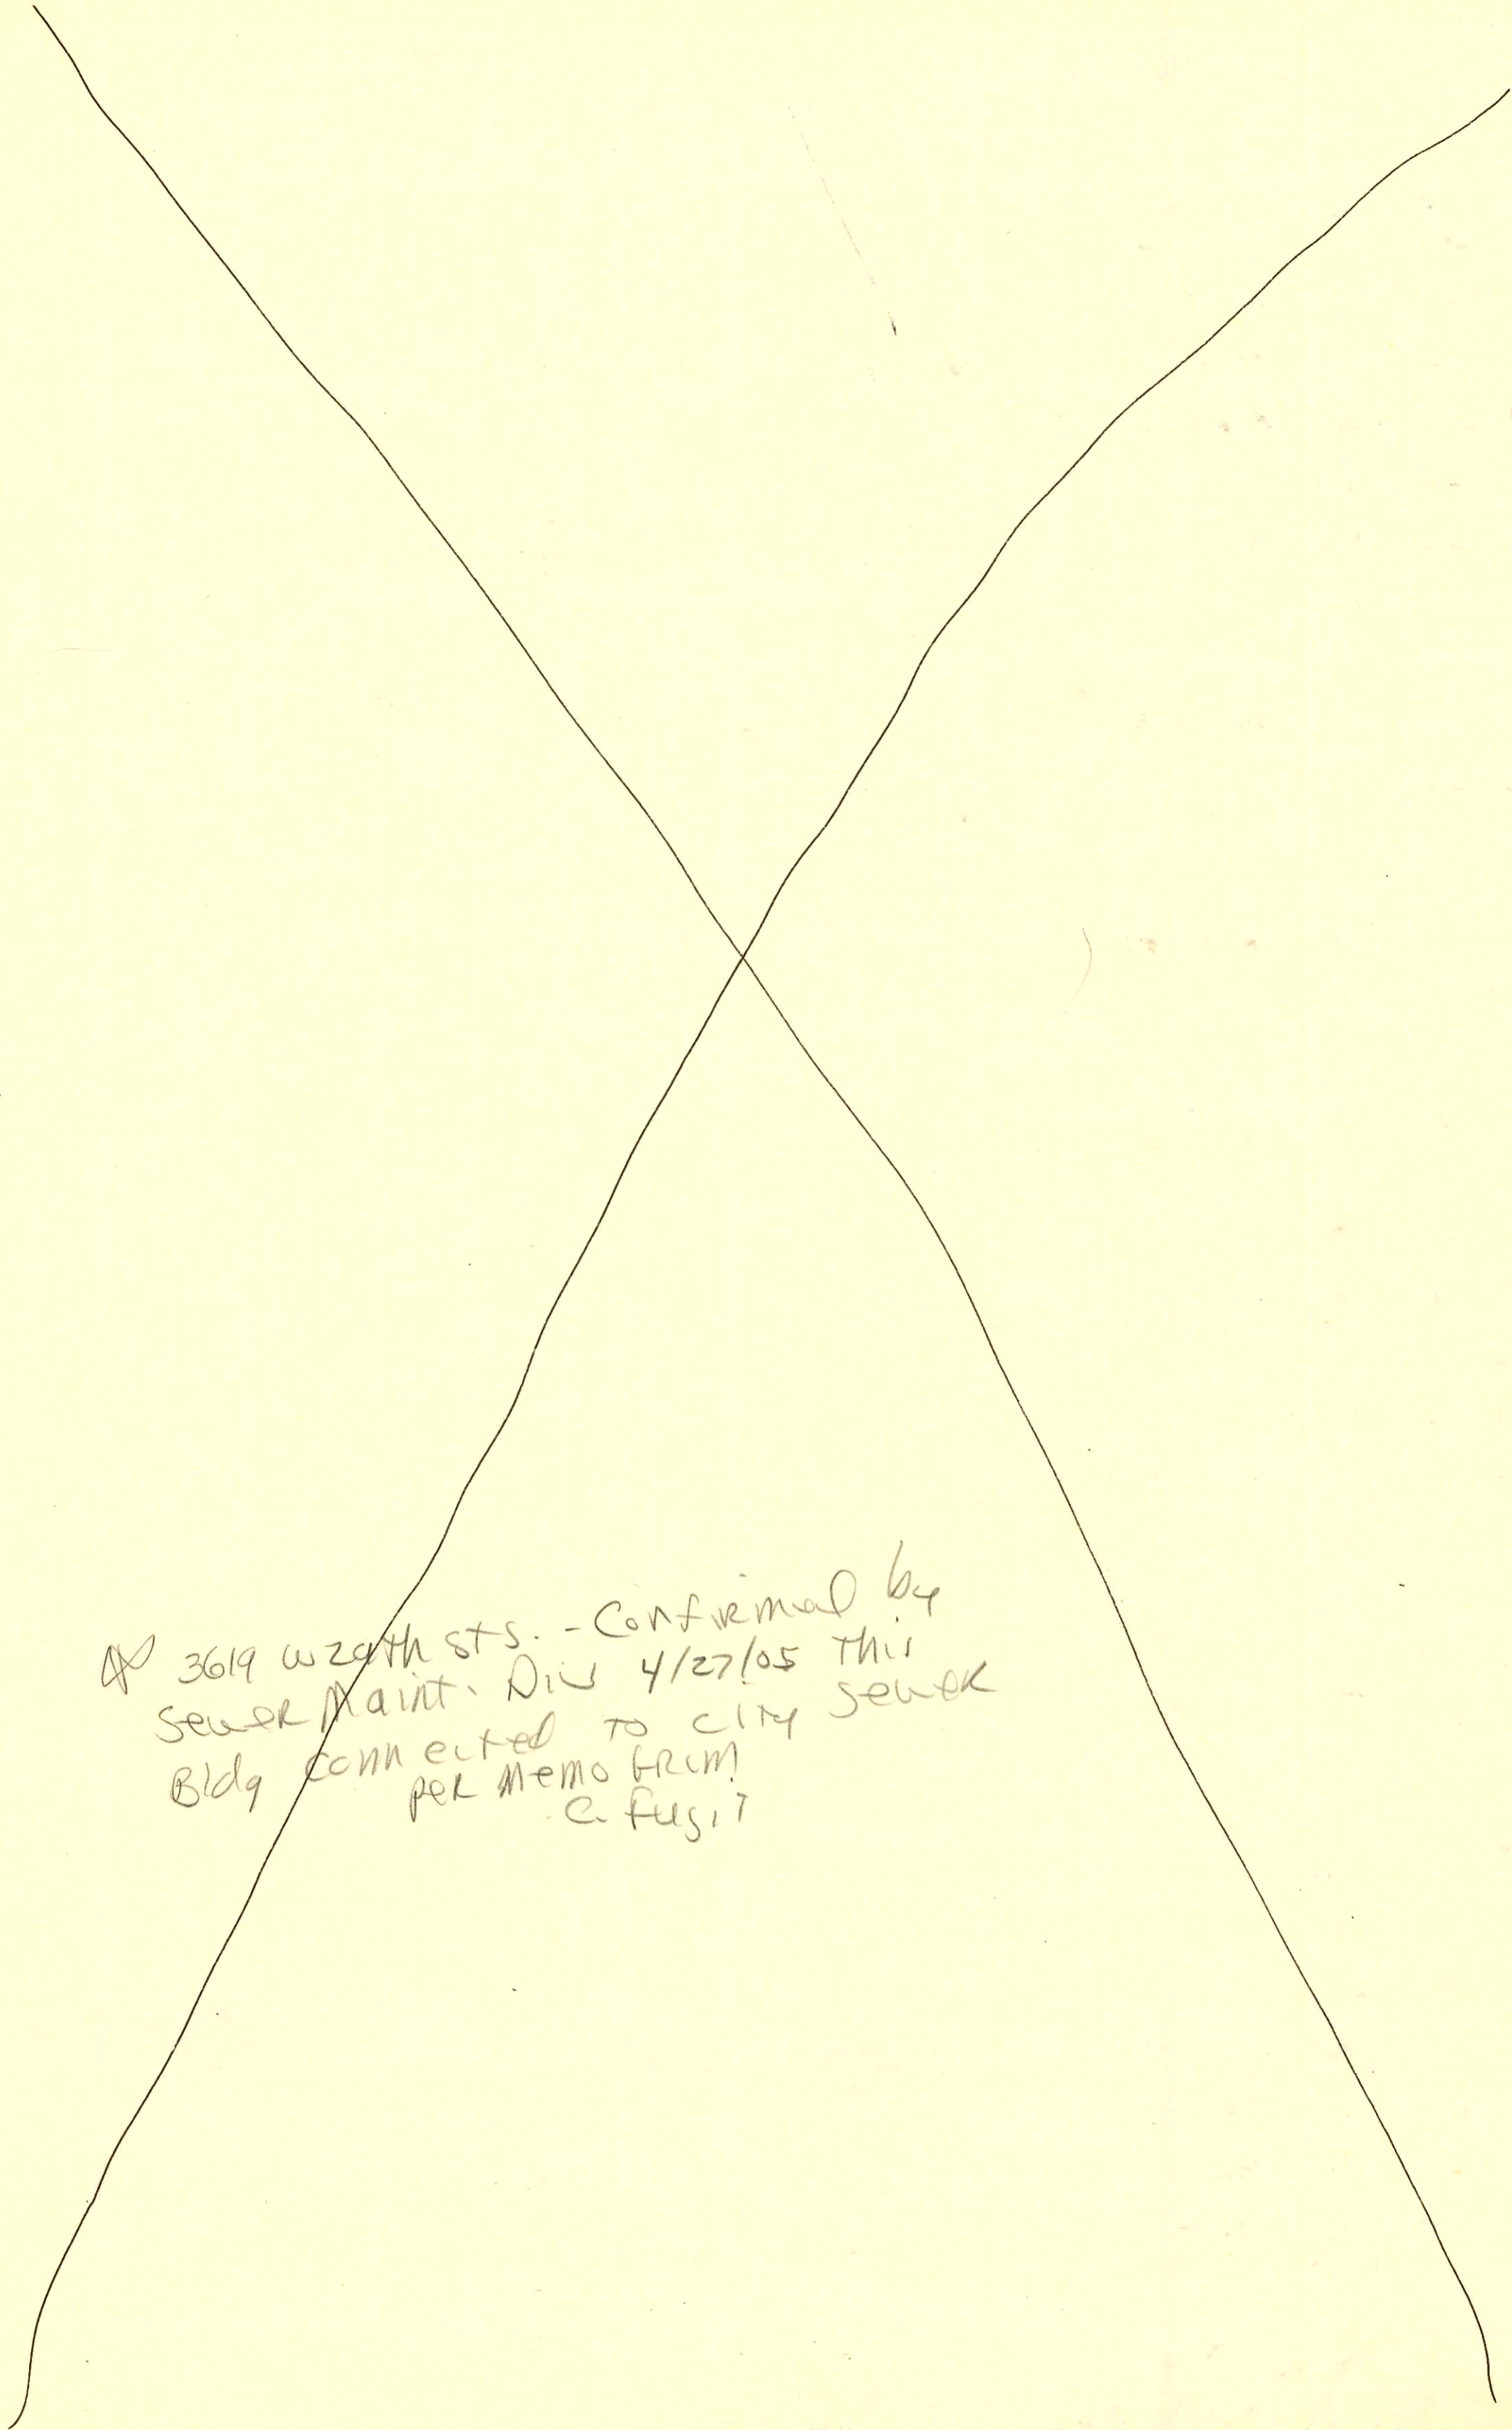

3619 W 29th Sts. - Confirmed by
Sewer Maint. Div 4/27/05 this
Bldg connected to city sewer
per memo from
C. Fusit

CONSTRUCTION RECORD

SERVICE RECORD

STATION	ELEVATION		Depth	MANHOLE	4-INCH "Y" BRANCHES		No. of Permit		House Number		DATE OF PERMITS	
	Ground	Grade			North West	South East	North West	South East	North West	South East	North West	South East
LATERAL 80 SW1 (Cont)												
LINE 2 CONT 11+00	101.5	93.83	7.7									
12+00	101.8	94.08	7.7									
13+00	103.5	94.26	9.2	12+69.5								
14+00	102.0	94.33	7.7									
15+00	102.0	94.58	7.4									
16+00	103.9	94.79	9.1	14+84.5								
17+00	102.6	94.83	7.8									
16+00	102.7	95.08	7.6									
17+00	104.3	95.32	9.0	16+96.6								
17+00	102.8	95.42	8.9									
17+00	104.3	95.57	8.7	17+54.3	6" STUB SW	6" STUB SE						
LINE 3 0+00	101.9	92.07	9.8	0+00 = 4+34 LINE 2								
0+00	101.9	92.20	9.7	0+56.0	6" STUB SW	6" STUB SE	45-25249	15578	3505 W 29th S	3413 W 29th S	9-24-93	2-5-86
LINE 4 0+00	103.1	93.72	9.4	0+00 = 10+56 LINE 2								
0+00	103.1	93.86	9.2	0+57.5	6" STUB SW	6" STUB SE	13986	?	3737 W 29th S	3619 W 29th S	6-12-85	?
LINE 5 0+00	100.9	88.67	12.2	0+00 = 8+79 LINE 1								
1+00	100.6	88.92	11.7									
2+00	101.3	89.10	12.2	1+30.6	1+11.1				3410 W 30th S		7-20-79	
3+00	100.4	89.27	11.1									
4+00	100.2	89.52	10.7									
5+00	100.2	89.77	10.4									
6+00	101.8	89.85	12.0	4+29.0								
7+00	100.3	90.02	10.3									
8+00	100.5	90.27	10.2									
9+00	100.9	90.52	10.4									
10+00	102.4	90.60	11.8	7+30.0								
11+00	101.1	90.77	10.3									
12+00	101.1	91.02	10.1									
13+00	101.3	91.27	10.0									
14+00	103.0	91.35	11.7	10+29.5								
15+00	101.5	91.52	10.0									
16+00	101.6	91.77	9.8									
17+00	101.7	92.02	9.7									
18+00	103.7	92.10	11.6	13+29.6								
19+00	102.1	92.27	9.8									
20+00	102.5	92.52	10.0									
21+00	102.6	92.77	9.8									
22+00	104.3	92.85	11.5	16+31.4								
LINE 6 0+00	99.9	87.43	12.5	0+00 = 4+22 LINE 1								
1+00	100.3	87.68	12.6									
2+00	103.3	87.93	15.4									
3+00	102.3	88.16	14.1	2+95.5								
4+00	102.2	88.17	14.0									
5+00	100.4	88.43	12.0									
6+00	100.4	88.68	11.7									
7+00	102.5	88.90	13.6	5+90.5								

(CONTD NEXT PAGE)

C76364 NC 3525 W 30th S James Morris 99.4' East of m N 0+00 in Blk C 288 3-18-80
 96-7764-7 S-23-96 3505 W 29th S - Bldg Add - Nc - Betern - 4" PVC 40 1/4" fall - DL - tied into exist. bldg drain 56 ft S.E. M.H.
 98-7637-7 S-11-88 3505 W 29th S Bldg Add - Nc - Fox P/bg -

CONSTRUCTION RECORD

SERVICE RECORD

STATION	ELEVATION		Depth	MANHOLE	4-INCH "Y" BRANCHES		No. of Permit		House Number		DATE OF PERMITS	
	Ground	Grade			North West	South East	North West	South East	North West	South East	North West	South East
LATERAL 80 SW1 (Cont)												
LINECONT 6+00	100.5	88.92	11.6									
7+00	100.5	89.18	11.3									
8+00	101.1	89.43	11.7					2890	3129	3129	McCormac Cr	3-20-81
	103.0	89.64	13.4	8+84.7	Tap 8+79.4	5104.6		272083	3129 W 30 So			5-30-79
9+00	101.1	89.68	11.4									
10+00	101.3	89.93	11.4					98-13168-7	3783 W 30TH			7-20-98
11+00	101.1	90.18	10.9									
	103.6	90.38	13.2	11+80.4	11+59.8			10899	3707 W 30th So			7-28-80
12+00	101.4	90.43	11.0					99-01249	3129 E 11th St			11-19-79
	101.4	90.68	10.7									
13+00	101.4	90.68	10.7					265846	3713 W 30th St			4-13-78
14+00	102.0	90.93	11.1									
	104.2	91.11	13.1	14+75.5				12354	3838 W 31st St			10-19-84
15+00	101.6	91.18	10.4									
16+00	101.7	91.43	10.3									
	102.2	91.68	10.5					7015	3815 W 30th St			11-17-82
17+00	104.7	91.85	12.9	17+70.8	6" STUB N	6" STUB S		26546	3134 S. West	3140 West		11-15-90
	104.7	91.85	12.9					93-12957				5-24-93
LATERAL 28 MAIN 21 SAN SEWER No 22												
0+00	135.7	129.47	6.2	EXISTING								
	136.7	129.75	7.0									
	136.7	129.85	6.9	0+67.7								
1+00	136.7	129.97	6.7									
	136.2	130.11	6.1	1+35.0				260715				4-12-77
LATERAL 134 SAN SEWER No 22												
LINE 1 0+00	130.1	122.64	7.5	EXISTING								
1+00	129.7	122.84	6.9									
2+00	129.3	123.04	6.3									
	129.2	123.23	6.0	2+95.3								
3+00	129.2	123.34	5.9									
	128.9	123.54	5.4					259570	2627 Bullinger			1-25-77
4+00	129.3	123.74	5.6	4+98.2				259569	2619 Bullinger			1-25-77
5+00	129.3	123.74	5.6									
6+00	129.4	123.94	5.5					259872	2628 Hyanath	2620 Hyanath		3-9-77
7+00	129.1	124.14	5.0									
	129.0	124.21	4.8	7+35.2	MH stub W			261429	2627 Hyanath			6-6-77
8+00	128.4	124.44	4.0					26013	2619 Hyanath			3-2-77
	128.0	124.53	3.5	8+42.5	4" STUB W							
LATERAL 134 SAN SEWER No 22 (cont)												
LINE 2 0+00	129.3	123.31	6.0	EXISTING								
1+00	129.1	124.04	5.1									
2+00	128.2	124.24	4.0					260211	2614 Hyanath	2613 Bullinger		3-9-77
	128.2	124.25	4.0	2+04.5	4" STUB SW	4" STUB SE		2002 03462	2619 W 25th	2603 Bullinger		12-24-02
	128.2	124.25	4.0					9962917				4-18-97
SAN SEWER EXT TO 1050 E MAC ARTHUR												
0+00	89.4	78.73	10.7	EXISTING								
0+50	89.2	78.75	10.5									
	89.7	78.78	10.9	0+64.0	8" STUB N	4" STUB NW		13153	1050 E MacArthur			2-6-85
1+00	89.8	79.10	10.7									
1+90	89.5	79.46	10.0					262230	1040 E MacArthur			7-25-77
								266714	1050 E MacArthur			6-12-78

93-12959-7 - 3140 S. West St - No. MH tap per sewer maintenance 4" sch 40 - PVC - 2-45° V - 3 Kickouts