



LATERAL 28 MAIN 21 SAN SEWER N^o22
BUILT BY: W.B. CARTER CONST. CO.
PROJ. N^o DBKL 576065
BOOKED 4-8-77 FROM LES 7

SCALE 1" = 150'

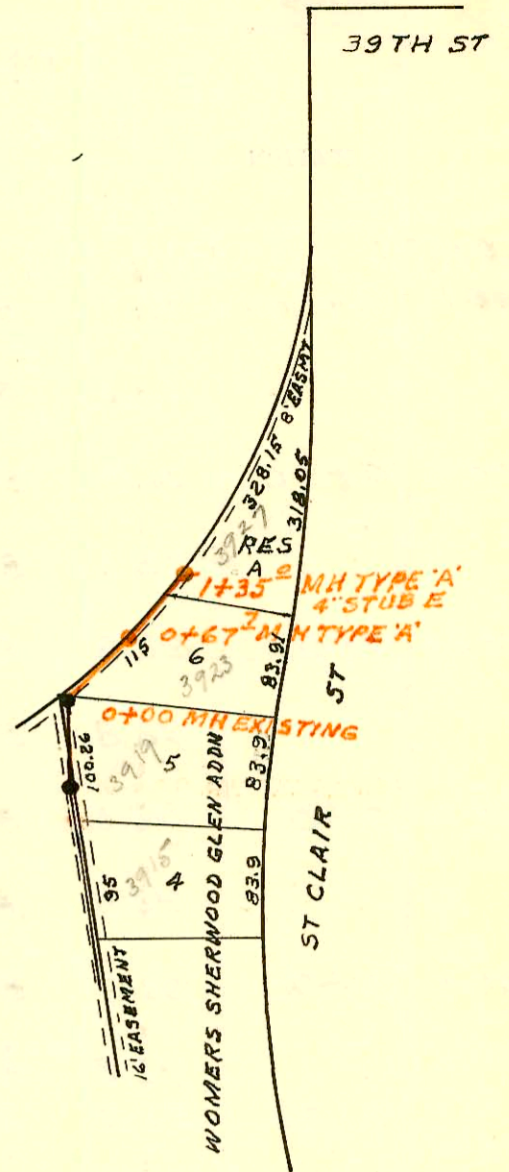

LATERAL 134 SAN SEWER N^o22
BUILT BY: W.B. CARTER CONST. CO.
PROJ. N^o DBKL 576053
BOOKED 4-12-77 FROM DCD 48


SCALE 1" = 150'

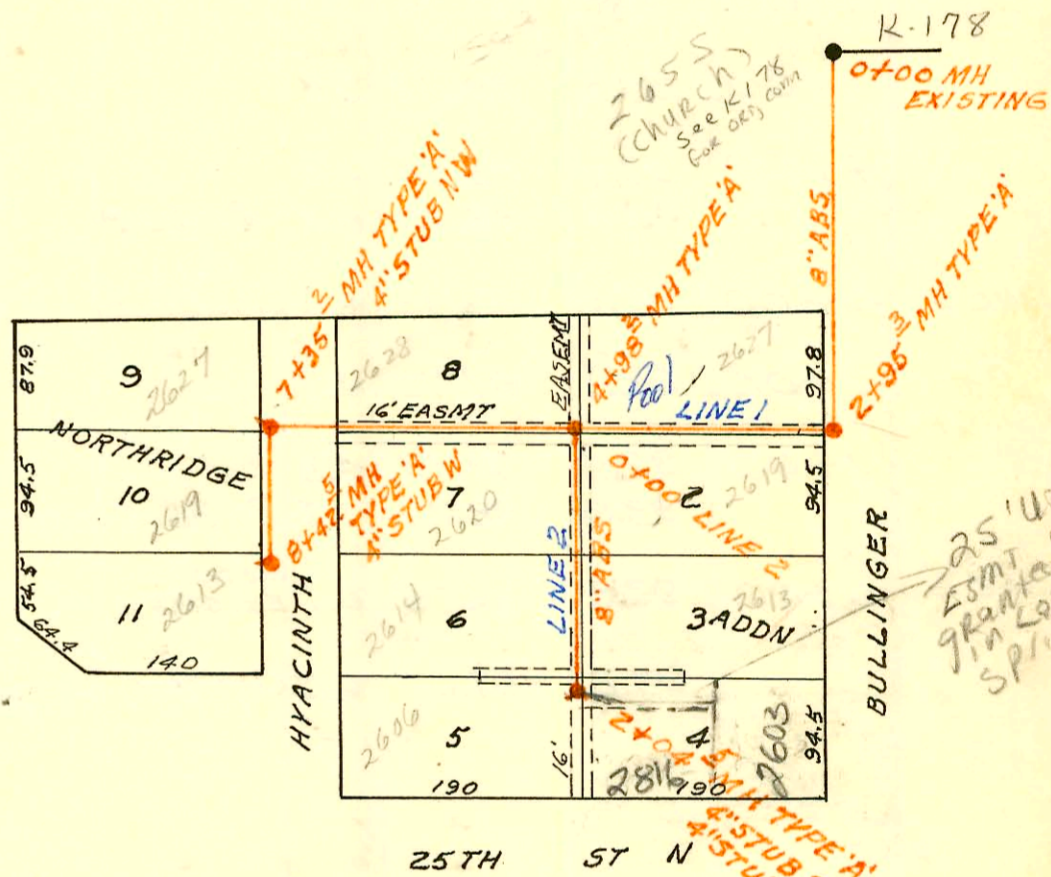

Note:
SERV LINE FOR
2603 CLOSSES
LOT FOR 2516 WITHIN
THE 26' EASMT TO MH STUB
COMMENTS TO MH STUB
MH TOP OK FOR
2816 PER
SEWER MAINT DIV
BSK

SAN SEWER EXT TO 1050 E MAC ARTHUR
LYNN LOWRY ADDN
BUILT BY: W.B. CARTER CONST. CO.
PROJ. N^o DBKW 707008
BOOKED 4-14-77 FROM SRL 5

SCALE 1" = 150'

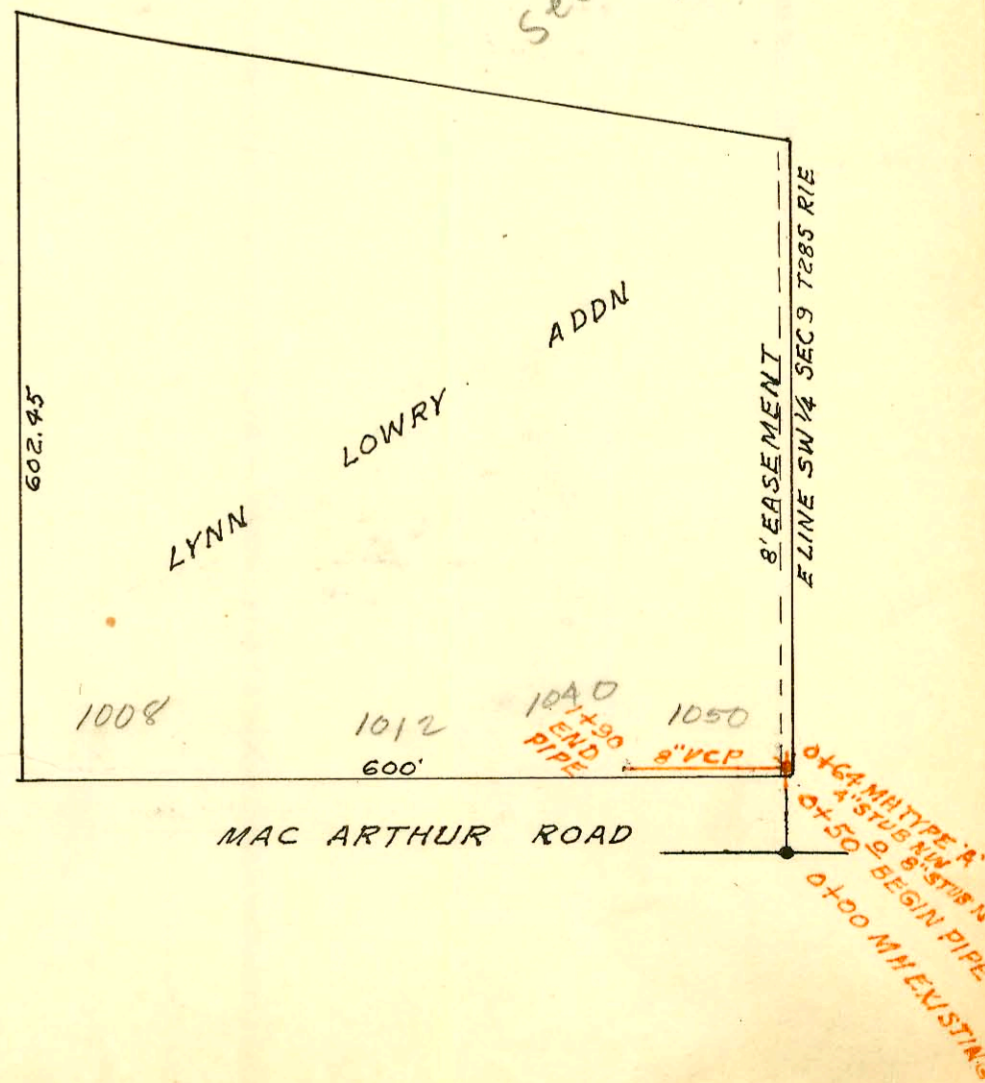

N/C SWR 2002-03462-2816 W 25th St N - Padgett Ex
TWIN CO, 1H45, 1H22, 1V45, 1V22, 4" SCH 40
MH CORE DRILLED & OK BY SWR MAINT

