


B297A

SCALE 1"=150'

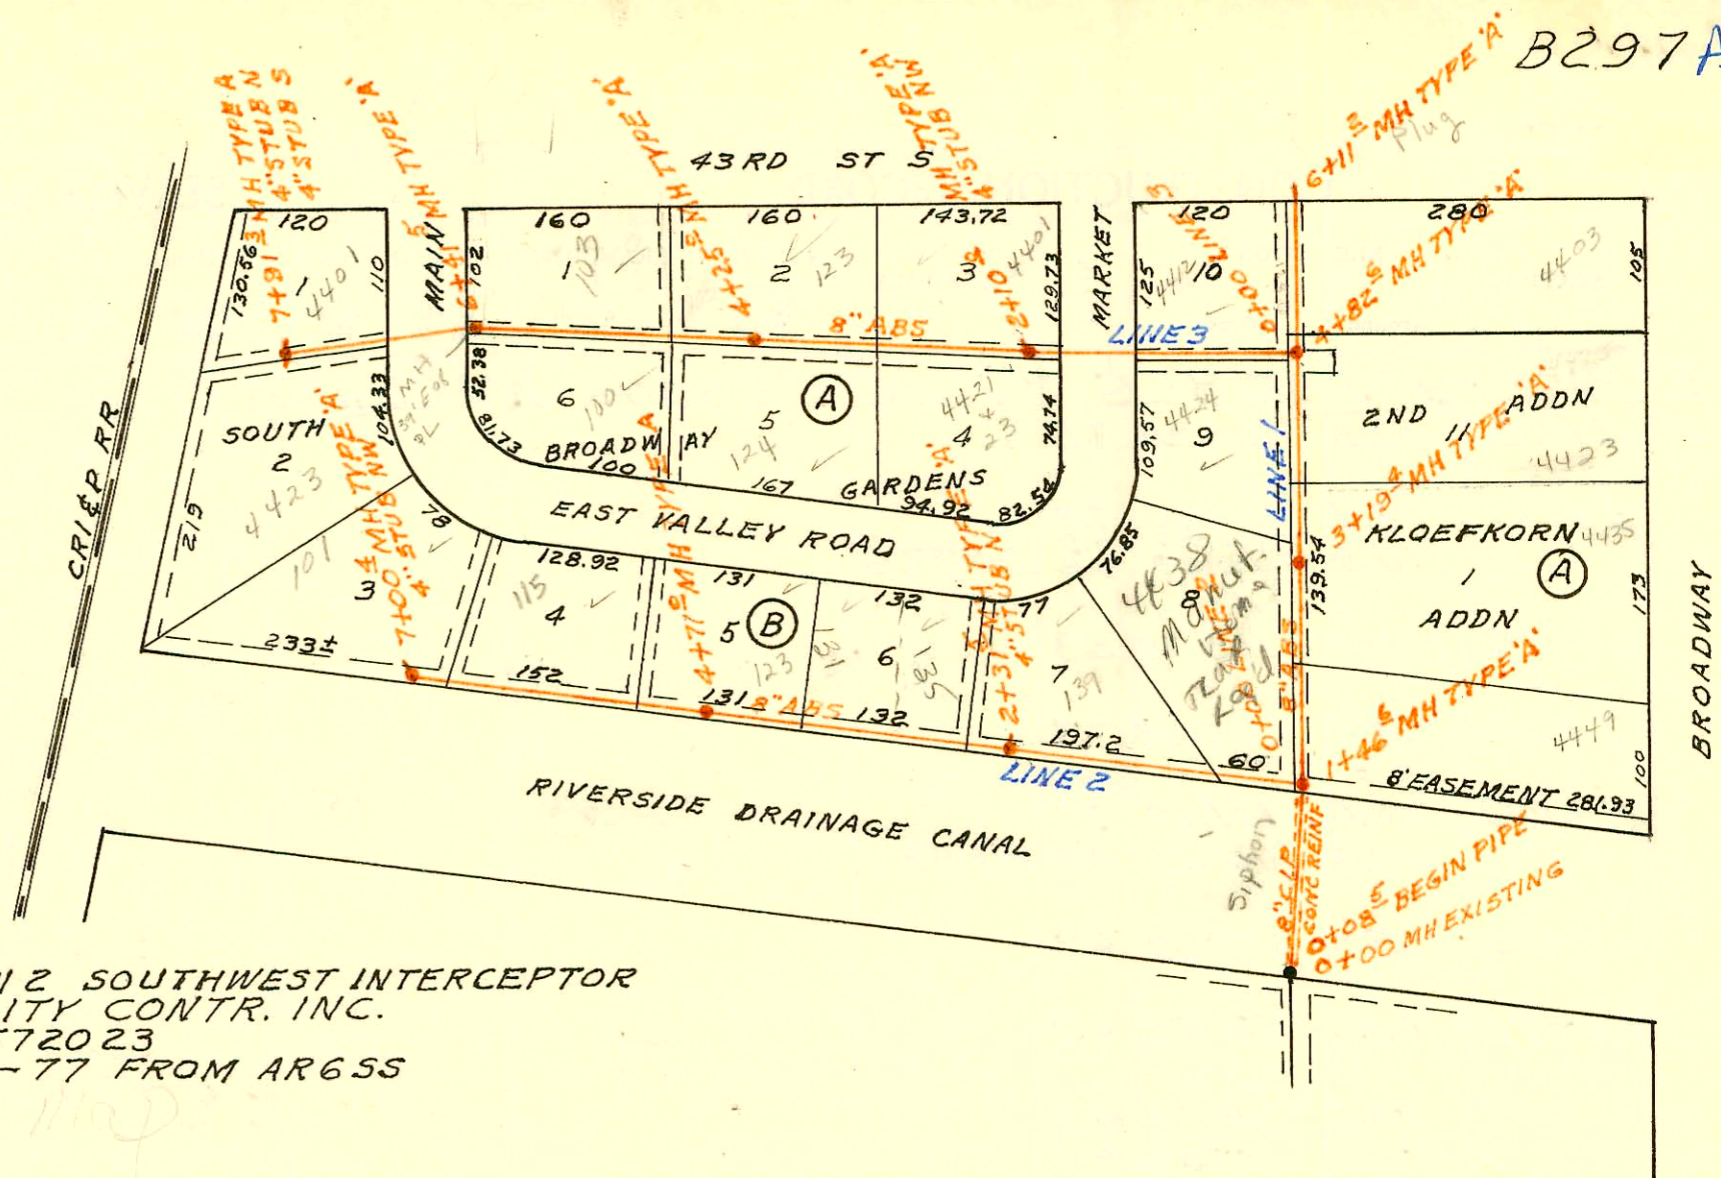

LATERAL 6 MAIN 2 SOUTHWEST INTERCEPTOR
 BUILT BY: UTILITY CONTR. INC.
 PROJ. N^o DBKL 5720 23
 BOOKED 4-20-77 FROM AR655

CONSTRUCTION RECORD

SERVICE RECORD

STATION	ELEVATION		Depth	MANHOLE	4-INCH "Y" BRANCHES		No. of Permit		House Number		DATE OF PERMITS	
	Ground	Grade			North West	South East	North West	South East	North West	South East	North West	South East
LATERAL 6 MAIN 2 SOUTHWEST INTERCEPTOR SEWER												
L1 0+00	84.4	78.13	6.3	EXISTING								
0+08.5												
1+00	82.6	67.80	14.8	SIPHON								
	84.6	79.32	5.3	1+46.6								
		79.42	5.2									
2+00	84.2	79.53	4.7		4" STUB N							
					2+42.6							
3+00	85.0	79.73	5.3									
	85.2	79.77	5.4	3+19.4								
					3+50.9							
4+00	85.0	79.93	5.1									
	85.0	80.09	4.9	4+82.6								
					4+63.0							
5+00	85.2	80.13	5.1									
6+00	85.5	80.33	5.2									
6+11.2	85.5	80.35	5.2	PLUGGED								
LINE 2												
0+00	84.6	79.42	5.2	0+00=1+46.6								
				LINE 1								
1+00	85.5	79.67	5.8									
2+00	85.5	79.92	5.6									
	85.8	80.00	5.8	2+31.5	4" STUB N							
					2+95.0							
3+00	86.6	80.17	6.4									
					3+64.6							
4+00	87.3	80.42	6.9									
	87.2	80.60	6.6	4+71.0								
					4+67.6							
5+00	86.8	80.67	6.1									
6+00	87.7	80.92	6.8									
7+00	88.4	81.17	7.2	7+00.4	4" STUB NW							
LINE 3												
0+00	85.0	80.19	4.8	0+00=4+82.6								
				LINE 1								
1+00	84.8	80.39	4.4									
2+00	84.6	80.59	4.0									
	84.6	80.61	4.0	2+10.0	4" STUB NW							
3+00	84.6	80.79	3.8									
4+00	85.3	80.99	4.3									
	85.3	81.05	4.3	4+25.0								
5+00	85.2	81.19	4.0									
6+00	85.1	81.39	3.7									
	85.5	81.47	4.0	6+41.5								
7+00	85.2	81.59	3.6									
	85.4	81.77	3.6	7+91.3	4" STUB N 4" STUB S							
CESSNA WALLACE PLANT SAN SEWER EXT												
L1 0+00	106.5	99.48	7.0	EXISTING								
1+00	106.5	99.68	6.8									
2+00	107.3	99.88	7.4									
	108.3	100.04	8.3	2+97.6								
3+00	107.9	100.08	7.8									

CONT. ON NEXT PAGE

4421-23 S Market - Sewer Maint crew did dye test on 5/23/00. This house tested positive - connected to City Sewer. Billing Division notified 5/25/00. No location of tap verified (dye test only - no TV) BSR