


CONSTRUCTION RECORD  
SERVICE RECORD  
DATE OF PERMIT  
WASSALL  
Section 3 Twp 28 S. R. 1 E.

Scale 1" = 200'

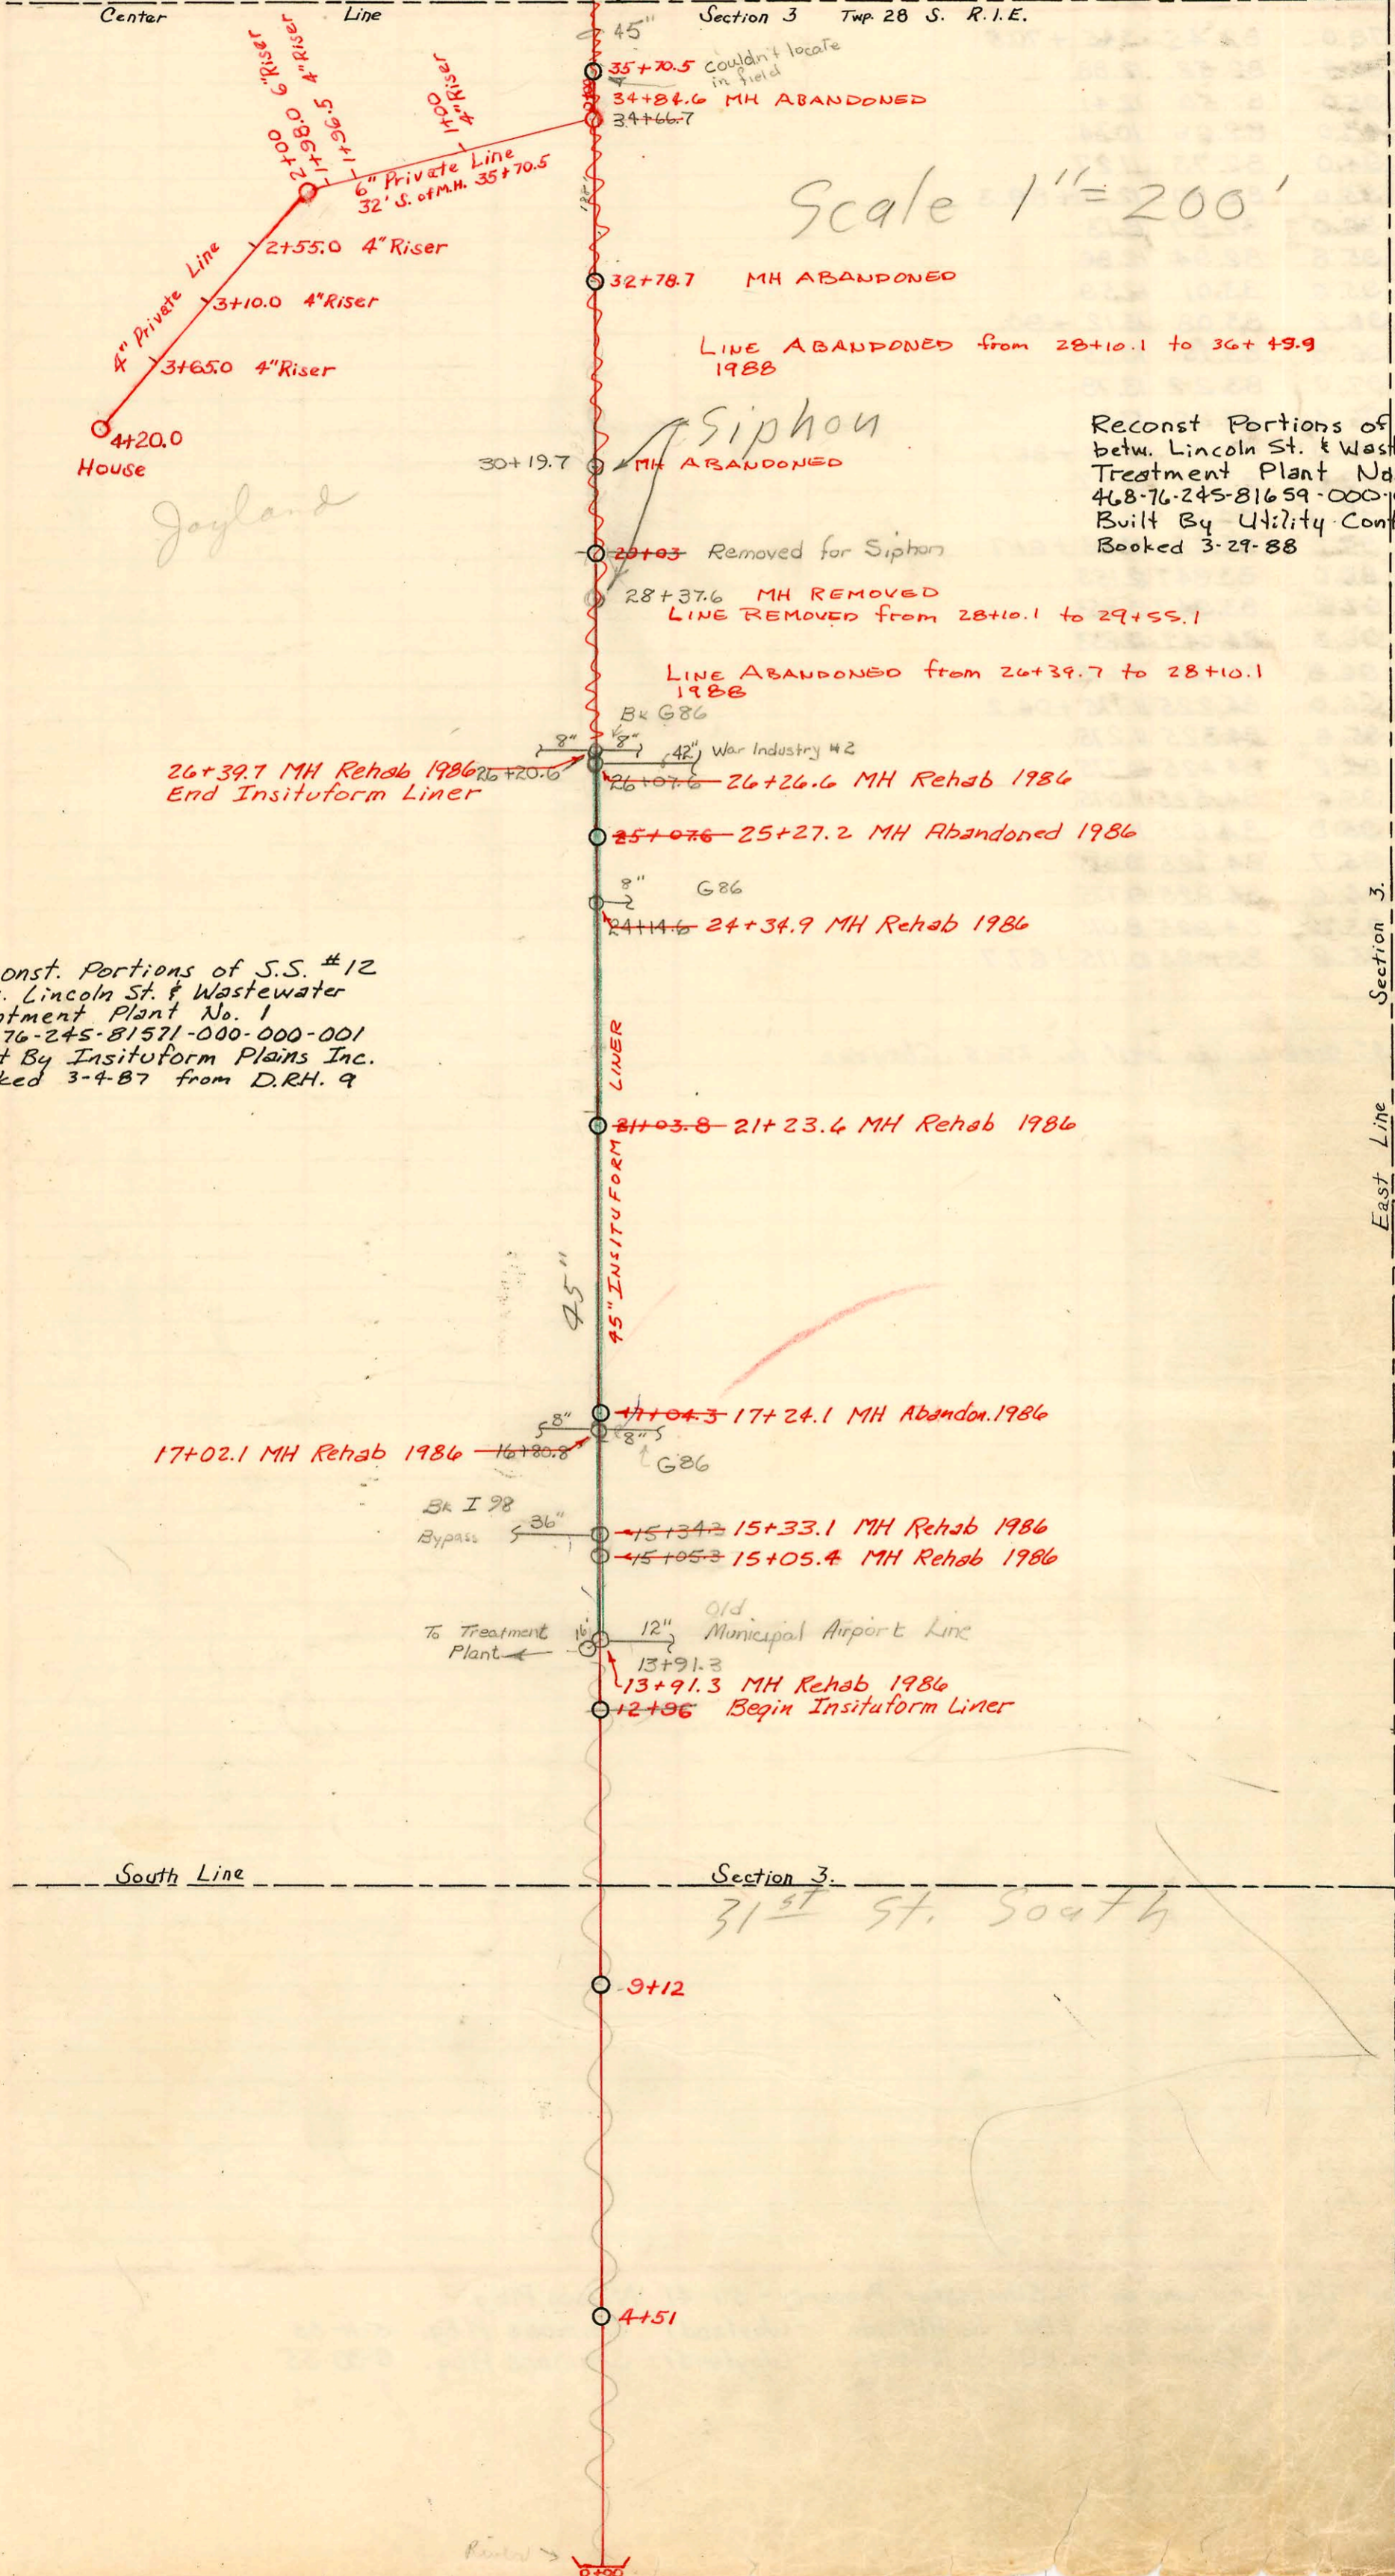

Reconst. Portions of S.S. #12  
betw. Lincoln St. & Wastewater  
Treatment Plant No. 1  
468-76-245-81571-000-000-001  
Built By Insituform Plains Inc.  
Booked 3-4-87 from D.R.H. 9

Reconst Portions of S.S. #12  
betw. Lincoln St. & Wastewater  
Treatment Plant No. 1 (Phase 1 Part 2)  
468-76-245-81659-000-000-001  
Built By Utility Contr.  
Booked 3-29-88

Jayland

Section 3  
East Line

Bill

CONSTRUCTION RECORD						SERVICE RECORD						
STATION	ELEVATION		Depth	MANHOLE	4-INCH "Y" BRANCHES		No. of Permit		House Number		DATE OF PERMITS	
	Ground	Grade			North West	South East	North West	South East	North West	South East	North West	South East
0	78.00	80.00	-2.0									
1	83.5	80.07	3.43									
2	84.0	80.14	3.86									
3	85.2	80.21	4.99									
4	95.0	80.28	14.72	+51								
5	94.8	80.35	14.45									
6	93.8	80.42	13.38									
7	93.4	80.49	12.91									
8	94.8	80.56	14.24									
9	95.6	80.63	14.97	+12								
10	95.0	80.70	14.30									
11	94.0	80.77	13.23									
12	93.2	80.84	12.36	+96								
13	94.6	80.91	13.69									
14	95.0	80.98	14.02									
15	95.2	81.05	14.15									
16	94.8	81.12	13.68									
17	95.0	81.19	13.81	+04.3								
18	95.0	81.26	13.74									
19	95.0	81.33	13.67									
20	95.0	81.40	13.60									
21	96.2	81.47	14.73	+03.8								
22	96.0	81.54	14.46									
23	95.0	81.61	13.39									
24	95.2	81.68	13.52									
25	95.2	81.75	13.45	+07.6								
26	95.6	81.82	13.78									
27	95.6	81.89	13.71									
28	95.8	81.96	13.84									
29	96.0	82.03	13.97	+03								
30	96.8	82.10	14.70									
31	96.8	82.17	14.63									
32	96.8	82.24	14.56	+78.7								
33	96.9	82.31	14.59									
34	96.0	82.38	13.62									
35	79.0	82.45	-3.45	+70.5								

m.H. type 10160

2801 S. Hillside

8-22-68

Hotchkiss

Per. #20250 8-22-68 \$250.00 spec. mat + sub for pd. by C. Le Sage - 2801 S. Hillside - Hotchkiss Rd.