


RELOCATION OF PART OF SAN SEWER #12
 BY STATE HIGHWAY DEPT.
 PROJ. N^o 35W-87I-35W-1(33) 46
 BOOKED 5-3-78 FROM AC PLAN

SCALE 1" = 150'

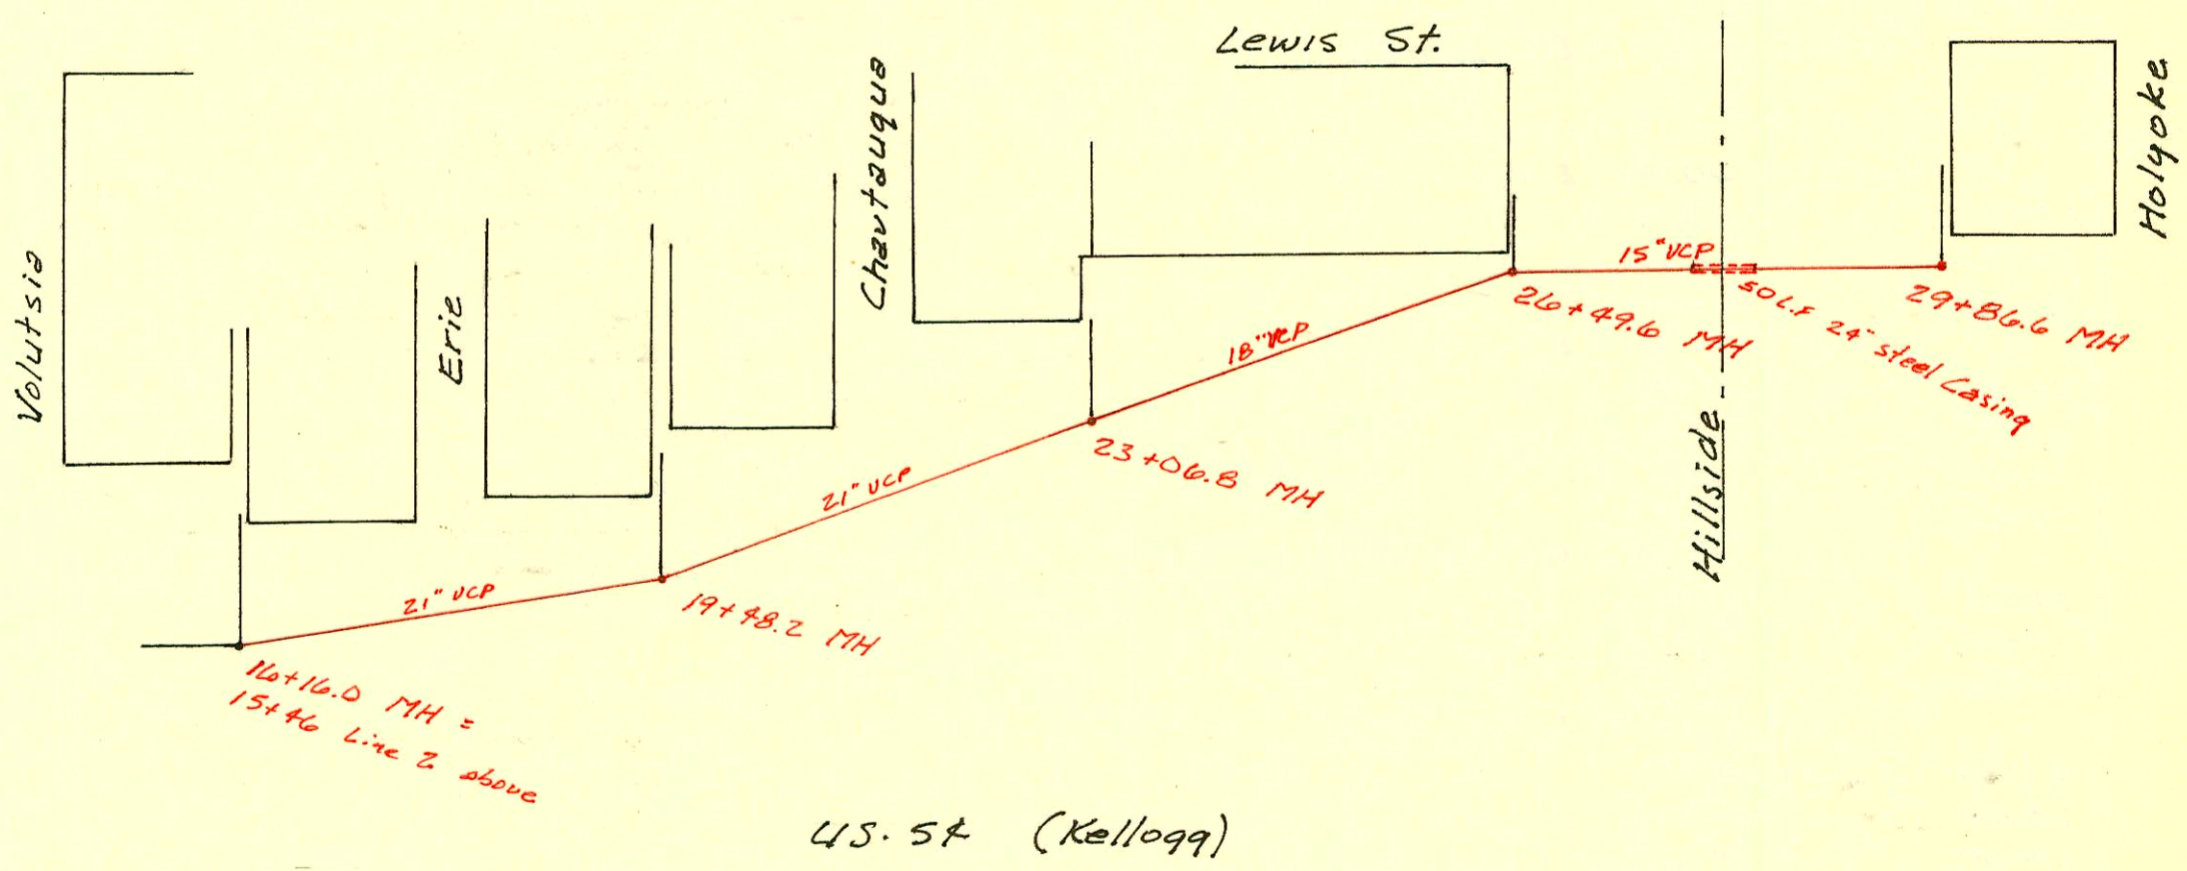

Relocation of Part of San. Sewer #12
 By State Highway Dept with US 54 -
 Hillside Interchange
 Booked 5-90 from Plan

CONSTRUCTION RECORD						SERVICE RECORD						
STATION	ELEVATION		Depth	MANHOLE	4-INCH "Y" BRANCHES		No. of Permit		House Number		DATE OF PERMITS	
	Ground	Grade			North West	South East	North West	South East	North West	South East	North West	South East
<i>RELOCATION of PART of SAN SEWER N^o 12</i>												
<i>LINE 1</i>	0+00	106.2	95.55	10.7	0+00							
		106.7	95.06	11.6	0+07							
		107.0	95.12	11.9	0+61							
	1+00		95.17									
	2+00		95.29									
	3+00		95.41									
		107.9	95.46	12.4	3+41							
	4+00		95.53									
		106.5	95.63	10.9	4+79							
	5+00		95.65									
	6+00		95.77									
	7+00		95.90									
		107.6	95.92	11.7	7+28							
	8+00		96.02									
		108.2	96.06	12.1	8+39							
	9+00		96.14									
	10+00		96.26									
	11+00		96.38									
		108.6	96.42	12.2								
		108.6	96.83	11.8	11+39							
		108.6	96.84	11.8	11+57							
<i>LINE 2</i>	0+00	108.1	97.80	10.3	0+00=8+39							
	1+00		98.00		<i>LINE 1</i>							
		109.2	98.19	11.0	1+89							
	2+00		98.20									
	3+00		98.40									
	4+00		98.60									
	5+00		98.80									
		107.4	98.86	8.5	5+27							
	6+00		99.00									
	7+00		99.20									
	8+00		99.40									
		108.0	99.56	8.4	8+79							
	9+00		99.60									
	10+00		99.80									
	11+00		100.00									
	12+00		100.20									
		107.9	100.21	7.7	12+06							
	13+00		100.40									
	14+00		100.60									
	15+00		100.80									
		108.9	100.89	8.0	15+46							
<i>Relocation of S.S. #12 - US St/Hillside Interchange</i>												
		108.90	100.89	8.0	16+16.0							
	17+00		101.13									
	18+00		101.41									
	19+00		101.69									
		109.81	101.82	8.0	19+48.2							
	20+00		101.99									
	21+00		102.31									
	22+00		102.63									
	23+00		102.95									
		111.42	102.97	8.5	23+06.8							
			103.25									
	24+00		103.70									
	25+00		104.18									
	26+00		104.66									
		116.10	104.90	11.2	26+49.6							
			105.20									
	27+00		105.70									
	28+00		106.70									
	29+00		107.70									
		119.30	108.57	10.7	29+86.6							

CONSTRUCTION RECORD

SERVICE RECORD

Between Madison & Spruce Kellogg to Orme See P. 14

Between Spruce & Grove Kellogg to Orme See P. 14

Between Ash & Madison Orme to Gilbert See P. 16

STATION	ELEVATION		Depth	MANHOLE	4-INCH "Y" BRANCHES		No. of Permit		House Number		DATE OF PERMITS			
	Ground	Grade			North West	South East	North West	South East	North West	South East	North West	South East	North West	South East
0+0	106.06	98.63	7.43	6+36 OR 0+0 For line So.	0 + 11	0 + 08.5	#19214 #1913	#1089	516 S. Madison	515 S. Spruce	8-21-24	12-21-26		
					+36.5	+34								
					+62	+59.5								
					+87	+84.5								
1+0	105.83	98.73	7.10		1 + 13	1 + 10.5	#18941 #1315	#831	518-20 S. Madison	517 S. Spruce	4-23-70	10-4-27		
					+38.5	+36								
					+63.9	+61.4								
					+89	+86.5								
2+0	105.32	98.83	6+49	2 + 22	2 + 14.5	2 + 12	#267 #268	#18948 #305	528 S. Madison	531 S. Spruce	3-25-25	4-23-70		
					+40	+37.5								
					+65.2	+62.7								
					+91	+88.5								
3+0	104.78	98.93	5.85		3 + 16.3	3 + 13.8	#523 #94	#232	540 S. Madison	541 S. Spruce	5-18-25	3-13-28		
					+41.5	+38.5								
					+92.2	+89.7								
4+0	104.30	99.03	5.27		4 + 18.5	4 + 16	#367		546 S. Madison		6-2-31			
+50	104.85	99.08	5.77	4+50	+42	+39.5								
0+0	106.73	98.32	8.41	3+26 OR 0+0 For line So.	0+10.5	0 + 08	#140	#140	515 S. Grove		5-11-70	3-2-25		
					+36.5	+34								
					+61	+58.5								
					+86.5	+84								
1+0	106.45	98.42	8.03		1 + 12.3	1 + 09.8	#1886 #991	#1197	520 S. Spruce	521 S. Grove	10-18-26	11-2-25		
					+37.5	+35								
					+63.5	+61								
					+89	+86.5								
2+0	104.95	98.52	6.43		2 + 13.9	2 + 11.4	#143 #203	#779	538 S. Spruce	538 S. Spruce	3-8-27	7-20-28		
					+39.8	+37.3								
					+65.8	+63.3								
					+90.5	+88								
3+0	104.65	98.62	6.03		3 + 16	3 + 13.5	#1237		546 S. Spruce	547 S. Grove	11-2-25	11-12-25		
					+42.1	+39.6								
					+66.5	+64								
					+92.5	+90								
4+0	105.05	98.72	6.33	4+50	4 + 17.5	4 + 15	#137		550 S. Spruce	555 S. Grove	11-12-25	3-5-27		
+50	106.07	98.77	7.30		+40.5	+38								
0+0	104.16	97.95	6.21	0+0	0 + 23.7	0 + 26.2	#174	#174	658 S. Ash	657 S. Madison	12-26-29	2-29-28		
					+49.5	+52								
					+75	+77.5								
1+0	103.99	98.05	5.94		1 + 00	1 + 02.5	#2563	#2563	652 S. Ash	641 S. Madison	4-6-29	11-18-24		
					+25.5	+28								
					+51	+53.5								
					+76	+78.5								
2+0	104.20	98.15	6.05		2 + 01.6	2 + 04.4	#770	#770	640 S. Ash	643 S. Madison	6-26-29	2-25-72		
					+26.7	+29.2								
					+52.5	+56								
					+78	+80.5								
3+0	104.24	98.25	5.99		3 + 03.5	3 + 06	#1348 #714	#296	626 S. Ash	635 S. Madison	9-23-29	3-28-28		
					+28.5	+31								
					+54	+56.5								
4+0	104.25	98.35	5.90		4 + 02.5	4 + 05	#128		618 S. Ash		3-7-29			
					+77	+79.5								
					+27.5	+30								
					+53.5	+56								
					+79.5	+82								
5+0	104.55	98.45	6.10		5 + 05	5 + 07.5	#1516		615 S. Madison		11-6-72	10-21-24		
					+30.5	+33								
					+55.5	+58								
6+0	105.39	98.55	6.84		+80.5	+83	#2035	#2035	606 S. Ash	607 S. Madison	5-23-25	9-8-24		
+20	105.89	98.57	7.32	6+20	6 + 05.5	6 + 08	#726	#726	602 S. Ash	601 S. Madison	3-7-29	8-29-27		

C36464-551-551 S. Grove - Seal off - 12-27-72 - al Henning
 SO C35281 - 548 S. Spruce - 10-10-72 - al Henning
 C34498-621 S. Madison - Seal off - al Henning - 8-25-72
 Tap #665-557 S. Spruce - 8-16-71 - al Henning (3+95)
 Tap #1504-531 S. Spruce - 11-4-29 - F. J. Adenauer - C18948 C. S. Rutledge - 4-23-70
 Seal off - C16465-515 S. Spruce - Ark Valley Sewer Service - 10-27-69 (5+78) E.W. Lude
 Seal off - C18941-518-20 S. Madison - C. S. Rutledge - 4-23-70
 C 28477 Seal off 649 S. Madison - al Henning - 10-8-71
 C 28469 Seal off 2216 E Orme - al Henning - 10-8-71 (3+05)
 C 32295 Seal off - 621-627 S. Madison - al Henning - 5-17-72 (3+81)