


LAT. D. - DIST. 6 - S. S. No. 12
Mellert - 1928

DIST. 6 - S. S. No. 12
A.A. Dobson - 1927

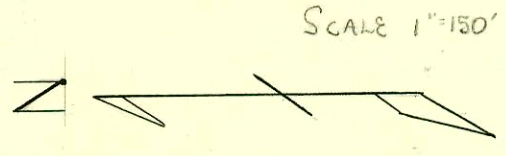

26-29-30-32

CONSTRUCTION RECORD

SERVICE RECORD

STATION	ELEVATION		Depth	MANHOLE	4-INCH "Y" BRANCHES		No. of Permit		House Number		DATE OF PERMITS	
	Ground	Grade			North West	South East	North West	South East	North West	South East	North West	South East
0 + 0	115.84	107.60		0 + 0 =	M.H. in alley West of Rutan N. side of Gilbert Go. south. M.H. in Gilbert at alley W. of Rutan - Go E. in Gilbert.							
0 + 26.5	115.54	108.0		0 + 26.5								
1 + 26	118.54	109.0										
2 + 01	121.74	117.0 in		2 + 01	M.H. at Rutan & Gilbert							
3 + 0	127.34	118.0										
3 + 67.5	131.33	127.00 in		3 + 67.5 =	M.H. at alley E. of Rutan North							
4 + 0	133.23	127.32		4 + 0	16							
5 + 0	138.33	128.32										
5 + 60.5	142.86	135.50 in		5 + 60.5 =	M.H. at Vassar & Gilbert							
6 + 0	145.36	135.90		6 + 0	16							
6 + 98.5	150.46	136.89		6 + 98.5 =	M.H. at alley of Vassar							
8 + 0	152.26	137.90										
8 + 71	152.0	140.18 in		8 + 71 =	M.H. at Clifton & Gilbert - Turn North							
9 + 0	153.20	140.29										
10 + 0	154.30	140.69										
11 + 03	154.20	141.09		11 + 03	M.H. in Clifton N. of Gilbert							
12 + 0	151.90	141.49										
13 + 0	146.80	141.89										
13 + 16	147.78	143.60 in		13 + 16 =	M.H. in Clifton & Orme - Turn East in Orme							
14 + 0	152.18	144.44										
14 + 49	153.48	144.93		14 + 49 =	M.H. in Orme							
15 + 0	152.08	145.44										
16 + 0	156.08	146.44										
16 + 46.6	158.48	151.89 in		16 + 46.6 =	M.H. in Orme							
17 + 0	160.33	152.10										
18 + 0	164.00	152.50										
18 + 22	164.83	155.50 in		18 + 22 =	M.H. in Orme							
19 + 0	167.83	155.67										
20 + 0	171.63	155.87										
20 + 49	172.83	155.97		20 + 49 =	M.H. in Orme							
21 + 0	174.33	156.07										
21 + 48	174.93	156.17		21 + 48 =	M.H. in Orme							
22 + 0	174.93	156.27										
23 + 0	174.63	156.47										
23 + 14.5	174.53	156.50		23 + 14.5 =	M.H. in Quentin & Orme - Turn North							
24 + 0	174.69	156.67										
25 + 0	174.49	156.87										
26 + 0	174.69	157.07										
26 + 27.5	174.79	157.13		26 + 27.5 =	M.H. in Quentin & Orme - Turn East							
27 + 0	173.39	157.27										
28 + 0	171.69	157.47										
28 + 13.5	171.59	157.50		28 + 13.5 =	M.H. in Orme, bet. Quentin & Bluff							
29 + 0	169.69	157.67										
30 + 0	167.39	157.87										
31 + 0	165.59	158.07										
31 + 42	165.39	158.15		31 + 42 =	M.H. in Orme, at alley bet. Bluff & Fountain							
0 + 0	166.69	158.20	8.49	0 + 0	Same M.H.							
1 + 0	167.79	158.70	9.09	1 + 0	0 + 28.5 0 + 26 0 + 55.5 0 + 53 + 80.7 + 78.2		#292 #330	4010 E. Orme	557 S. Fountain	11-7-36	6-30-37	
2 + 0	169.09	159.20	9.89	2 + 0	+ 07.1 2 + 04.6 + 33.1 + 30.6		#94 #2585 #475 #997 #96	534 S. Bluff	549 S. Fountain	3-22-37	8-19-40	
3 + 0	169.96	159.70	10.26	3 + 0	+ 84.8 + 82.3 3 + 10.5 3 + 08 + 35.2 + 32.7		#832 #142 #1176	546 S. Bluff	545 S. Fountain	9-23-31	8-6-29	
4 + 0	170.79	160.20	10.59	4 + 0	+ 60.8 + 58.3 + 87.7 + 85.2		#1350 #116	540 S. Bluff	539 S. Fountain	2-20-30	2-25-54	
4 + 71.2	171.77	160.60	11.17	4 + 71.2	+ 78.2 + 76.1 + 64 + 61.5		#844	536 S. Bluff	535 S. Fountain	9-3-30	3-3-30	
5 + 0	171.79	160.71	11.08	5 + 0	M.H. at inter. of alleys 5 + 10.3 S. 5 + 07.8 N. + 55.8 S. + 33.3 N.		#172067 #1030 #541 #815	528 S. Bluff	521 S. Fountain	1-5-43	3-5-29	
5 + 93.2	170.67	161.10	9.57	5 + 93.2	M.H. at Fountain 5 + 93.2 + 86.8 S. + 84.3 N.		#815	570 S. Bluff	515 S. Fountain	9-26-29	8-9-28	
0 + 0	171.77	160.60	11.17	0 + 0	0 + 09.4 S. 0 + 06.9 N. + 35.2 S. + 32.7 N. + 60.8 S. + 58.4 N. + 86.2 S. + 83.7 N.		#294 #919	521 S. Bluff	4023 E. Kellogg	3-29-37	4-28-52	
1 + 0	170.82	161.60	9.22	1 + 0	1 + 12.7 S. 1 + 10.2 N.		#919	504 S. Bluff	503 S. Fountain	8-27-28	12-15-36	
1 + 26.5	170.67	161.85	8.82	1 + 26.5	M.H. at Bluff							

3516 Tap (504 S Bluff) Kellogg 1-22-37 (sic at bldg. sub out)
 #40 - 309 S. Fountain - 2-18-37 - W.W. Day - used old clock
 #292 - 4010 E. Orme - 6-12-37 - John Ridel - Tap
 #768 - 3401 E. Gilbert - 9-19-47 - V. Douglas Lansdowne - Tap

97-29607-33-99 4025 E. Kellogg - clear water