


LAT. I - DIST. G - S.S. No. 12  
Johnson & Jones - 1930

MORRIS AVE.		0+0	AVE.	
25	146	15	130	145
	148			147
	150			149
	152			151
	500			499

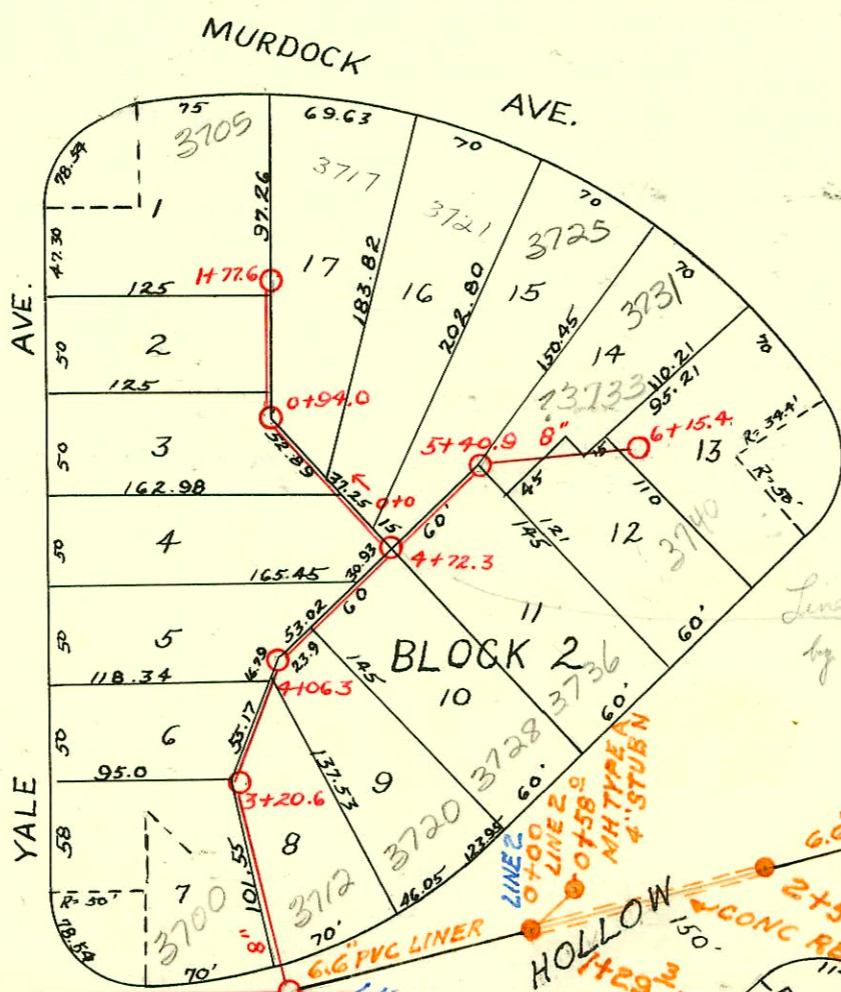

848 1/2" take  
SEWER MAIN  
CONFIRMED  
FRESH TANK  
15' TIE TO  
HOLYOKE ST  
LINCOLN ST  
01/19/08  
BK


3306 Lincoln  
TU has shows  
3306 TIE TO  
NIS Line at 30'  
NY MH 67377

Line being reconstructed  
by B Carter 11/15/76

RECONSTRUCT PORTION LAT 8  
DIST D - S.S. No. 12  
BUILT BY: W.B. CARTER CONST. CO.  
PROJ. No. DBKL 575062  
BOOKED 3-1-77 FROM 1H 67

LAT. 8 - DIST. D - S.S. No. 12  
Johnson & Jones - 1930

This "PVC liner" looks like  
HDPE on tv inspection.  
-Ludonn-

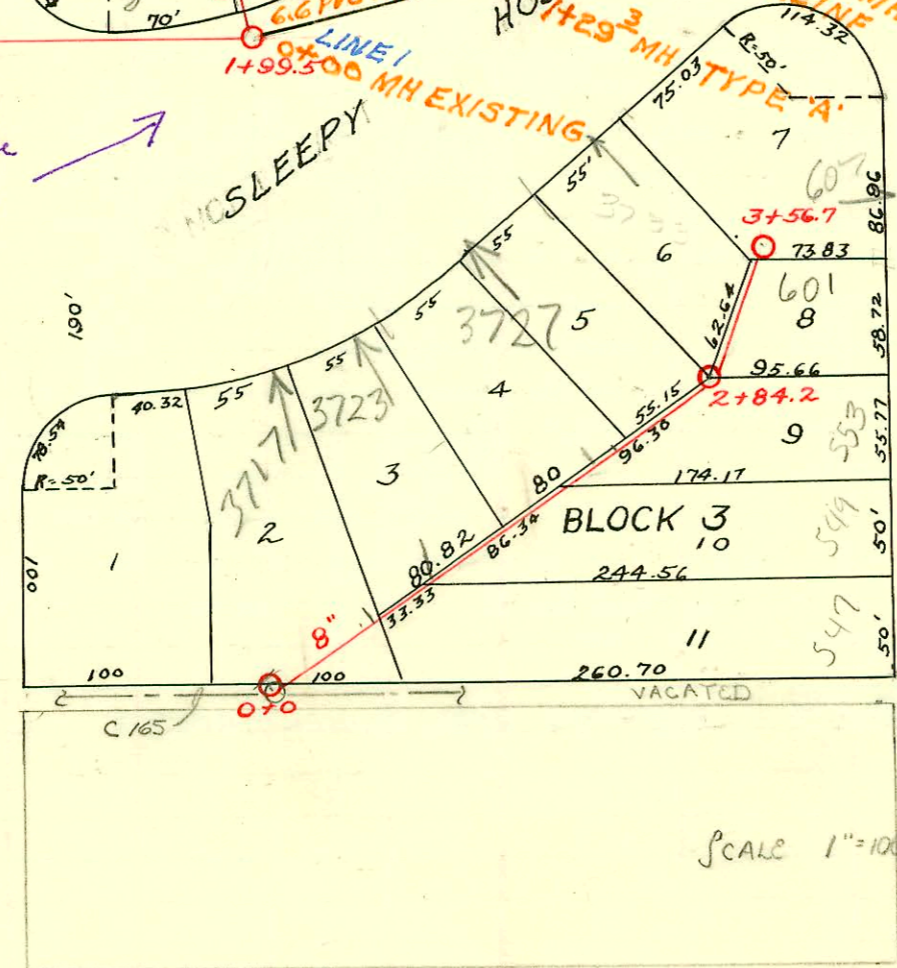

2002-00088 110102 832 S Holyoke - Nelson Plbg - 4" sch 40 Predco Saddle 8.8' N of MH 4+22 (4+14.2) ITWIN CO, 3H45  
2002-01973 719102 807 S Rutan - Aaah NO Leaks - 4" sch 40 Replace all but lower 1.6', twin co @ house  
2003-02656-1011403 3727 E Sleepy Hollow - Roto Rooter - Pipe burst replacement - 4" PESDR17 - City wye repair  
61.9' SW of MH 2+84.2 (2+22.3) 2V45 +1 ITWIN CO

CONSTRUCTION RECORD

SERVICE RECORD

STATION	ELEVATION		Depth	MANHOLE	4-INCH "Y" BRANCHES		No. of Permit		House Number		DATE OF PERMITS	
	Ground	Grade			North West	South East	North West	South East	North West	South East	North West	South East
0+0	155.0	148.40	6.60	0+0								
1+0	153.0	148.50	4.50		1+49 N.							
					1+99.5							
2+0	152.0	148.60	3.40		2+45	2+48						
3+0	152.0	149.60	2.40	3+20.6	3+40.6	3+43.1	#585		710 S. Yale		6-10-30	
					+95.4	+98.6	#599		714 S. Yale		6-13-30	
4+0	156.90	150.60	6.30	4+06.3	4+08.7	4+11.7 N.						
					+33.7	+36.7						
					4+72.3	+82.1						
					5+05.8	5+08.5	#586		3736 N.E. Parkway		6-10-30	
5+0	161.74	151.60	10.14			+33.9						
					5+40.9	+59.7	+56.7	#219	3740 N.E. Parkway	3725 E. Murdock		4-24-31
					+84.7	+81.7	#60	#536	3730 N.E. Parkway	3733 E. Murdock	5-26-33	11-17-31
6+0	163.80	152.60	11.20		6+12.3	6+09.3						
6+15.4	164.82	152.73	12.09	6+15.4								
0+0	161.7	152.0	9.70	0+0	0+31.7	0+28.7	#471			3721 E. Murdock		9-17-31
					+60.7	+57.7						
					+83.7	+80.7	#96		730 N. Yale		3-3-31	
					0+94	+86.7	#569		724 N. Yale		6-4-30	
1+0	163.65	152.50	11.15			1+15.7						
						1+40.1	+37.1	#570	728 N. Yale		6-4-30	
						1+66.5	+63.5	#2075	3705 E. Murdock		3-2-49	
1+77.6	163.20	152.73	10.47	1+77.6								
0+0	162.37	150.60	11.77	0+0	N.E.	S.E.						
					0+55	0+52.5						
					+84.1	+81.6						
1+0	160.40	150.70	9.70		1+10.7	1+08.2						
					+36.2	+33.7	#327		3717 N.E. Parkway		6-3-31	
					+63.1	+60.6	#455		3723 N.E. Parkway		9-2-31	
2+0	159.30	150.80	8.50		+92.5	+90.0	#2005					
					2+22.3	2+19.8	#154		3727 N.E. R. see next	1011403		10-14-33
					+48.5	+46			Parkway Sleepy Hollow		2-28-34	
					2+84.2	+78.5	+76					
3+0	157.11	150.90	6.21		West	East						
						2+97.2						
					3+27.1	3+24.6	#571		3727 N.E. Parkway		6-4-30	
3+56.7	156.82	150.99	5.83	3+56.7	+57.6	+48.6	#581	#999	627 N. Roosevelt	627 N. Roosevelt	3-10-47	11-7-30
0+0	115.40	108.70	6.70	0+0	0+41.5	0+44	#668		801 S. Rutan		9-16-46	
					+68	+70.5	#983		802 S. Holyoke		10-30-30	
1+0	115.75	108.80	6.9		+97	+99.5	#3271		807 S. Rutan	see next	7-18-03	4-2-41
					1+26.5	1+29	#619		806 S. Holyoke		6-20-30	
					+52.5	+55	#620		810 S. Holyoke		6-20-30	4-2-41
2+0	114.80	108.90	5.9	2+09.9	+82.4	+84.9	#3370		813 S. Rutan		4-24-41	
					2+17.4	2+19.9	#641		818 S. Holyoke		6-25-30	
					+46.5	+49	#921		817 S. Rutan		4-24-41	
					+74	+76.5	#70		822 S. Holyoke		10-2-30	
3+0	114.0	109.0	5.0		3+02.5	3+05			826 S. Holyoke		2-12-31	
					+29.6	+32.1	#828	#3373	828 S. Holyoke	827 S. Rutan	8-28-30	4-24-41
					+59	+61.5	#3534		835 S. Rutan	see next	5-26-41	
					+84.7	+87.2	#171		832 S. Holyoke	see next	4-8-31	
4+0	113.90	109.10	4.8	4+23	4+14.2	4+16.7	#759	#3535	842 S. Holyoke	841 S. Rutan	7-29-30	5-26-41
					+40.8	+43.5	#147		848 S. Holyoke		3-28-31	
					+72.1	+74.6	#3538	#3537	846 S. Holyoke	851 S. Rutan	5-26-41	5-26-41
					+26.8	+29.3						
					+52.9	+55.4						
					+81.5	+84.0						
6+0	114.50	109.30	5.20		6+16.2	6+13.7						
6+37.7	114.51	109.34	5.17	6+37.7		+30.4	#2495		855 S. Rutan		5-18-48	

RECONST PORTION OF LAT 8 DIST D SS N#12

LINE 1	0+00	155.0	148.79	0+00 = 1+99.5
		153.0	148.98	OLD LINE
		155.9	149.14	1+29.3
		160.2	149.31	2+54.5
LINE 2	0+00	153.0	149.08	4+27.1
		154.4	149.20	0+00 = 1+29.3
				LINE 1
				0+58.0

- #201 - Tap - 625 N. Roosevelt - 5-9-31 - Vernon Shellenberger
- #470 - Tap - 3712 N.E. Parkway - 9-17-31 - Vernon Shellenberger
- #504 - Tap - 3720 N.E. Parkway - 10-17-31 - Connor & Ripstra
- #555 - Tap - 3728 N.E. Parkway - 12-16-31 - Vernon Shellenberger
- #14 - Tap - 3917 E. Murdock - 3-19-34 - Brodie Pfbg.
- #68 - Tap - 3700 N.E. Parkway - 4-21-32 - C.C.M. Kavulin
- #3372 - Tap - 821 S. Rutan - 4-24-41 - Chester Davidson (Tap at 2+92.9)
- #3536 - Tap - 845 S. Rutan - 5-26-41 - Chester Davidson (Tap at 4+93.5)
- #6228 - Tap - 3306 E. Lincoln - 10-23-51 - Kime Pfbg. Co

#358653 - 3726 Sleepy Hollow - 11/15/76 - Jack Stamp (Reconst.)

#358652 - 3728 Sleepy Hollow - 11/15/76 - Jack Stamp (Reconst.) (19' W of 0+00)