


DIST. A - S.S. No. 12
1912

1990 SANITARY SEWER RECONST.
PROGRAM PHS II - G, 1, 2 & 4
468-82080 (630434)
Built By INSITUFORM PLAINS
Booked 6-17-91

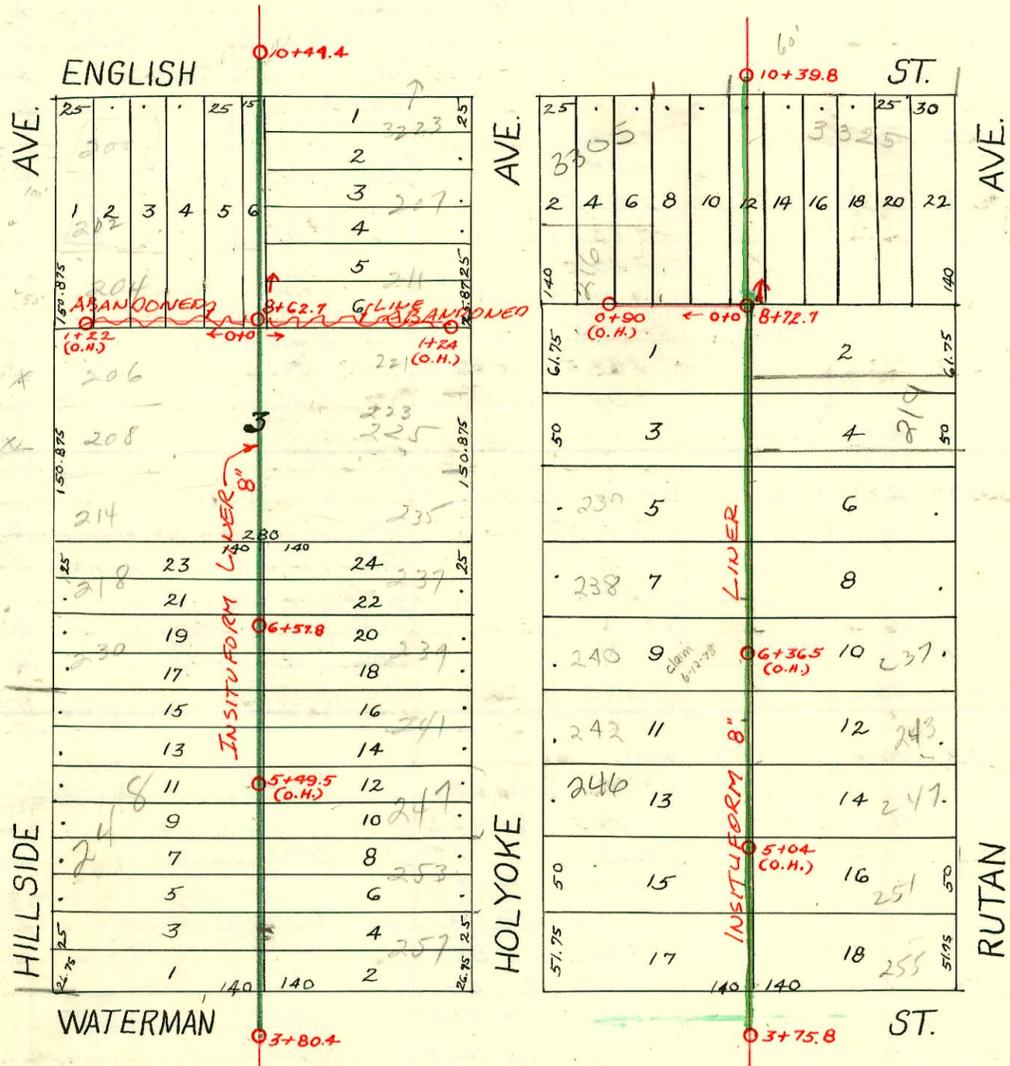

1990 SAN. SEWER RECONSTRUCTION, PHS III
PROJ. NO. 468-82080 (630442)
BUILT BY INSITUFORM PLAINS, INC.

2004-00299 210104 235 Holyoke - Kime Plbg - 8x8 room addition - soil pipe extension 4" 40 PK
ITWINCO

2003-01480 45103 2195 Rutan - Wichita Exc. 4" PK, 1 DIRCO (CO inside basement) 21022, 1045, CITLWYE
REPAIR - 4" Preko 772' S of MH 87727 (77955)

96-1568-7 - 257 S Holyoke - Record of Conn per T.V. Log from
INSITUFORM INC showed conn at 205' S. of
MH 6+57.8. making it sta. 4+52.8 OR 72.4' N
of MH 3+80.4 - Repair -

2000-01698 - 237 S Rutan - Reddi Rootr - 4" SCH40 - Repl 6" Ave Lower

CONSTRUCTION RECORD

SERVICE RECORD

STATION	ELEVATION		Depth	MANHOLE	4-INCH "Y" BRANCHES		No. of Permit		House Number		DATE OF PERMITS	
	Ground	Grade			North West	South East	North West	South East	North West	South East	North West	South East
3+0	119.25	113.30	5.95	3+80.4								
4+0	119.35	113.73	5.62		4+22.5	4+20	#306		232 S. Hillside		5-14-75	
					+47.5	+45	#257		237 S. Hillside		5-23-18	
					+72.5	+70	#256		248 S. Hillside		5-14-75	4-28-14
					+97.5	+95	#718		244 S. Hillside		5-6-11	5-9-18
5+0	120.65	114.27	6.38		5+22.5	5+20	#618		247 S. Hillside		8-24-17	
					+47.5	+45	#332		235 R. Sec. next		8-17-16	
					+72.5	+70	#344		235 R. Sec. next		6-18-13	
					+97.5	+95	#410		237 S. Hillside		5-2-11	
6+0	120.75	114.70	6.05		6+22.5	6+20	#411	#80	240 S. Hillside	239 S. Hillside	5-2-11	2-20-13
					+47.5	+45	#897		218 S. Hillside		11-29-11	
					+72	+69.5						
					+97	+94.5						
7+0	121.25	115.14	6.11		7+22	7+19.5	#605		221 S. Hillside		7-5-11	
					+47	+44.5	#873	#872	212 S. Hillside	213 S. Hillside	11-11-11	11-11-11
					+72.5	+70	#56	#500	208 S. Hillside	229 S. Hillside	11-6-68	9-10-13
					+97.5	+95	#203	#73	201 S. Hillside	201 S. Hillside	4-21-13	2-5-14
8+0	121.95	115.57	6.38		8+22.5	8+20	#11299	#493	206 S. Hillside	203 S. Hillside	11-6-68	10-25-12
					+48	+45.5	#13122	#538	200 S. Hillside	202 S. Hillside	3-13-67	7-12-15
9+0	122.40	116.01	6.39		9+15.4	9+34.4						
10+0	122.80	116.44	6.36	10+44.4								
3+0	124.50	118.05	6.45	3+75.8								
4+0	126.40	118.95	7.45		4+17.5	4+15	#532	#338			9-26-13	6-8-18
					+43.5	+41						
					+68.5	+66	#811	#75			10-5-11	3-8-18
					+94	+91.5	#145	#290	246 S. Hillside		10-29-02	
5+0	127.60	119.85	7.75		5+18.5	5+16	#577				4-21-16	5-12-14
					+45	+42.5	#318				6-22-11	
					+70	+67.5	#576	#418			6-22-11	6-19-17
					+92.5	+93	#1380		237 S. Hillside		11-18-19	
6+0	128.60	120.75	7.85		6+21.5	6+19	#913	#16			4-29-20	
					+47.5	+45	#338				12-24-17	1-12-14
					+72.5	+70	#338				4-29-20	
					+93.5	+91	#184		230 S. Hillside		11-25-12	4-29-12
7+0	129.66	121.65	8.01		7+24	7+21.5	#505	#755			7-18-17	7-16-28
					+73.5	+71	#690		215 S. Rutan		8-17-27	
					+98	+95.5						
8+0	129.76	122.55	7.21		8+24.5	8+22						
					+50	+47.5						
					+84.5	+82						
9+0	131.46	123.45	8.01		9+07.5	9+05	#314	#536	335 E. English	305 S. Rutan	4-13-22	8-2-73
					+30.5	+28						6-10-11
					+51	+48.5						
					+68.5	+66						
10+0	134.86	124.35	10.51	10+39.8								
0+0	122.61	115.75	6.86	0+0	North							
					0+19.5							
					+45							
					+70.5							
					+95.5							
1+0	120.31	116.25	4.13	1+18.5	1+18.5							
0+0	122.61	115.75	6.86	0+0	0+21.5							
					+47							
					+71.5							
					+97							
1+0	124.51	116.25	8.26	1+22.5	1+22.5							
0+0	130.33	123.14	7.19	0+0	0+12							
					+29							
					+55							
	128.33	123.60	4.73		0+82	0+80	#128	#884	330 S. English		4-10-12	12-3-17

R #7013 207 S. Hillside 11-17-82 (Barnes)
 #73552 - 220 S. Hillside - 8-10-79 - Log (7+56.3)
 #224 - Tap - 206 S. Hillside 4-29-18
 #217 - Tap - 219 S. Hillside 4-27-18
 #253 - Tap - 204 S. Hillside 5-8-18
 #250329 - 248 S. Hillside 7-14-75 (Log 5+01.8)
 #2065327 - 218 S. Hillside - 3-10-78
 #2065528 - 218 S. Hillside - 3-14-78
 #2065529 - 235 S. Hillside - 3-13-78
 #202 - Private line - 216 S. Hillside - 4-30-27
 #203 - Tap - 202 S. Hillside 6-15-18
 #204 - Tap - 206 S. Hillside 4-29-18
 #205 - Tap - 219 S. Hillside 4-27-18
 #206 - Tap - 204 S. Hillside 5-8-18
 #207 - Private line - 216 S. Hillside - 4-30-27
 #208 - Tap - 202 S. Hillside 6-15-18
 #209 - Tap - 206 S. Hillside 4-29-18
 #210 - Tap - 219 S. Hillside 4-27-18
 #211 - Tap - 204 S. Hillside 5-8-18
 #212 - Private line - 216 S. Hillside - 4-30-27
 #213 - Tap - 202 S. Hillside 6-15-18
 #214 - Tap - 206 S. Hillside 4-29-18
 #215 - Tap - 219 S. Hillside 4-27-18
 #216 - Tap - 204 S. Hillside 5-8-18
 #217 - Private line - 216 S. Hillside - 4-30-27
 #218 - Tap - 202 S. Hillside 6-15-18
 #219 - Tap - 206 S. Hillside 4-29-18
 #220 - Tap - 219 S. Hillside 4-27-18
 #221 - Tap - 204 S. Hillside 5-8-18
 #222 - Private line - 216 S. Hillside - 4-30-27
 #223 - Tap - 202 S. Hillside 6-15-18
 #224 - Tap - 206 S. Hillside 4-29-18
 #225 - Tap - 219 S. Hillside 4-27-18
 #226 - Tap - 204 S. Hillside 5-8-18
 #227 - Private line - 216 S. Hillside - 4-30-27
 #396 - Tap - 204 S. Hillside 5-8-18
 #397 - Private line - 216 S. Hillside - 4-30-27
 #398 - Tap - 202 S. Hillside 6-15-18
 #399 - Tap - 206 S. Hillside 4-29-18
 #400 - Tap - 219 S. Hillside 4-27-18
 #401 - Tap - 204 S. Hillside 5-8-18
 #402 - Private line - 216 S. Hillside - 4-30-27
 #403 - Tap - 202 S. Hillside 6-15-18
 #404 - Tap - 206 S. Hillside 4-29-18
 #405 - Tap - 219 S. Hillside