


DIST. B - S.S. No. 12
19 11

1992 SANITARY SEWER REHABILITATION PROGRAM - PHASE III
PROJ. NO. 468-82220 (631879)
BUILT BY INSITUFORM PLAINS, INC.
BOOKED 8-25-93 FROM AS BUILTS

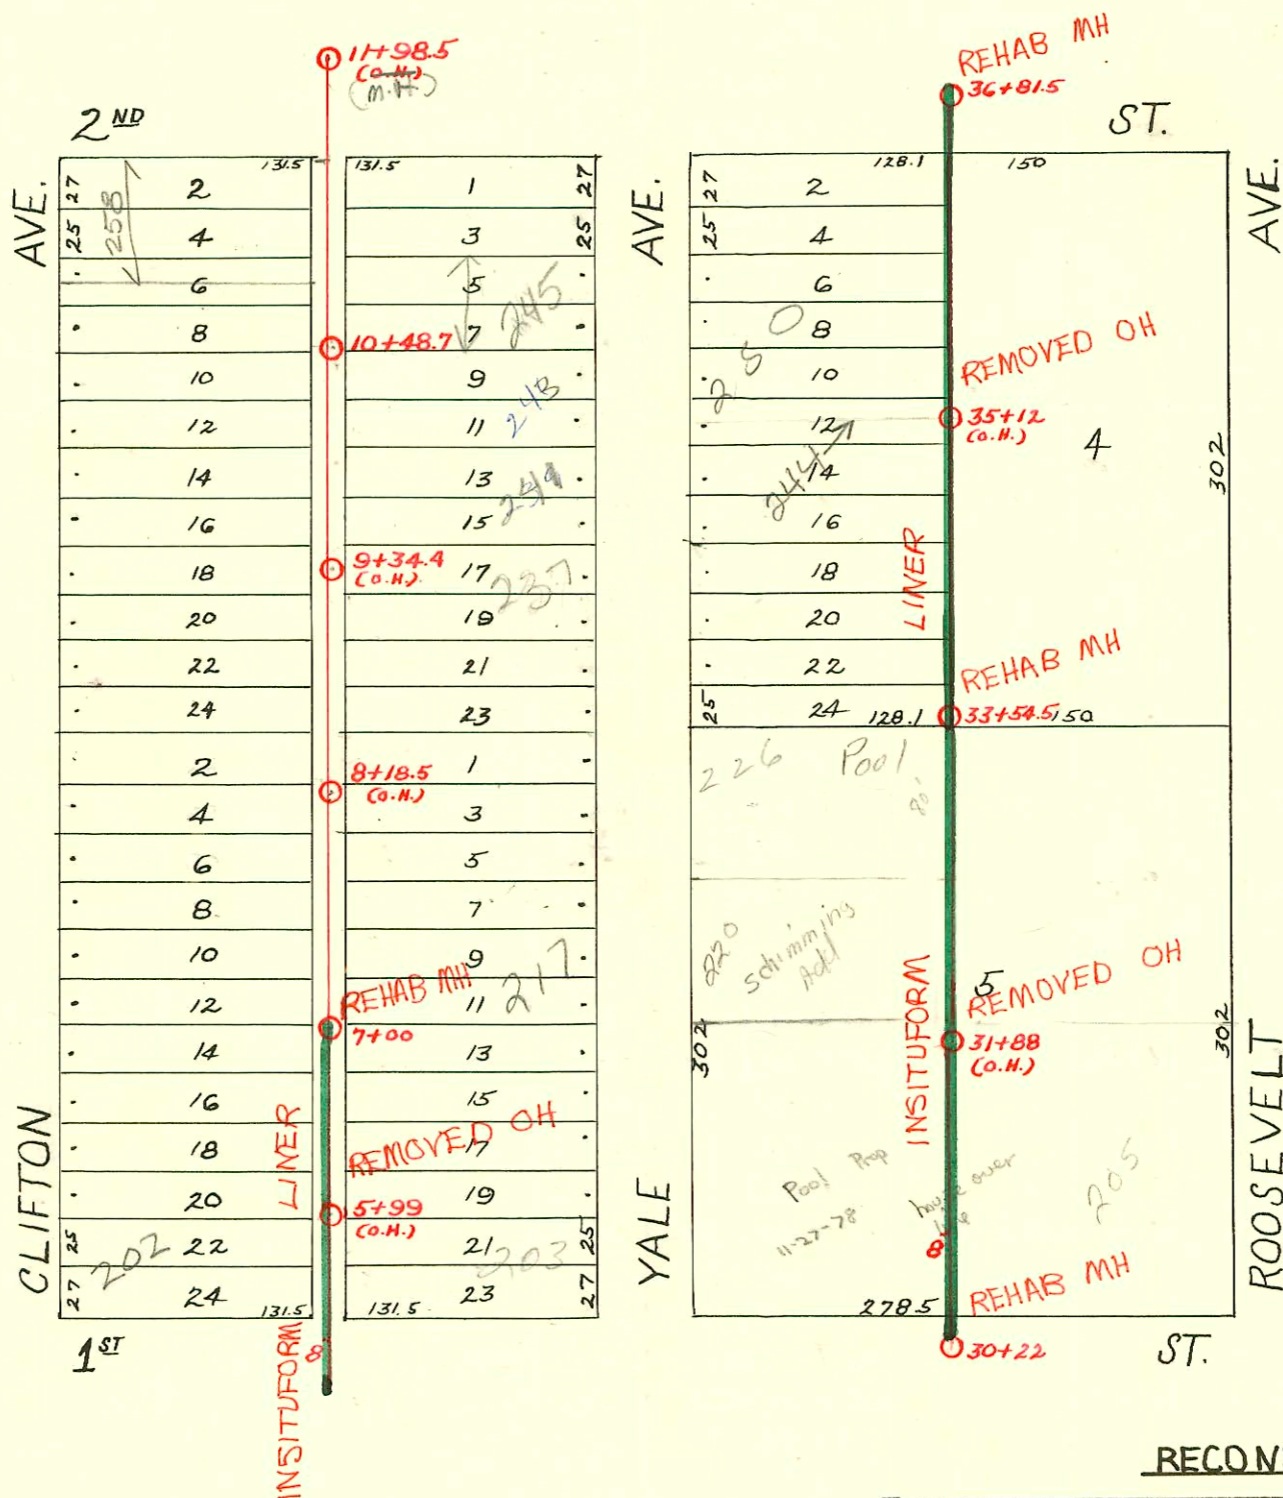

RECONNECTIONS

STATION	ADDRESS	DIRECTION
6+68.8	211 N. Yale	East
6+57.1	202 N. Clifton	West
6+44.4	202 N. Clifton ^{R see below}	West ^{9/22/99}
6+40	205 N. Yale	East
5+93.8	202 N. Clifton	West
5+66.6	3622+3626 E. 1st	East

99-13251-7

99-13251-7-6/22/99- 202 N Clifton Boardman - 4" SCH40 - Tapped on E side of main 142.6'S of MH

RECONNECTIONS

STATION	ADDRESS	DIRECTION
36+17.5	254 N. Yale	West
35+58	255 N. Roosevelt	East
35+55.4	250 N. Yale	West
34+88.1	244 N. Yale	West
34+06.1	240 N. Yale	West
34+01	235 N. Roosevelt	East
33+71.1	236 N. Yale	West
33+21.9	225 N. Roosevelt	East
33+04.3	226 N. Yale	West
32+86.8	225 1/2 N. Roosevelt	East
32+48.4	217 N. Roosevelt	East
32+33.7	220 N. Yale	West
32+07.1	217 N. Roosevelt	East
31+36	205 N. Roosevelt	East
31+34.4	205 N. Roosevelt	East
31+25.8	205 N. Roosevelt	East

replaced all, but lower 2'

CONSTRUCTION RECORD							SERVICE RECORD					
STATION	ELEVATION		Depth	MANHOLE	4-INCH "Y" BRANCHES		No. of Permit		House Number		DATE OF PERMITS	
	Ground	Grade			North West	South East	North West	South East	North West	South East	North West	South East
30				30+22	30+53.5	30+51						
	176.32	165.65	10.67		+76.5	+74						
31				31+04	31+01.5							
	177.32	166.15	11.17		+29.5	+27						
					+54.5	+52						
					+80.5	+78						
32				32+05.5	32+03						12-17-74	12-4-18
				32+28.5	+26		#668					
	177.28	166.85	10.43		+47	+44.5	#237				5-8-86	
					+76.5	+74						3-30-11
33				33+02.5	33+00		#213				4-19-17	
					+22.5	+20						5-29-12
	178.28	167.55	10.73		+45.5	+43						
				33+54.5	+82.5	+80	#1146	#290			8-12-19	6-20-12
					+98.5	+96	#498	#372			6-14-20	4-24-11
34				34+32	34+29.5							
	177.78	168.25	9.53		+57	+54.5						
					+77	+74.5	#1363				11-10-19	
35				35+05	35+02.5							
					+30	+27.5						
	178.04	168.95	9.09		+53.5	+51	#486	#378			5-29-11	5-19-17
					+81.5	+79						
36				36+06.5	36+04							
	178.64	169.65	8.99		+31.5	+29						
				36+81.5								
5	168.31	157.32	10.99	5+63	5+60.5		#979		203 N. Yale		8-3-29	
				5+99(G.H.)	+89	+86.5	#470				6-15-21	
6	168.03	158.02	10.01	6+14.5	6+12		#471	#823			6-15-21	10-9-11
					+38.5	+36						
					+64	+61.5		#231				3-30-20
					+86.5	+84	#456				7-30-14	
7	169.33	158.72	10.61	7+00	7+11.5	7+09	#300				6-26-12	
					+37	+34.5		#274				5-13-18
					+65	+62.5	#181				4-15-18	
					+90.5	+88		#342				6-10-18
8	169.13	159.42	9.71	8+13.5	8+11		#125	#482	222 N. Clifton		2-26-25	
					+38.5	+36		#197			6-25-18	4-23-18
					+64	+61.5	#371					
					+89.5	+87						
9	164.83	160.12	4.71	9+17.5	9+15		#266	#183	237 N. Yale		5-10-18	1-9-60
					+42.5	+40	#198				4-23-18	4-15-18
					+67.5	+65		#460				10-8-12
					+93	+90.5	#188				5-15-16	
10	168.33	160.82	7.51	10+18	10+15.5		#1204	#34			9-4-19	1-20-20
	168.33	161.17	7.16	10+48.7	+43.5	10+41	#1204	#34	245 N R. Yale		see below	6-25-99
					+73	10+70.5	#522					6-17-21
					10+98	+95.5	#97				4-4-12	
11	167.33	161.81	5.52	11+18.5	11+16			#850				11-19-17
				11+98.5(G.H.)								

1999-00041-62599-245 N Yale - AE Henning - 4" SCH 40 - Predco 21' N of MH 10+48.7 (10+69.7) 1U22

#6409-6410-6411-3 Taps - 3612 E. First (Church) 11-12-51- Rex Robertson, Inc.
 #2005-Top - 225 1/2 N. Roosevelt - 4-19-45 - J.E. Lansdowne
 B762 - Seal off 224 N. Clifton 3-3-64 at Henning
 B763 - Seal off 226 N. Clifton 3-3-64 at Henning
 B964 - Seal off 228 N. Clifton 3-3-64 at Henning
 94-15404-7-9-36-94-248 N Clifton - 4" ABS Sol 40 - AL Tied onto main 10 Ft. N of The South property line.