



DIST. B-S.S. No. 12  
1911

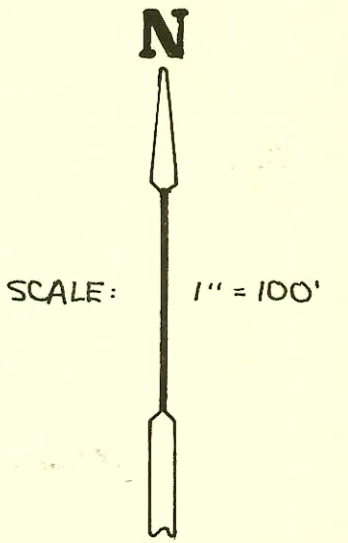

1992 SANITARY SEWER REHABILITATION PROGRAM-  
PHASE III  
PROJ. NO. 468-82220 (631879)  
BUILT BY INSITUFORM PLAINS, INC.  
BOOKED 8-25-93 FROM AS BUILTS

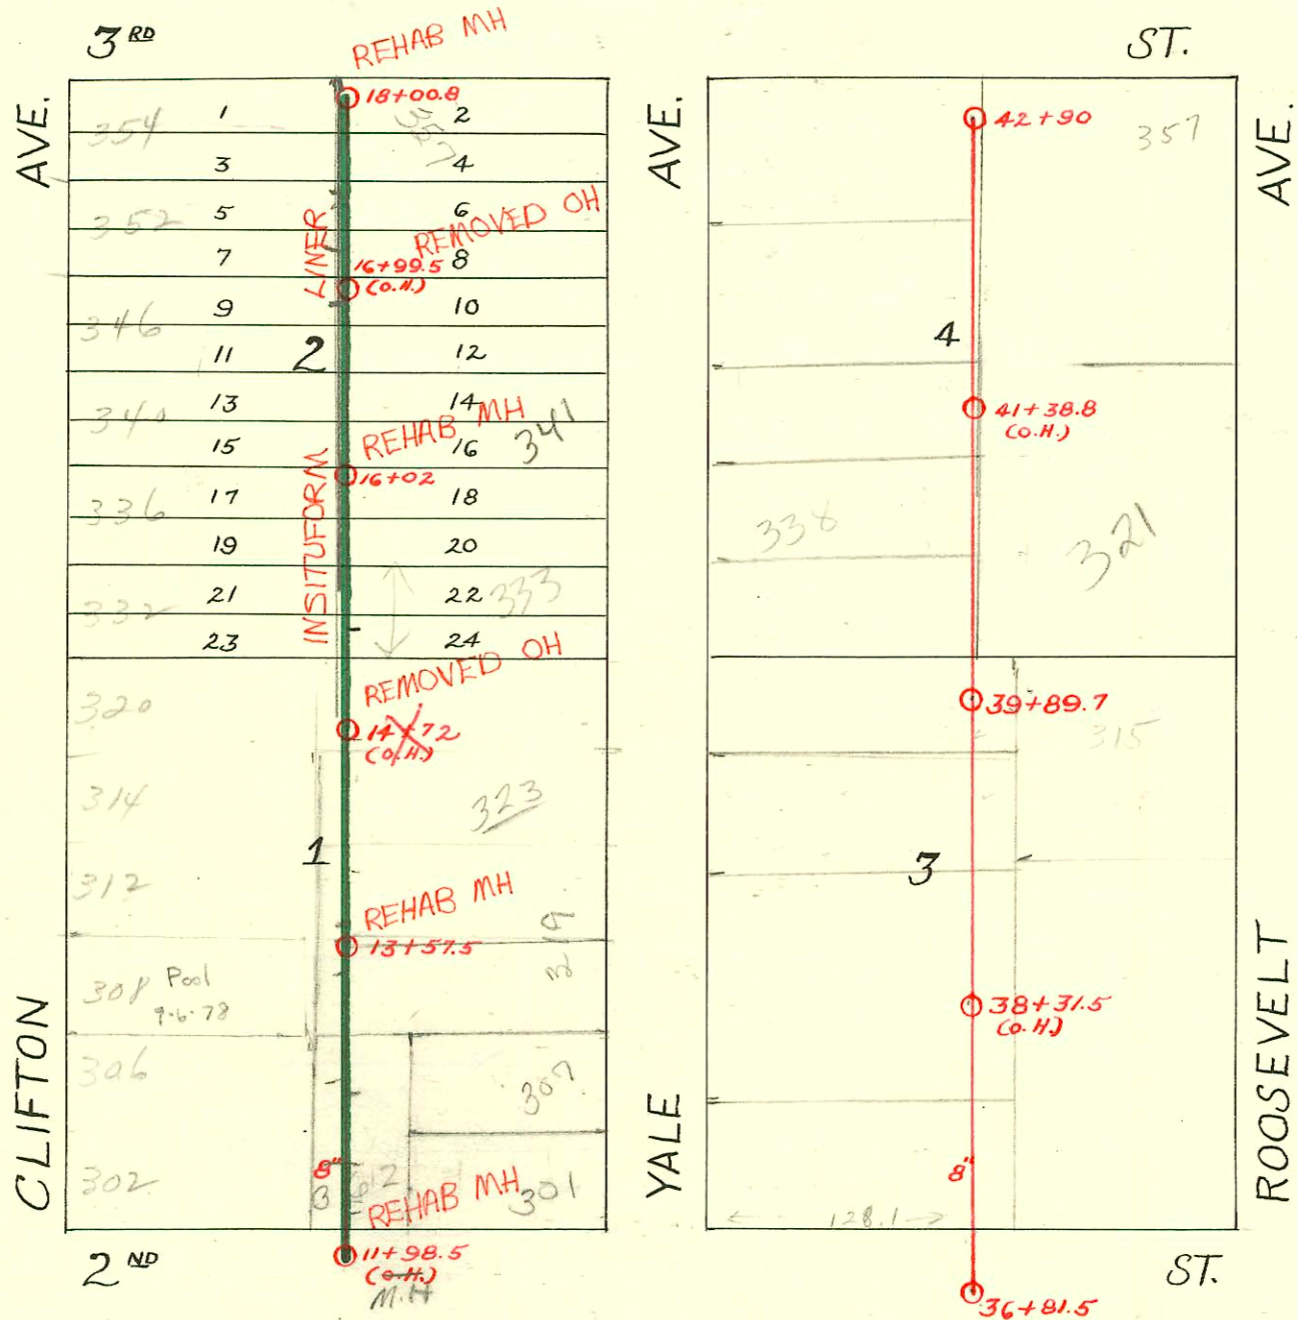

RECONNECTIONS

STATION	ADDRESS	DIRECTION
17+70.3	357 N. Yale	East
17+50.2	352 N. Clifton	West
17+20.8	349 N. Yale	East
17+10.7	354 N. Clifton	West
16+98.4	346 N. Clifton	West
16+71.4	345 N. Yale	East
16+49	340 N. Clifton	West
16+46.3	341 N. Yale	East
15+71.2	339 N. Yale	East
15+68.8	336 N. Clifton	West
15+23.9	332 N. Clifton	West
15+21.1	333 N. Yale	East
14+86.2	320 N. Clifton	West
14+85.6	327 N. Yale	East
14+34.5	314 N. Clifton	West
14+20.9	323 N. Yale	East
13+97.2	319 N. Yale	East
13+83.7	312 N. Clifton	West
13+45.9	308 N. Clifton	West
12+96.3	306 N. Clifton	West
12+76.7	307 N. Yale	East
12+46.8	302 N. Clifton	West
12+23.8	3612 E. 2ND	East
12+19.5	301 N. Yale	East

Repair #94-88965 11-21-94 Campbell

CONSTRUCTION RECORD						SERVICE RECORD						
STATION	ELEVATION		Depth	MANHOLE	4-INCH "Y" BRANCHES		No. of Permit		House Number		DATE OF PERMITS	
	Ground	Grade			North West	South East	North West	South East	North West	South East	North West	South East
36				36 + 81.5								
37	178.24	170.35	7.89		37 + 17.5 + 43.5 + 68.5 4" SCH 40 + 93.5	37 + 15 + 41 + 66 + 91	#1425		3702 E. 2nd		4-9-42	
38	179.45	171.05	8.40		38 + 19.5 + 45 + 70 + 95.5	38 + 17 + 42.5 + 67.5 + 93			310 RR Yale			3/25/62 7-17-62
39	178.75	171.75	7.00		39 + 21 + 45	39 + 18.5 + 43.5	#1153 #1026		320 N. Yale 326 N. Yale	315 N. Roosevelt	10-19-38 8-1-38	11-11-54 4-12-11
40	180.15	172.45	7.70	39 + 89.7 CITY WYE REP.	40 + 22.5 + 47.5 + 73.5 + 78.2 + 98.5	40 + 20 + 45 + 71 + 96	#2001-00586 19		338 N. Yale	See Below	3-19-01 1-13-20	
41	182.45	173.15	9.30		41 + 21.5 + 46.5 + 71.5 + 99.5	41 + 19 + 44 + 69 + 97	#498		321 Roosevelt		8-14-18	2-26-01 1-14-81
42	184.62	173.85	10.77		42 + 25 + 50.5 42 + 90 + 80.5	42 + 22.5 + 48 + 78	#1549		340 346 N. Yale		11-15-22	7-31-23
11	167.33	161.81	5.52	11 + 98.5 (6H)			#1431		301 N. Yale		12-30-19	
12	170.60	162.54	8.06		12 + 19 + 44 + 69.5 + 94.5	12 + 16.5 + 21.5 + 41.5 + 67 + 92	#324 #89 #1062 #12		302 N. Clifton 303 N. Yale 304 N. Clifton		2-17-14	7-10-19
13	171.10	163.27	7.83		13 + 20 + 45	13 + 17.5 + 42.5	#193		308 N. R. Clifton		4-20-18	
14	171.50	164.30	7.20		14 + 19.5 + 44.5 + 70	14 + 17 + 42 + 67.5	#66 #693 #186		312 N. Clifton 314 N. Clifton	323 N. Yale	2-26-20 2-2-20	8-21-18
15	173.80	165.70	8.10		15 + 21 + 46.5 + 72 + 97	15 + 18.5 + 44 + 69.5 + 94.5	#234 #335		320 N. Clifton 332 N. Clifton 336 N. Clifton	339 N. Clifton	8-11-11 5-1-18	4-16-18
16	175.97	167.10	8.87	16 + 02	16 + 19 + 44.5 + 70	16 + 16.5 + 42 + 67.5	#548 #167 #13		338 N. Clifton 346 N. Clifton	349 N. Clifton 345 N. Clifton	9-4-18	4-19-18 1-13-20
17	176.37	168.50	7.87		16 + 95.5 17 + 20.5 17 + 46 + 71 + 94	17 + 18 + 43.5 + 68.5 + 91.5	#848 #1115 #372		347 N. Clifton		4-16-19 7-31-19	1-13-20
18	176.47	169.90	6.57	18 + 00.8			#943		357 N. Yale		4-24-24	

This connection from 356 N. Clifton running from house to alley, then some 60' South parallel with City Sewer in order to get flow.

2001-00411-2/26/01-321 N Roosevelt - McClung's - 4" SCH 40 tied to clay tile 183's of MH 42+90 (41+07) tied to clay tile aprx 2' from main - 2-lugay co, 1023, 2 KICKFOOTS

2001-00586-3/19/01-338 N Yale - Shallow Plog - City Wye Repair 4" Fredco - 4" SCH 40 221' of MH 42+90 (40+78) 1V45

#9000 333 N. Yale (Bristol) 8-17-83 (2nd 16+02) #94-016965-333 N Yale - 11'-2 1/4" = 90' S of MH = 15+32 = 4" SCH 40 PVC  
 Tap #1774 - 307 N. Roosevelt - 8-15-39 #94-20495-7-12-27-94-301 N Yale - Replaced 8" Fr. of Sewer pipe at lower end 12+17.0 4" PVC 40  
 Tap #75 - 349 N. Roosevelt - 6-16-33 - C. C. Bryant  
 6400 Tap 315 N Roosevelt 3-31-52 of running (11' S. of 11+18.17) 39+18.17