


DIST. C - S.S. No. 12
1911

Alteration of Part of Dist C SS#12

Built By: W.R. Carter Const. Co. Inc.
Booked: Dec 16, 1970 from I.H.-7
Private Project.

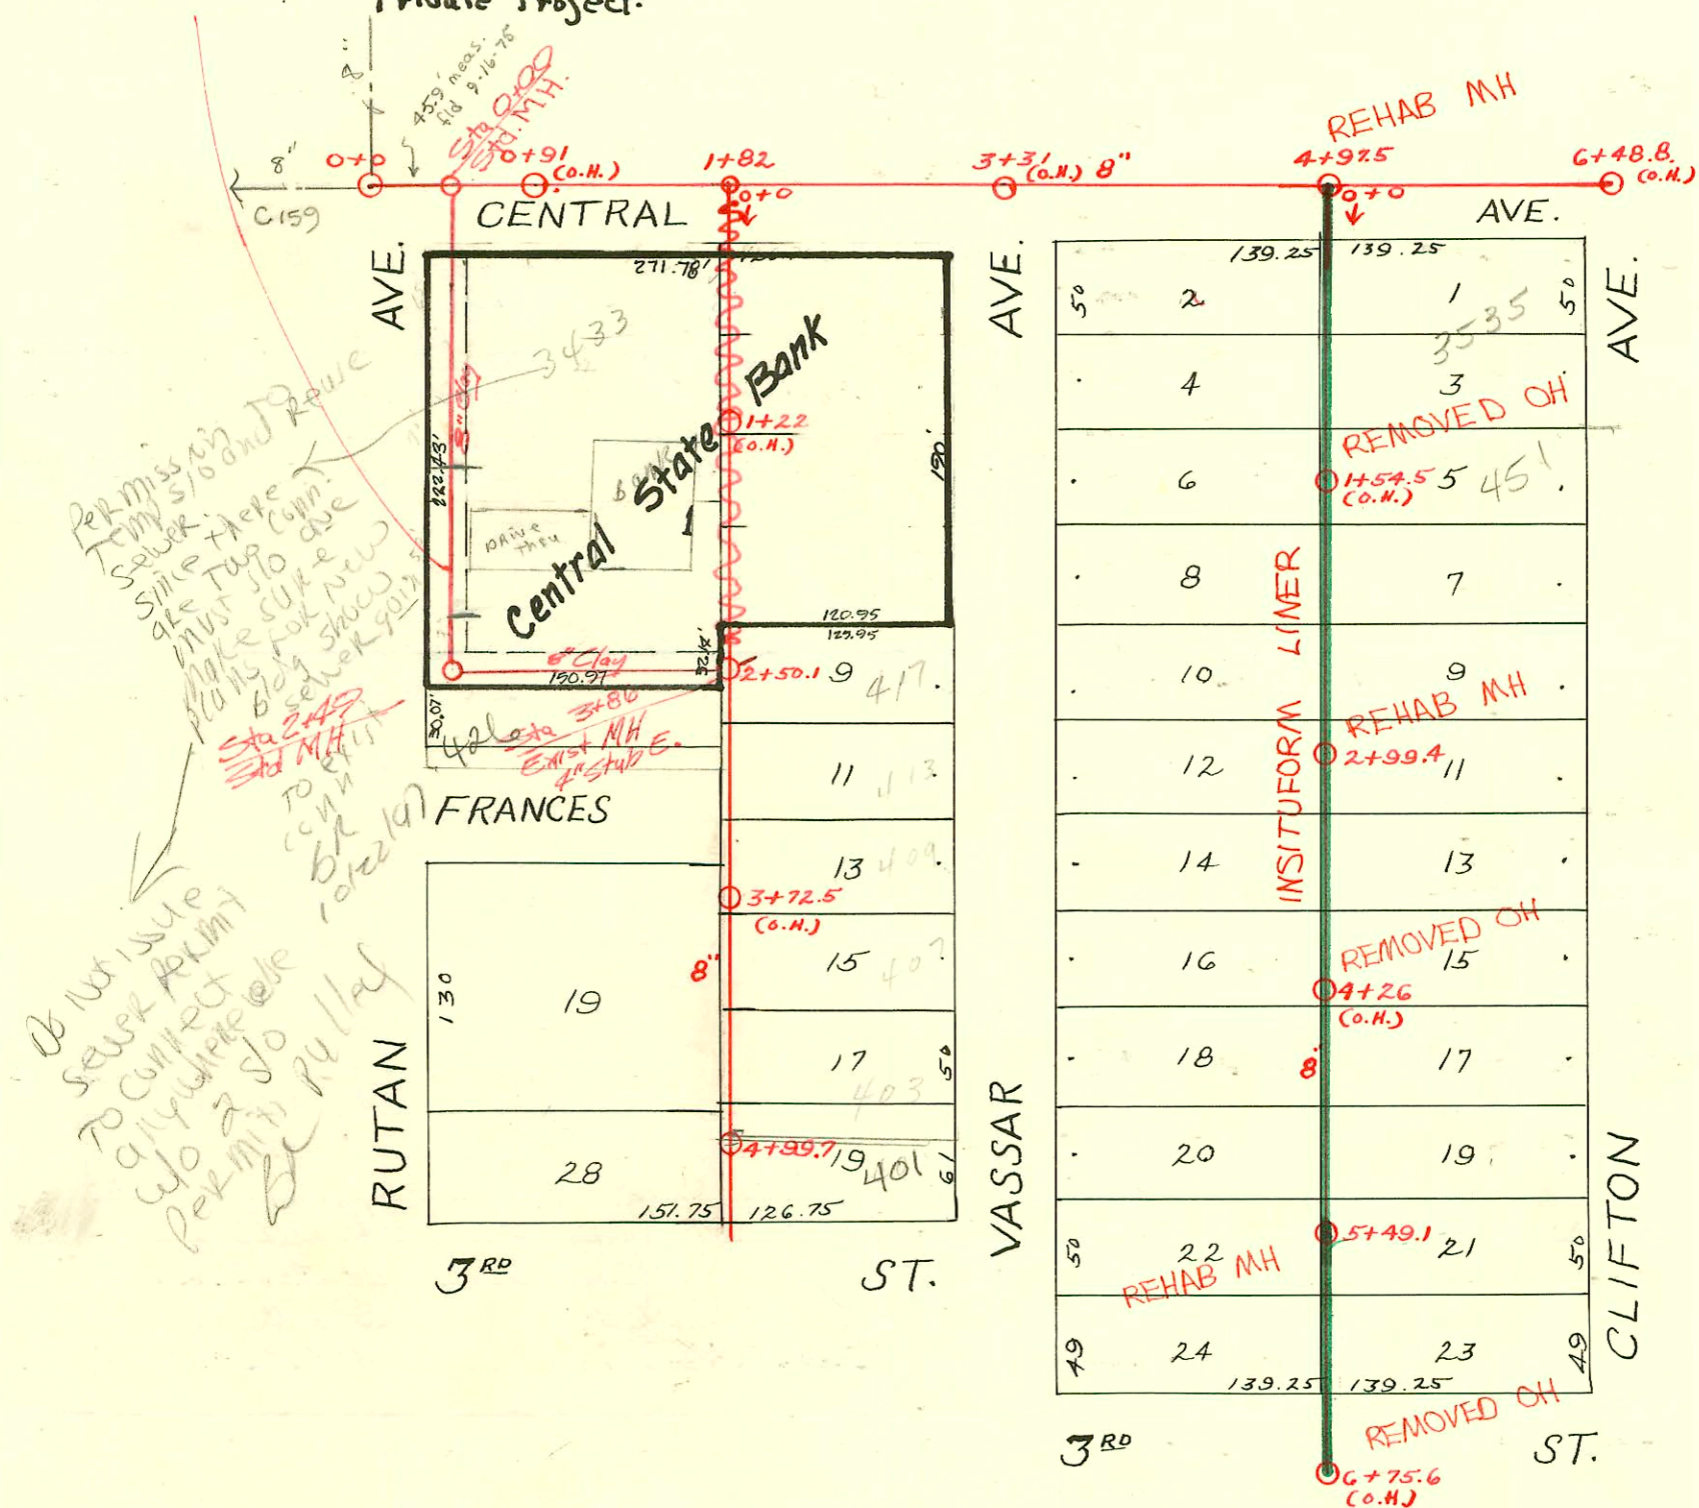

1992 SANITARY SEWER REHABILITATION PROGRAM - PHASE III
 PROD. NO. 468-82220 (631879)
 BUILT BY INSITUFORM PLAINS, INC.
 BOOKED 8-25-93 FROM AS BUILTS

RECONNECTIONS

| STATION | ADDRESS | DIRECTION |
|---------|---------------------|-----------|
| 5+38.1 | 407 N. Clifton | East |
| 5+36.7 | 410 N. Vassar | West |
| 5+19.8 | 414 N. Vassar | West |
| 4+78 | 411 N. Clifton | East |
| 4+63.7 | 416 N. Vassar | West |
| 4+53.6 | 415 N. Clifton | East |
| 4+25.7 | 421 N. Clifton | East |
| 3+79.6 | 426 & 428 N. Vassar | West |
| 3+53.7 | 425 N. Clifton | East |
| 3+30.7 | 430 N. Vassar | West |
| 2+95.6 | 435 N. Clifton | East |
| 2+71 | 445 N. Clifton | East |
| 2+47.9 | 434 N. Vassar | West |
| 1+95.6 | 447 N. Clifton | East |
| 1+45.7 | 451 N. Clifton | East |
| 1+10.1 | 3535 E. Central | East |
| 0+45.9 | 3535 E. Central | East |
| 5+88.7 | 402 N. Vassar | West |
| 6+00.9 | 401 N. Clifton | East |

96-144687

9-4-96

| CONSTRUCTION RECORD | | | | | | SERVICE RECORD | |
|---|
| STATION | ELEVATION | | Depth | MANHOLE | 4-INCH "Y" BRANCHES | | No. of Permit | | House Number | | DATE OF PERMITS | |
| | Ground | Grade | | | North West | South East | North West | South East | North West | South East | North West | South East | |
| 0 | 159.89 | 150.70 | 9.19 | 0+0 | 0 + 44.5 + 67 + 94 | 0 + 42 + 57 + 94 | #592 #672 #677 | #44767 #593 #6591 | 452 N 3535 E Central | 3535 E Central | 6-20-80 8-1-21 6-20-80 | 5-7-74 6-30-11 9-21-82 | |
| 1 | 160.19 | 152.20 | 7.99 | | 1 + 20.5 + 45.5 + 71.5 1 + 96.5 | 1 + 18 + 43 + 69 + 94 | #891 #1206 #595 | #1405 | 440 N Vassar 442 N Vassar | | 9-5-19 6-20-80 | 7-26-22 12-1-19 | |
| 2 | 160.89 | 153.70 | 7.19 | | 2 + 21.5 + 47 + 73 + 97 | 2 + 19 + 44.5 + 70.5 + 94.5 | #409 #596 #376 | #245 #245 | 446 N Vassar | | 7-9-18 6-26-31 | 6-14-16 4-27-17 | |
| 3 | 162.89 | 155.20 | 7.69 | 2 + 99.4 | 3 + 23 + 48 + 73 + 98.5 | 3 + 20.5 + 45.5 + 70.5 + 96 | #344 #1978 | #3 #4 | 480 N Vassar | | 8-29-16 | 9-2-24 1-2-18 1-2-18 | |
| 4 | 166.05 | 156.70 | 9.35 | | 4 + 23.5 + 49.5 + 75 + 99.5 | 4 + 21 + 47 + 72.5 + 97 | #722 #182 #722 | #265 #163 #267 | | | | 4-10-18 2-5-23 4-29-16 8-13-21 4-3-22 | |
| 5 | 167.75 168.45 | 158.20 158.95 | 9.55 9.50 | 5 + 49.1 | 5 + 24.5 + 42.5 + 71.5 + 86.5 | 5 + 22 + 40 + 69 + 84 | #1810 #1002 | #576 | | | 12-10-23 5-2-24 | 5-27-22 | |
| 6 | 168.73 | 159.15 | 9.58 | | 6 + 26.5 + 51 6 + 75.6 (o.H.) + 71.5 | 6 + 24 + 48.5 + 69 | |
| 0 | 145.53 | 139.86 | 5.67 | 0+00 | |
| 1 | 148.53 | 141.86 | 6.67 | |
| 2 | 150.93 | 143.49 | 7.44 | 1 + 82 | |
| 3 | 151.23 | 143.91 | 7.32 | |
| 4 | 154.53 | 146.17 | 8.36 | |
| 5 | 158.53 | 148.43 | 10.10 | | 4 + 97.5 | |
| 6 | 159.93 | 150.64 | 9.29 | | 6 + 48.8 (o.H.) | 6 + 42.5 | |
| 0 | 150.63 | 143.50 | 7.13 | 0+0 | 0 + 39.5 + 64.5 + 87 | 0 + 42 + 67 + 89.5 | #485 | #17220 #1018 #970 | 3315 E. Central | 451 451 | 6-11-65 5-7-25 | 12-8-64 7-11-23 4-30-24 | |
| 1 | 153.43 | 144.20 | 9.23 | | 1 + 12 + 40 + 68.5 + 93 | 1 + 14.5 + 42.5 + 71.5 + 95.5 | #1767 #2490 | #1770 #193 | 444 N Rutan | 434 N Rutan | 4-16-69 12-18-69 | 12-28-22 11-6-24 5-17-16 | |
| 2 | 154.83 | 144.90 | 9.93 | | 2 + 15.5 + 40.5 2 + 50.1 | 2 + 18 + 43 + 67 + 89.5 | #2491 #17219 #1321 | #9 #630 | 430 N Rutan | 430 N Rutan | 11-6-24 12-8-69 6-6-24 | 1-5-17 7-21-21 | |
| 3 | 153.43 | 145.60 | 7.83 | | 3 + 15 + 40 + 66 + 90.5 | 3 + 17.5 + 42.5 + 68.5 + 93 | #1022 #443 #543 | #1168 #338 #456 | | | 5-5-24 | 8-20-19 8-22-16 | |
| 4 | 154.43 | 146.30 | 8.13 | | 4 + 16.5 + 42 + 67 4 + 99.7 | 4 + 19 + 44.5 + 71 + 92 | #1469 #1970 | #235 #1280 | 407 N Rutan | 407 N Rutan | 10-5-23 5-20-12 8-29-24 | 6-1-20 8-28-23 | |
| <p>Alteration of Part of Dist C, 55*12</p> <table border="1"> <tr> <td>0+00</td> <td>147.2</td> <td>143.60</td> <td>3.6</td> <td>0+00</td> <td></td> <td></td> <td></td> <td></td> <td></td> <td></td> <td></td> <td></td> </tr> <tr> <td>1+00</td> <td>147.3</td> <td>143.80</td> <td>3.5</td> <td></td> <td>1 + 45.7</td> <td></td> <td></td> <td></td> <td>3433 E Central</td> <td></td> <td>4-1-81</td> <td>1-27-71</td> </tr> <tr> <td>2+00</td> <td>147.7</td> <td>144.00</td> <td>3.7</td> <td></td> <td>2 + 17.7</td> <td></td> <td></td> <td></td> <td>3433 E Central</td> <td></td> <td>4-9-81</td> <td>1-23-81</td> </tr> <tr> <td>3+00</td> <td>148.1</td> <td>144.10</td> <td>4.0</td> <td>2+49'</td> <td></td> <td></td> <td></td> <td></td> <td></td> <td></td> <td></td> <td></td> </tr> <tr> <td></td> <td>148.3</td> <td>144.64</td> <td>3.7</td> <td></td> <td></td> <td></td> <td></td> <td></td> <td>3433 N Central</td> <td></td> <td>4-9-81</td> <td></td> </tr> <tr> <td></td> <td>155.0</td> <td>145.48</td> <td>9.9</td> <td>3+86'</td> <td>Exist MH 4" Stub East</td> <td></td> <td></td> <td></td> <td></td> <td></td> <td></td> <td></td> </tr> </table> | | | | | | | | | | | | | 0+00 | 147.2 | 143.60 | 3.6 | 0+00 | | | | | | | | | 1+00 | 147.3 | 143.80 | 3.5 | | 1 + 45.7 | | | | 3433 E Central | | 4-1-81 | 1-27-71 | 2+00 | 147.7 | 144.00 | 3.7 | | 2 + 17.7 | | | | 3433 E Central | | 4-9-81 | 1-23-81 | 3+00 | 148.1 | 144.10 | 4.0 | 2+49' | | | | | | | | | | 148.3 | 144.64 | 3.7 | | | | | | 3433 N Central | | 4-9-81 | | | 155.0 | 145.48 | 9.9 | 3+86' | Exist MH 4" Stub East | | | | | | | |
| 0+00 | 147.2 | 143.60 | 3.6 | 0+00 | |
| 1+00 | 147.3 | 143.80 | 3.5 | | 1 + 45.7 | | | | 3433 E Central | | 4-1-81 | 1-27-71 | |
| 2+00 | 147.7 | 144.00 | 3.7 | | 2 + 17.7 | | | | 3433 E Central | | 4-9-81 | 1-23-81 | |
| 3+00 | 148.1 | 144.10 | 4.0 | 2+49' | |
| | 148.3 | 144.64 | 3.7 | | | | | | 3433 N Central | | 4-9-81 | |
| | 155.0 | 145.48 | 9.9 | 3+86' | Exist MH 4" Stub East | |
| <p>2003-00430-2118103- Roto Rooter - 4" PE SDR17-pipe burst replace, 4" 40 PVC 1V45, 1V22, 1 6x4 Bush, 2 Fernco clamp - 6" Predco by city - 6x4 Bush 7.6' S of MH 4192.7 (5107.3)</p> | |

Seal off #13 28621 - 450 N Rutan - Roto Rooter Service 2-17-65