


DIST. C - S.S. No. 12
1911



SWR2006-00004-327 N Hillside Tap-52' south of mt (1) twin clo (122) - ME Todd 3-8-04

Scale: 1"=100'

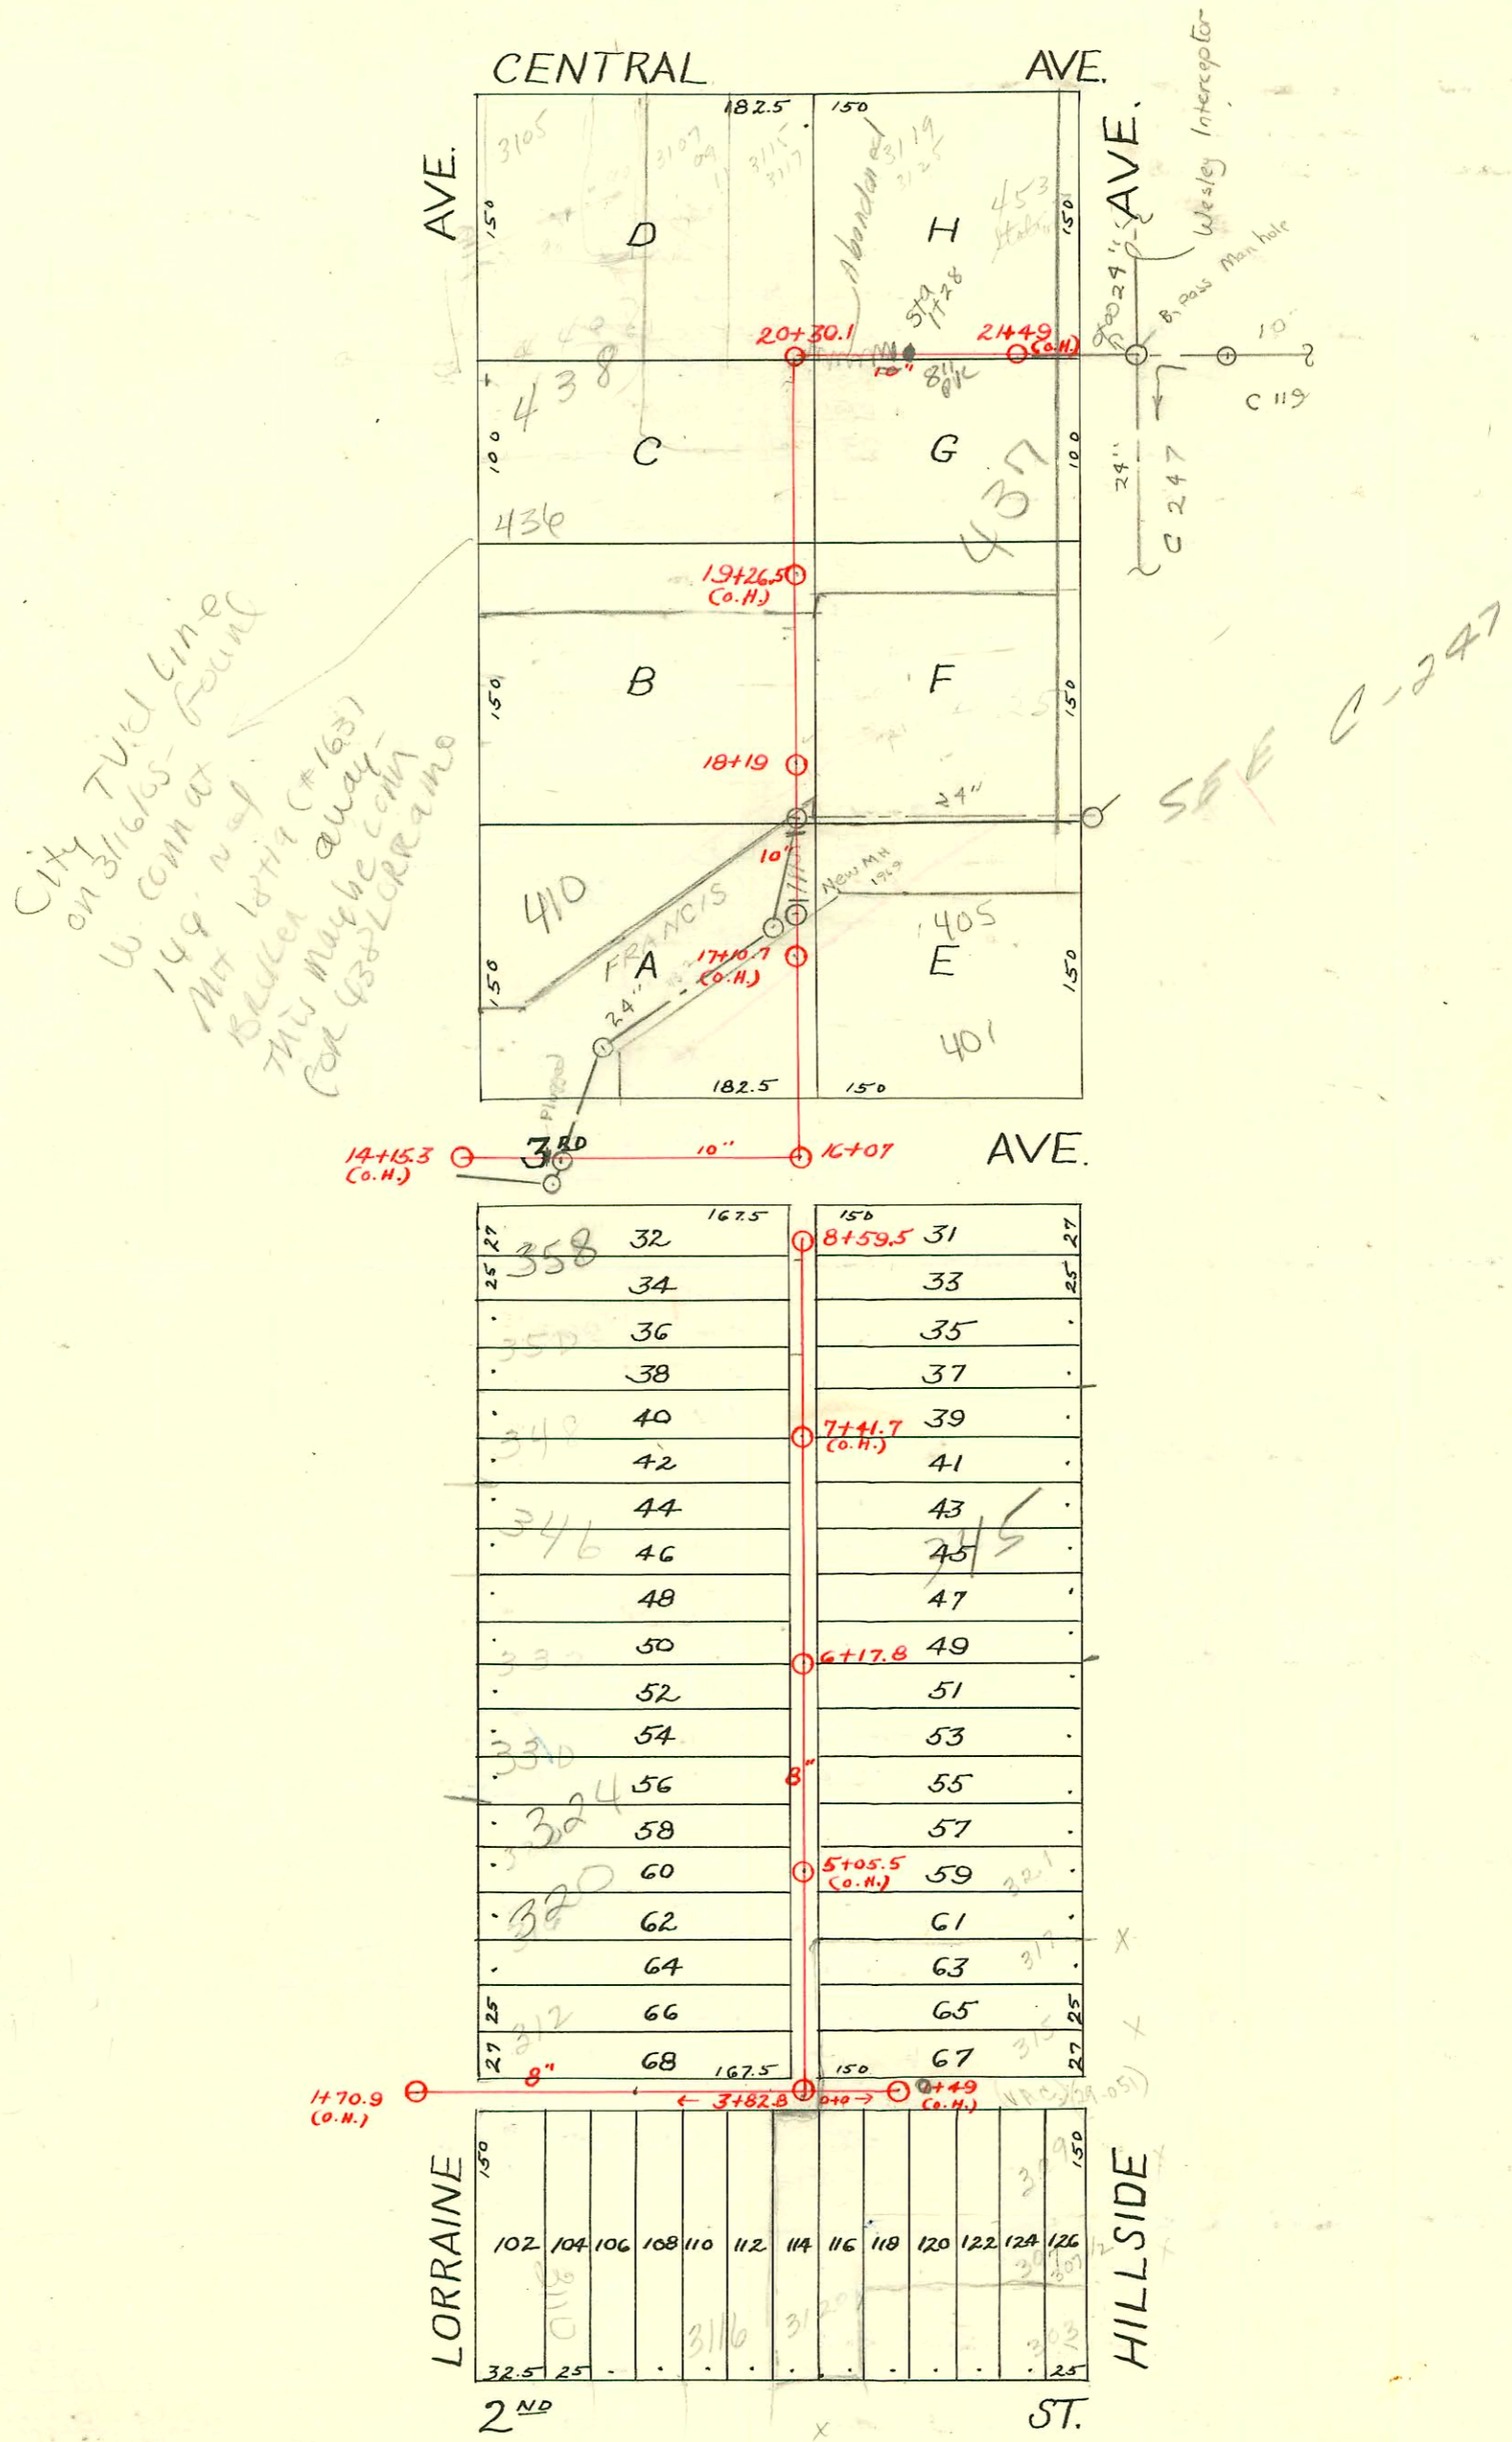