


DIST. B-S.S. No. 12  
1911



2006-00303-2/3/06 - 200 N Green - Newpedrobjcity, (2)221 (1)1510/10 80.2' NymH - Benjamin Franklin

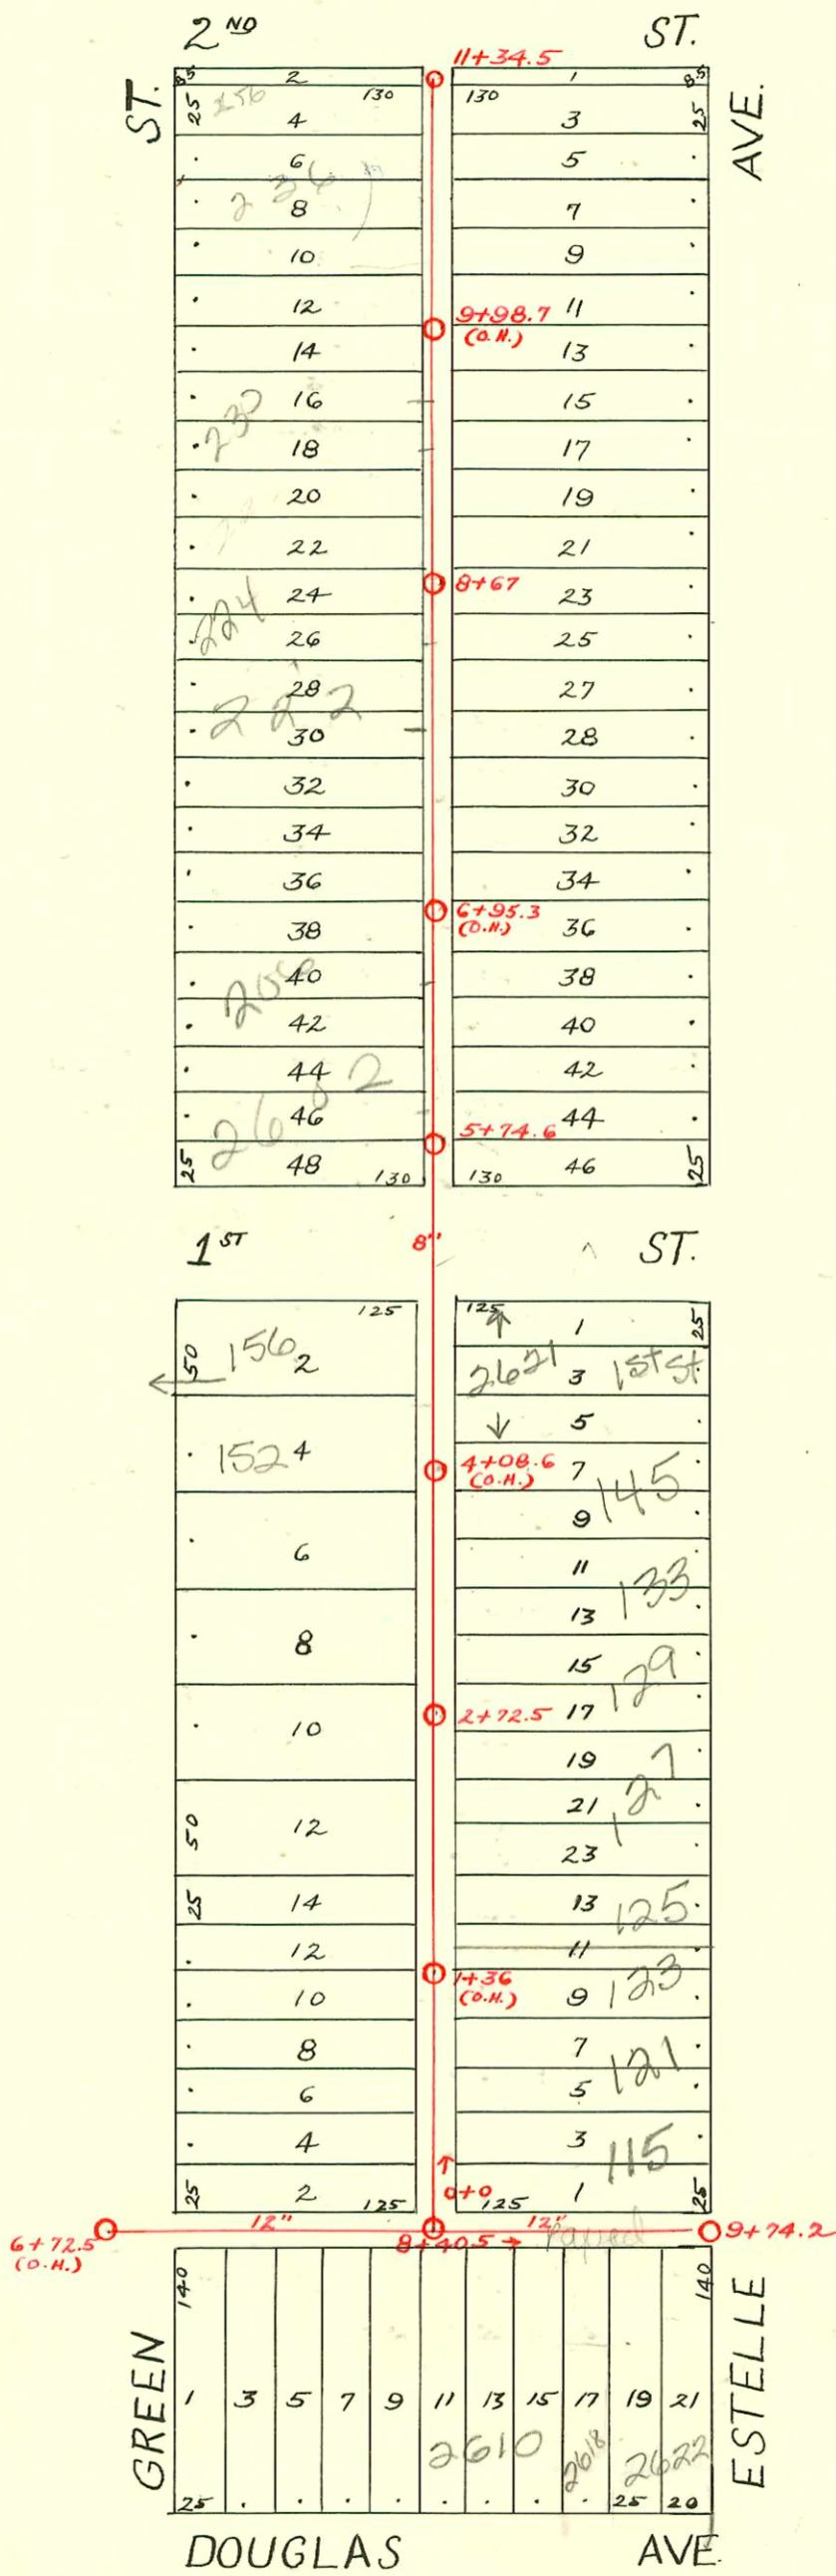