


DIST. H- S.S. No. 12  
1911

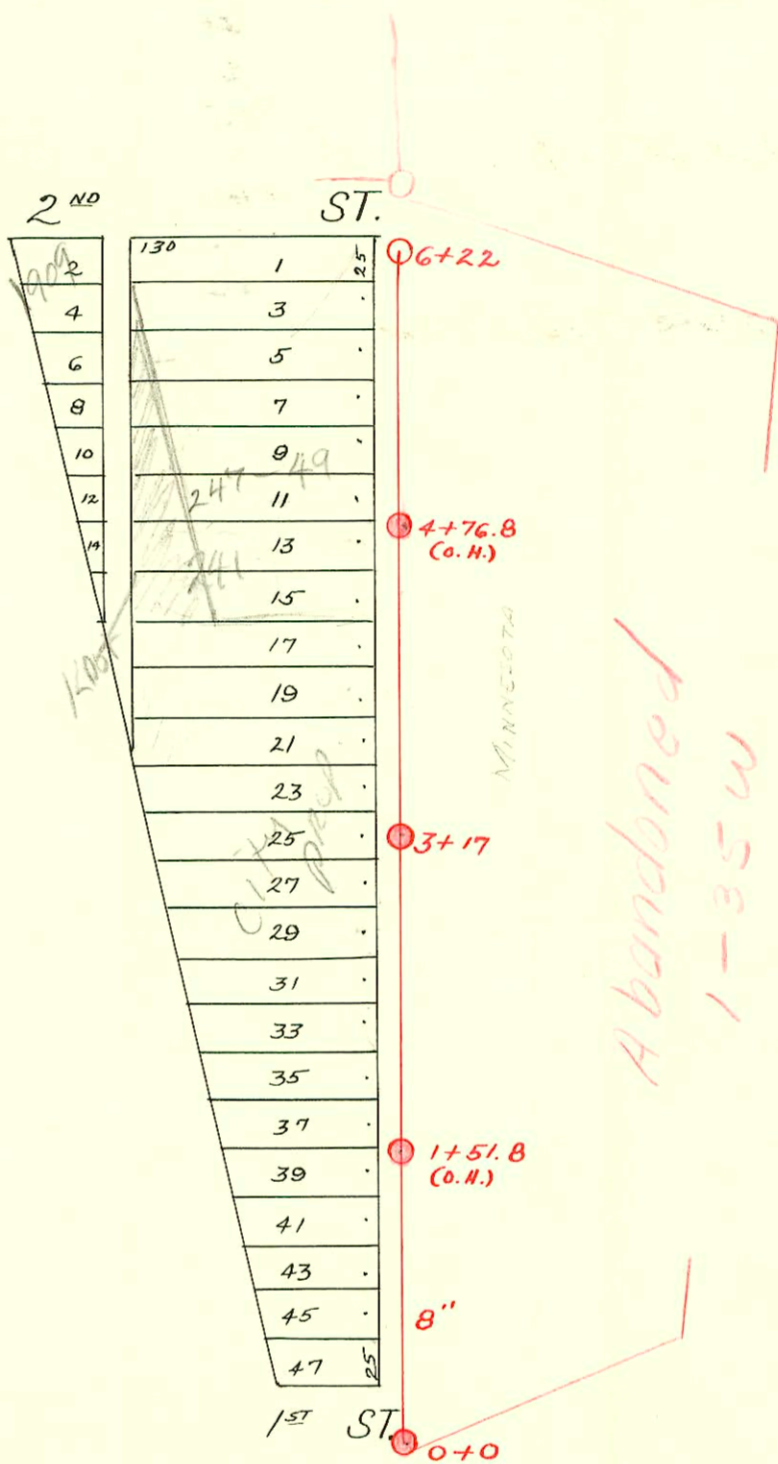

CONSTRUCTION RECORD							SERVICE RECORD					
STATION	ELEVATION		Depth	MANHOLE	4-INCH "Y" BRANCHES		No. of Permit		House Number		DATE OF PERMITS	
	Ground	Grade			North West	South East	North West	South East	North West	South East	North West	South East
0	109.42	104.15	5.27	0 + 0	0 + 32 + 55 + 79							
1	109.99	104.25	5.74		1 + 05 + 31 + 57 + 83		#546					3-24-24
2	110.55	104.35	6.20		2 + 09 + 36 + 61 + 87		#332					6-5-18
3	111.12	104.45	6.67	3 + 17	3 + 13 + 39 + 64 + 90		#798 #330					10-25-20 6-5-18 10-2-20
4	111.94	104.55	7.39		4 + 16 + 41 + 67 + 93		#232					3-31-21
5	112.05	104.65	7.40		5 + 19 + 44 + 70 + 96		#326					7-25-66 3-5-23
6	111.77	104.75	7.02	6 + 22			#4943 #112 #10394 #1518 #1184		247-49 N. Minnesota 1909 E. 2 No			9-21-67 12-14-62 9-9-60 10-23-29 11-29-21-67