


DIST. E - S.S. No. 12  
1911

ST.	13 <sup>TH</sup>	138.5	138.5	12+75.8' 98	ST.
25	97	138.5			25
	99				100
	101	8"			102
	103				104
	105				106
	107				108
	109				110
	111				112
	113				114
	115		10+65.5		116
	117				118
	119				120
	121				122
	123				124
	125				126
	127				128
13	129				130
	131		8+55.7		132
	133				134
13	135				136
	137				138
	139				140
	141				142
25	143	138.5	138.5	144	25

	12 <sup>TH</sup>	138.5	138.5	6+95.4	ST.
25	145	138.5			25
	147				148
	149				150
12	151				152
	153				154
	155				156
	157				158
	159		4+29.6		160
	161				162
12	163				164
	165				166
	167				168
	169				170
	171				172
	173				174
	175				176
	177		2+15		178
	179				180
	181				182
	183				184
	185				186
	187	8"			188
25	189				190
ASH	191	138.5	138.5	192	MADISON

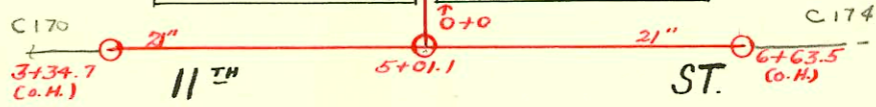

CONSTRUCTION RECORD

SERVICE RECORD

Line in 11<sup>th</sup>

STATION	ELEVATION		Depth	MANHOLE	4-INCH "Y" BRANCHES		No. of Permit		House Number		DATE OF PERMITS	
	Ground	Grade			North West	South East	North West	South East	North West	South East	North West	South East
3	116.25	108.20	8.05	3 + 34.7(6.H)								
4	116.22	108.40	7.82									
5	116.44	108.60	7.84	5 + 01.1								
6	116.67	108.80	7.87	6 + 63.5(0.H)								
0+0	116.37	109.40	6.97	0 + 0	0 + 30.5 4" SCH 40 + 57.0	0 + 28 + 54.7	2002-01101	13882	1204 Ash	1201 N. Madison	4-18-02	2-20-61
1+0	116.30	109.50	6.80		+ 85.7 4" SCH 40 1 + 11.0 + 37.3 4" SCH 40 1 + 63.0 + 89	+ 83.2 1 + 08.7 + 34.8 + 61.2 + 86.5	2007-01101 #47742 #4996 1537 #01123 #36	1208 Ash 1212 N. Ash 1214-16 N. Ash	1205-07 N. Madison	4-18-02 10-17-72 6-17-50 4-18-02	5-24-94 7-28-53	
2+0	116.62	109.60	7.02	2 + 15	2 + 26.5 + 50.2 + 77.1	2 + 24 + 47.7 + 74.6	#01154 #3407	#023830	1220 N. Ash	1215-17 N. Madison	8-9-66 2-21-50	4-20-71
3+0	116.52	109.70	6.82	3 + 0	3 + 02.5 + 28.7 + 54.2 + 80.5	3 + 00 + 26.2 + 51.7 + 78	#172 #5233 #234	#2606 #2607	1226 N. Ash 1234 N. Ash 1236 N. Ash	1225 N. Madison 1231 N. Madison	3-22-50 10-17-83 5-18-53	11-15-54 11-15-54
4+0	116.28	109.80	6.48	4 + 0 4 + 29.6	4 + 06.5 + 36.1 + 62.1 + 88	4 + 04 + 33.6 + 59.6 + 85.5	#4381	#2608 #2609	1238 N. Ash 1243 N. Madison	1237 N. Madison	10-4-35 3-9-53	11-15-54 11-15-54
5+0	116.40	109.90	6.50	5 + 0	5 + 11.3 4" PVC 5 + 37.8 + 63 + 88	5 + 08.8 + 35.3 + 60.5 + 85.5	2003-01101 #1148	#2610 #384	1257 N. R. Ash 1253 N. Madison	1249 N. Madison 1253 N. Madison	2-25-03 6-18-56	11-15-54 3-22-54
6+0	116.35	110.00	6.35	6 + 0 6 + 45.4	6 + 14.5 + 91.9	6 + 12 + 89.4	2411	#1275	1258 N. Ash	1257 N. Madison	6-18-56	8-18-49
7+0	116.58	110.10	6.48	7 + 0	7 + 17.8 + 44 + 69.5 + 95.2	7 + 15.3 + 41.5 + 67 + 92.7	#939	#2857	1302 N. Ash	1301 N. Madison	9-17-56	3-23-46
8+0	116.61	110.20	6.41	8 + 0 8 + 55.7	8 + 20.1 + 47.1 + 75.3	8 + 17.6 + 44.6 + 72.8	#0706 #939	#30889	1306 N. Ash	1307 N. Madison	4-12-77 10-9-30	10-27-86 2-6-58
9+0	116.90	110.30	6.60	9 + 0	9 + 01.5 + 27.1 + 52.7 + 79.7	9 + 99 + 24.6 + 50.2 + 77.2	#2577 #12223	#3243	1320 N. Ash 1322 N. Ash	1317-19 N. Madison	9-18-52 1-16-69	5-24-67
10+0	116.63	110.40	6.23	10 + 0 10 + 65.5	10 + 04.5 + 31 + 56.4 + 82.5	10 + 02 + 28.5 + 53.9 + 80		#276		1325 N. Madison		6-4-37
11+0	116.26	110.50	5.76	11 + 0	11 + 08 + 33.5 + 59.5 + 85.5	11 + 05.5 + 31 + 57 + 83		#109 #6149 #909 #368		1337 N. Madison 1344 N. Madison 1357 N. Madison		3-9-31 10-16-51 6-7-38
12+0	116.28	110.60	5.68	12 + 0	12 + 11 + 36.5	12 + 08.5 + 34	#924		1350 N. Ash		3-17-52	
12+ 75.8	116.51	110.68	5.83	12 + 75.8	+ 62.5	+ 60			2105 E. 13 <sup>th</sup>		9-13-48	

2003-00514-2/25/03-1254 N Ash - Padgett Ex - City Wye repair 4" Predeo 107.6' S of MH 6+45.4(5737.8) dirt alley looks abandoned - 4" 40 PVC 2H45, 1H22, 1V45,

Tap 2505 1240 N Ash 9-21-56