


S.S. No. 12 - DIST. E  
1911

13 <sup>TH</sup> ST.	25	2	135	135	12+71	1	25
		4	8"			3	
		6				5	
		8				7	
		10				9	
	1350	12				11	
		14				13	
		16				15	
	1336	18		10+70.5		17	1331
		20				19	
		22				21	1333
		24				23	
		26				25	1325-27
		28				27	
		30				29	
		32				31	
		34		8+62		33	1317
		36				35	
		38				37	
		40				39	
		42				41	
		44				43	
	1304	46				45	
25		48	2408	135		47	25

1991 SAN. SEW RECONSTRUCTION  
PROGRAM PHASE III  
BUILT BY INSITUFORM PLAINS

LAT. A - DIST. E - S.S. No. 12.  
1924

12 <sup>TH</sup> ST.	25	50	135	135	49	25
		52			51	
		54			53	
		56			55	
		58			57	
		60			59	
		62			61	
	1242	64		4+41.5	63	
		66			65	
	1238	68			67	
		70			69	
		72			71	
		74			73	
		76			75	
		78			77	
		80			79	
		82		2+19	81	
		84			83	
		86			85	
		88			87	
		90			89	
		92			91	
		94			93	
		96	135	135	95	

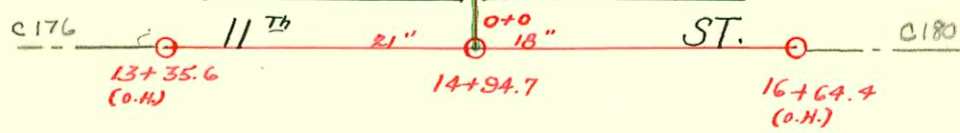

SWR 2000-00502 (1227 N Poplar) 510 - 153.5' sg mH - 6' from main - JJS pm 2/24/00

CONSTRUCTION RECORD						SERVICE RECORD						
STATION	ELEVATION		Depth	MANHOLE	4-INCH "Y" BRANCHES		No. of Permit		House Number		DATE OF PERMITS	
	Ground	Grade			North West	South East	North West	South East	North West	South East	North West	South East
13	118.93	110.20	8.73	13 + 35.6 (C.H.)								
14	119.30	110.40	8.90									
	119.57	110.62	8.95	14 + 94.7								
15	119.64	111.05	8.59									
16	120.16	111.75	8.41	16 + 64.4								
0 + 0	119.26	111.97	7.29	0 + 0	0 + 33.9	0 + 31.4	#1216	#562	1204 N. Grove	1201 N. Poplar	3-18-42	6-29-26
					+ 59.8	+ 57.3						
					+ 85	+ 82.5						
1 + 0	119.11	112.12	6.99	1 + 10	1 + 07.5		#573		1210 N. Grove		11-14-41	
					+ 36.3	+ 33.8						
					+ 62	+ 59.5	#3942		1214 N. Grove		7-30-41	
					+ 87.8	+ 85.3						
2 + 0	119.06	112.27	6.79	2 + 13.5	2 + 11		#124		1220 N. Grove		7-21-59	6-17-26
				2 + 19	+ 36.9	+ 34.4	#570		1215 N. Poplar		8-2-48	8-20-25
					+ 62.5	+ 60	#576		?		8-2-48	1-27-47
					+ 88	+ 85.5	#1330		1227 N. Poplar			11-2-26
							#940		1245 N. Poplar			
3 + 0	118.89	112.42	6.47	3 + 14.1	3 + 11.6		#40	#1329	1230 N. Grove	1231 N. Poplar	3-13-35	1-27-47
					+ 39.5	+ 37		#1076	1236 N. Grove	1209 N. Poplar		9-30-25
					+ 64.5	+ 62	#652		1236 N. Grove	1239 N. Poplar	11-21-41	1-21-03
					+ 90.2	+ 87.7	#2003		1242 N. Grove	1243 N. Poplar		10-23-26
4 + 0	118.76	112.57	6.19	4 + 16	4 + 13.5		#907		1242 N. Grove	1243 N. Poplar	3-21-47	4-30-29
				4 + 41.5	+ 36.5	+ 34	#1658		1248 N. Grove	1248 N. Poplar	#-8392	
					+ 60.5	+ 58	#461					
					+ 85.2	+ 82.7	#3182					
5 + 0	118.89	112.72	6.17	5 + 10.9	5 + 08.4		#489		1252 N. Grove	1249 N. Poplar	5-12-30	7-7-48
					+ 36.9	+ 34.4		#358	1258 N. Grove	1255 N. Poplar	9-17-30	3-7-46
					+ 63	+ 60.5	#871					
					+ 88.5	+ 86						
6 + 0	119.28	112.87	6.41	6 + 13.2	6 + 10.7							
					+ 91	+ 88.5	#2158	#1105	1302 N. Grove	1303 N. Poplar	9-14-42	12-24-26
7 + 0	119.39	113.02	6.37	7 + 16.3	7 + 13.8		#91		1308 N. Grove	1309 N. Poplar	3-21-40	5-28-47
					+ 42.2	+ 39.7		#1574			5-28-47	11-1-29
					+ 67.7	+ 65.2						
					+ 93	+ 90.5						
8 + 0	119.36	113.17	6.19	8 + 16.1	8 + 18.5		#877	#877	1312 N. Grove	1311 N. Poplar	1-14-42	10-13-26
				8 + 62	+ 41.7	+ 44.2	#89	#1344	1316 N. Grove	1319 N. Poplar	5-28-47	6-19-50
					+ 67	+ 69.5						
					+ 92.3	+ 94.8		#1345	1321 N. Poplar			6-19-50
9 + 0	119.44	113.32	6.12	9 + 18.5	9 + 21.5		#88	#918	1320 N. Grove	1323 N. Poplar	5-28-47	8-28-70
					+ 43.4	+ 45.9	#1659		1328 N. Grove	1325 N. Poplar	5-28-47	10-27-26
					+ 69.5	+ 72					6-19-39	4-20-71
					+ 94.7	+ 97.2	#646	#1996	1332 N. Grove	1333 N. Poplar	11-20-41	12-2-46
10 + 0	119.53	113.47	6.06	10 + 21	10 + 23.5		#837	#1101	1346 N. Grove	1333 N. Poplar	9-5-30	8-21-50
				10 + 70.5	+ 45.8	+ 48.3						6-9-72
					+ 76.5	+ 79						12-14-27
					+ 96.8	+ 99.3	#4641		1342 N. Grove		7-16-80	
11 + 0	119.83	113.62	6.21	11 + 22.7	11 + 25.2		#397			1347 N. Poplar	5-14-51	5-17-27
					+ 48	+ 50.5	#784		1350 N. Grove		4-12-68	
					+ 74	+ 76.5	#676		1348 N. Grove		12-11-67	
					+ 99	+ 101.5	#673	#110		1351 N. Poplar	5-15-51	5-29-47
12 + 0	120.03	113.77	6.26	12 + 22	+ 24.5		#441			1351 N. Poplar	4-30-25	
					+ 47	+ 49.5						
12 + 71	120.43	113.88	6.55	12 + 71	+ 64	+ 66.5						

Repair - 1-25-79 - 1345 N. Poplar - C70176 - Campbell (11+22)

#6130 - Tap - 1348 1/2 N. Poplar - Dermody P/bg. Co. - 10-16-51  
 #7226 - Tap - 2408 E. 12th - 12-15-53 - Frederick P/bg. Co.  
 93-18801-7 7-19-93 1245 N Poplar - Henning  
 5/0 67' N of MH (5+08.5) edge of alley 4" Clay