


S.S. No. 12 - Dist E - 1911
Dist G - 1912

1995 SANITARY SEWER REHABILITATION PROGRAM - PHASE IV
PROJ. NO. N/A (621128)
BUILT BY W. B. CARTER CONST. CO.
BOOKED 7/29/96 FROM AS BUILTS

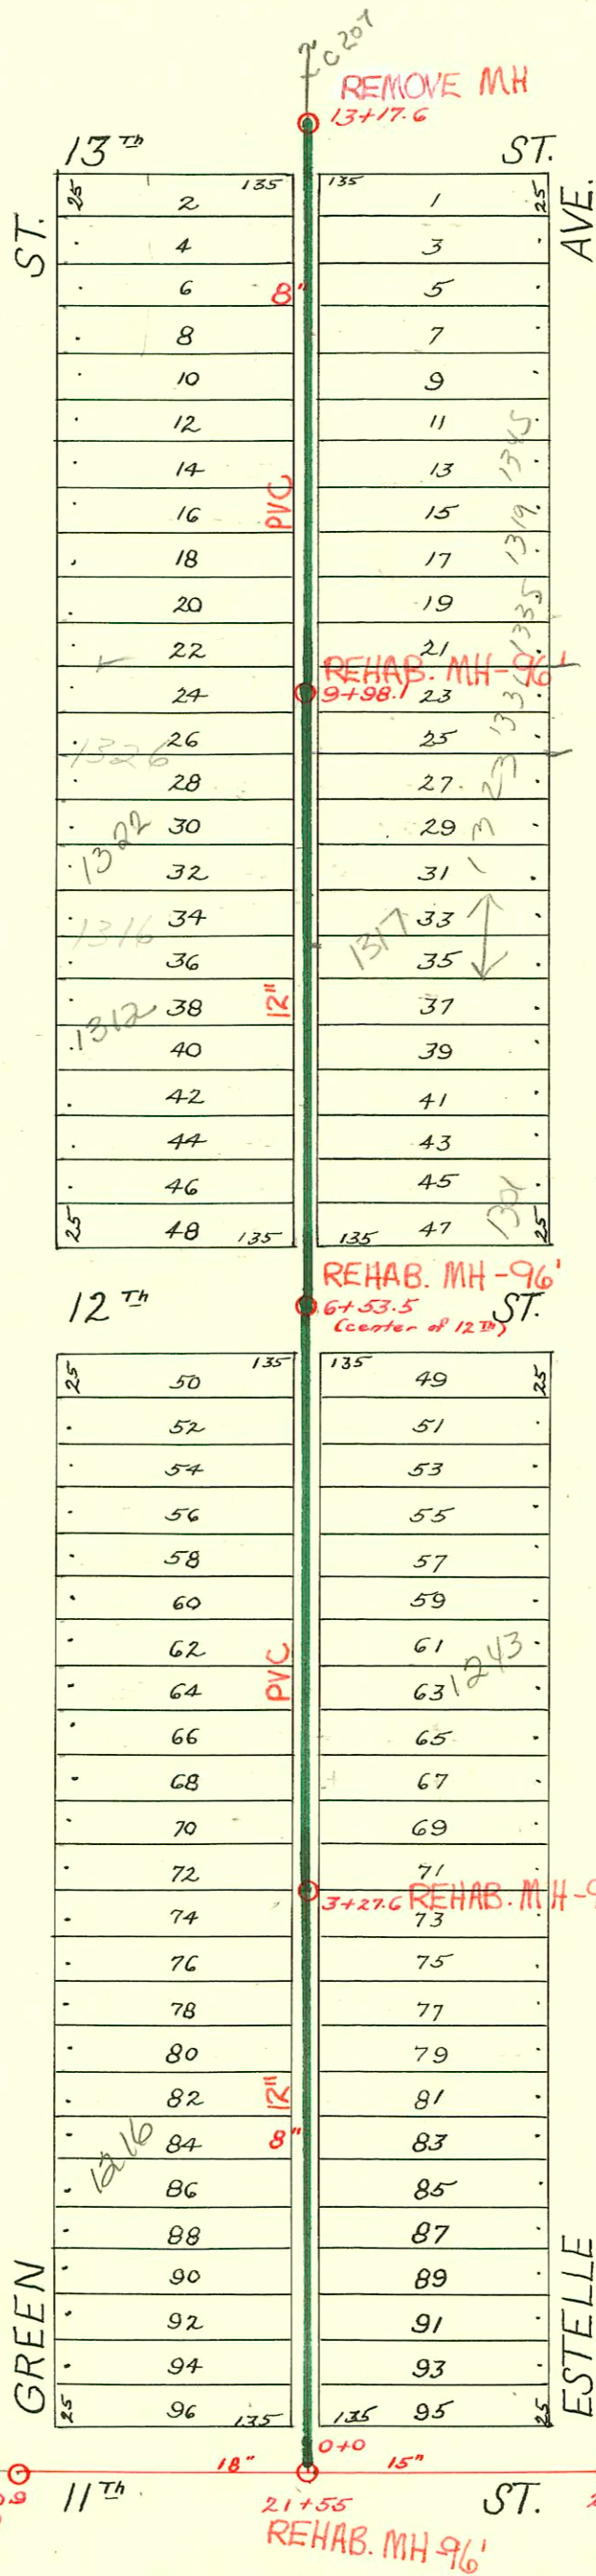

RECONNECTIONS

STA.	ADDRESS	DIRECTION
0+33	1202 N. Green	Left
0+56	1201 N. Estelle	Right
0+82	1207 N. Estelle	Right
1+60.5	1211 N. Estelle	Right
1+85	1217 N. Estelle	Right
1+86.5	1216 N. Green <i>see below</i>	Left
2+36	1223 N. Estelle	Right
2+40.5	1222 N. Green	Left
2+88	1228 N. Green	Left
3+36.5	1233 N. Estelle	Right
3+38.5	1232 N. Green	Left
3+83.5	1239 N. Estelle	Right
3+92	1238 N. Green	Left
4+92	1244 N. Green	Left
5+48	1253 N. Estelle	Right
5+90	1257 N. Estelle	Right
5+95	1258 N. Green	Left
7+06	1301 N. Estelle	Right
7+10	1302 N. Green	Left
7+56	1304 N. Green	Left
8+06	1311 N. Estelle	Right
8+08	1312 N. Green <i>see below</i>	Left
8+54	1316 N. Green	Left
9+07.5	1322 N. Green	Left
9+11.5	1323 N. Estelle	Right
9+40	1326 N. Green	Left
9+66	1331 N. Estelle <i>see below</i>	Right
9+90	1328 N. Green	Left
11+80	1351 N. Estelle	Right
11+94	1358 N. Green	Left
11+97	2007 E. 13TH	Left
12+50	2611 E. 13TH	Left

2004-00287 712104 1216 N Green
Glover - tied to claytile around
15' from house - stopped 3' from
main - twinco, 2v22

1331 N Estelle - Repair
2003-00118 - 114103 - Arambulas
4"40 PVC tied to wye 29' sof
MH 9+98 (9+68) stopped 6' from
main - 145H, 122H, TWINCO
2003-02394 - 9115103 - 1331 N Estelle
Arambulas - tied to existing PVC
line @ main - 4"40 PVC, 2v45 -
all in alley (32' sof MH)

CONSTRUCTION RECORD							SERVICE RECORD						
STATION	ELEVATION		Depth	MANHOLE	4-INCH "Y" BRANCHES		No. of Permit		House Number		DATE OF PERMITS		
	Ground	Grade			North West	South East	North West	South East	North West	South East	North West	South East	
19	121.11	113.85	7.26	19+90.9(O.H.)									
20	122.24	114.55	7.69										
21	123.20	115.25	7.95										
				21+55									
22	123.85	116.20	7.65										
23	124.85	116.90	7.95	23+20.9(O.H.)									
0+0	123.73	116.12	7.61	0+0	0+33	0+30.5	#572		1202 N. Green		6-21-49		
					+59	+56.5		#2219		1201 N. Estelle		4-26-48	
					+84.1	+81.6		#127		1207 N. Estelle		11-17-47	
1+0	122.70	116.28	6.42		1+09.3	1+06.8	#801		1212 N. Green		9-21-27		
					+34.8	+32.3							
					+60.2	+57.7		#433		1211 N. Estelle		5-26-27	
					+85.1	+82.6		#2958	#3302	1216 N. Green	1217 N. Estelle	4-20-46	2-14-50
2+0	122.25	116.44	5.81		2+11.5	2+09			1222 N. Green	1223 N. Estelle	6-9-27	4-20-46	
					+37.4	+34.9		#488	#2957				
					+63.1	+60.6		#1572	#5940	1228 N. Green	1227 N. Estelle	2-28-86	7-29-74
3+0	122.83	116.60	6.23		+88.8	+86.3	#1268	#32			12-14-38	3-5-36	
3+27.6			6.60	3+27.6	3+13.9	3+11.4							
					+39.4	+36.9	#2009	#2147	1232 N. Green	1223 N. Estelle	10-13-49	4-19-48	
					+65.0	+62.5							
					+90.5	+88		#62		1238 N. Green		4-5-35	
4+0	123.78	116.668	7.12		4+16.1	4+13.6			1240 N. Green	1243 N. Estelle	6-7-72	5-2-90	
					+42.2	+39.7	#872	#1151			10-12-26	8-26-29	
					+66.9	+64.4							
					+93.1	+90.6		#154	1248 N. Green		5-2-49	4-19-71	
5+0	125.23	116.736	8.50		5+18.4	5+15.9		#188	1247 N. Estelle	1253 N. Estelle	3-10-25	9-15-51	
					+44.1	+41.6		#5814					
					+69.5	+67	#893	#1186	1248 N. Green		10-1-70	10-20-26	
6+0	126.93	116.80	10.13		+94.4	+91.9	#1380	#2887	1258 N. Green	1259 N. Estelle		11-20-40	
6+53.5			10.30	6+53.5	6+20.5	6+18		#1181		1255 N. Estelle		11-8-28	
					+82.9	+80.4							
7+0	127.61	116.87	10.74		7+07.9	7+05.4	#1598	#32425	1302 N. Green	1301 N. Estelle	11-24-48	5-22-72	
					+33.3	+30.8	#2190	#23305	1304 N. Green	1307 N. Estelle	11-7-73	4-19-71	
					+59.1	+56.6	#956	#909	1306 N. Green	1307 N. Estelle	7-6-38	11-11-46	
					+83.8	+81.3							
8+0	128.23	116.94	11.29		8+10.1	8+07.6	#2317	#955	1312 N. Green	1311 N. Estelle	3-2-01	7-31-29	
					+34.5	+32							
					+60.3	+57.8	#1738	#349	1316 N. Green	1317 N. Estelle	9-21-44	4-29-26	
9+0	127.72	117.00	10.72		+86.9	+84.4							
9+98.1					9+12.9	9+10.4	#587	#2385	1322 N. Green	1323 N. Estelle	7-9-26	4-1-49	
					+39.2	+36.7	#2366	#846	1326 N. Green	1331 N. Estelle	5-31-40	1-14-03	
					+65.7	+63.2	#2674		1322 N. Green		12-8-24	10-4-26	
					+90.8	+88.3							
10+0	127.45	117.07	10.38	9+98.1	10+16.9	10+14.4	#862	#911	1338 N. Green	1335 N. Estelle	10-9-26	10-24-27	
					+55.2	+52.7		#77		1339 N. Estelle		2-7-27	
					+67.6	+65.1							
					+93.8	+91.3	#451		1340 N. Green		5-31-27		
11+0	125.53	117.14	8.39		11+19.4	11+16.9	#2341	#5833	1348 N. Green	1345 N. Estelle	5-27-40	9-17-51	
					+45.1	+42.6		#213		1353 N. Estelle		3-30-27	
					+71	+68.5							
					+96.4	+93.9	#4927		1358 N. Green		6-11-51		
12+0	125.28	117.21	8.07		12+21	12+18.5							
					+40.2	+37.7							
13+17.6	127.36	117.43	9.93	13+17.6									

Tap - #1449 - 2607 E. 13th - 10-10-29 - C. Frank McCoy
 Tap - #1444 - 2611 E. 13th - 10-10-29 - R. H. Anderson
 5318 - Tap - 1739 N. Estelle - 9-16-57
 See off # C31682 - 1301 N. Estelle - Joe Duller - 4/18/72 (7+23)