



S.S. No. 12 Dist. E - 1911
 Dist 6 - 1912

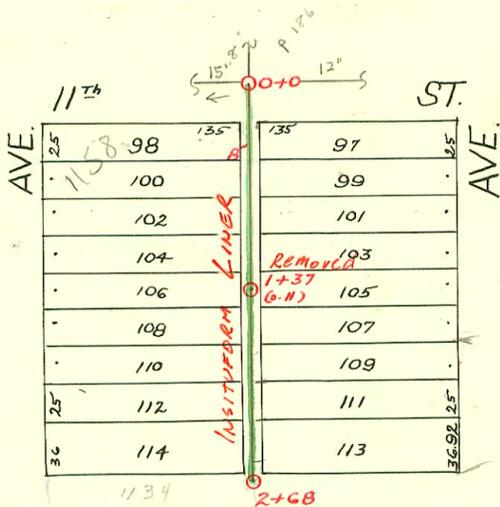


1991 SAN. SEW. RECONSTRUCTION PROGRAM PHASE III
 Built by INSITUFORM PLAINS

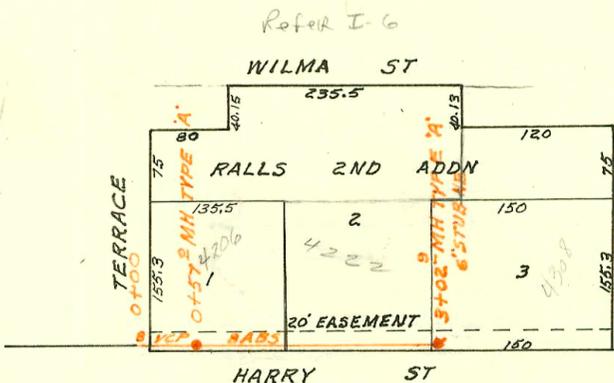

LATERAL 101 DC MAIN 2 SS #12
 BUILT BY: UTILITY CONT. INC.
 PROJ. N# DBKL 576045
 BOOKED 6-3-77 FROM SRL 3

SCALE 1"=150'

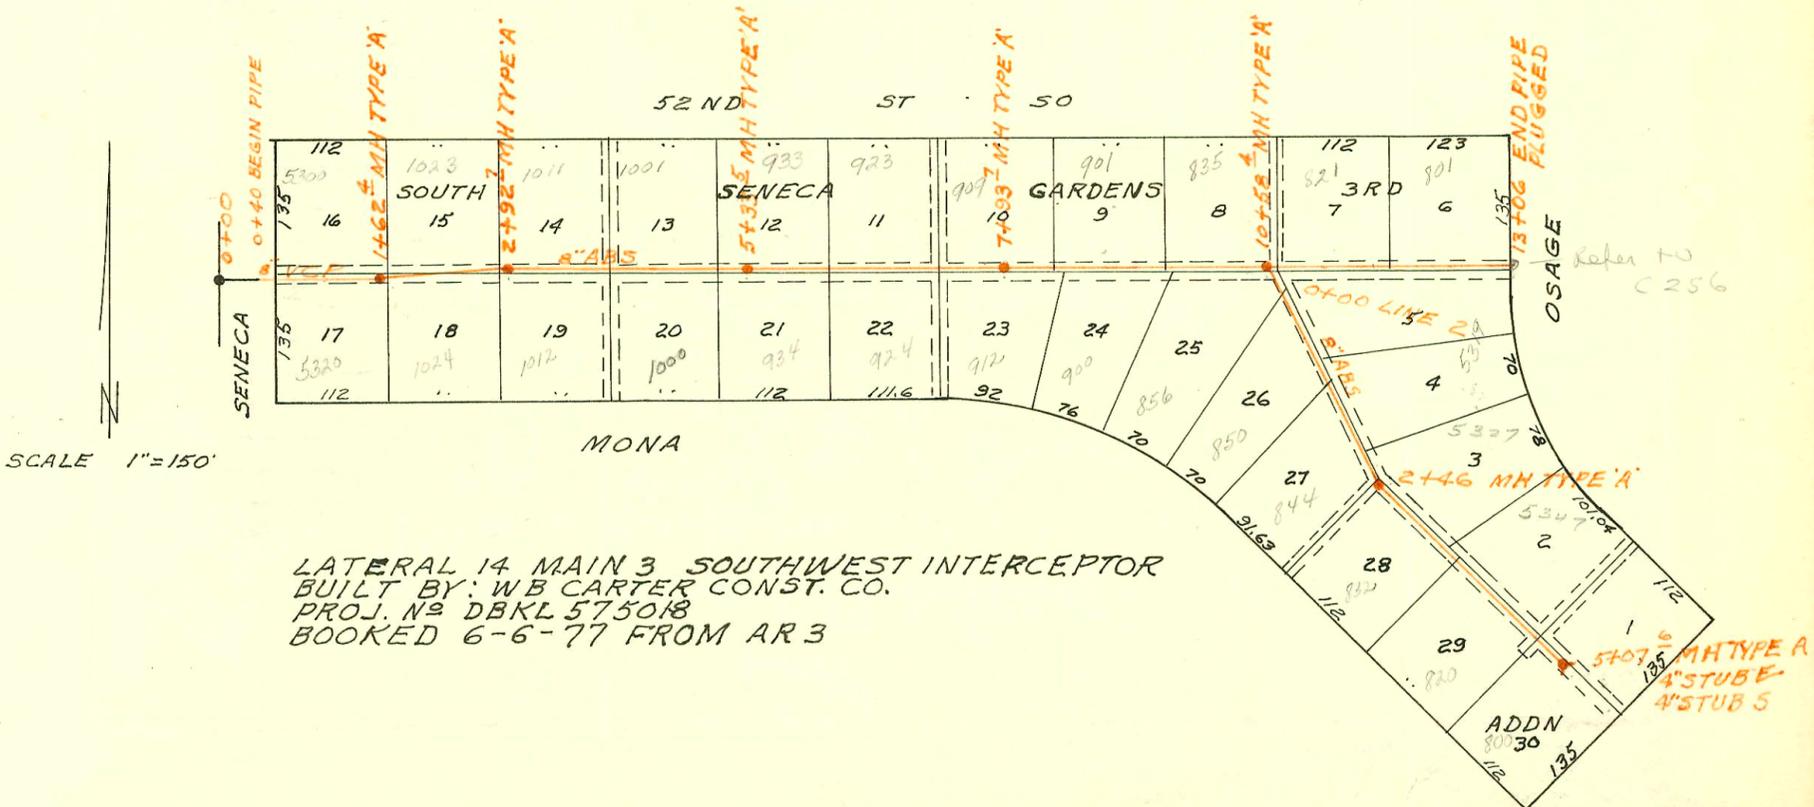

LATERAL 14 MAIN 3 SOUTHWEST INTERCEPTOR
 BUILT BY: WB CARTER CONST. CO.
 PROJ. N# DBKL 575018
 BOOKED 6-6-77 FROM AR 3

SCALE 1"=150'

CONSTRUCTION RECORD

SERVICE RECORD

STATION	ELEVATION		Depth	MANHOLE	4-INCH "Y" BRANCHES		No. of Permit		House Number		DATE OF PERMITS	
	Ground	Grade			North West	South East	North West	South East	North West	South East	North West	South East
0	145.47	128.90	16.57	0+00	0+44	0+41.5	#3067		1158 N Volusia	1157 N Erie	1-16-50	
					+73.5	+71		#2247				9-8-50
1	142.47	129.22	13.25		1+02.5	1+00	#3068		1152 N Volusia	1151 N Erie	1-16-50	
					+28	+25.5		#2248				1-16-50
					+53	+50.5	#3069		1146 N Volusia	1145 N Erie	1-16-50	
					+79	+76.5		#2249				3-16-66 9-6-50
2	137.47	129.57	7.93		2+05	2+02.5	#29658		1140 N Volusia	1113 N Erie	1-16-50	12-23-71
					+30.5	+28	#657	#214			4-21-50	6-4-76
	133.94	129.76	4.18	2+68	+57	+54.5			1134 N Volusia			
LATERAL 101 DRY CREEK MAIN 2 S.S. N#12												
0+00	154.6	144.05			0+13.4							
	155.2	144.22		0+57								
1+00	154.1	144.31										
					4" SCH 40 1+75.4							
2+00	152.4	144.61										
3+00	151.0	144.91										
	151.0	144.92		3+02.9	6" STUB NE		4787		4308 E Harry		11-24-81	
LATERAL 14 MAIN 3 SOUTHWEST INTERCEPTOR												
LINE 1 0+00	82.9	74.50	8.4	EXISTING								
+40	82.5	74.52	8.0									
1+00	81.9	74.70	7.2		1+29.4		C56122		5300 S 5320 S 5300 W		6-29-76	
	81.5	74.82	6.7	1+62.4	1+56.6		10019	C61594			1-13-84	
2+00	81.7	74.90	6.8		2+08.7	2+04.9	C56666	C61594	1003 W 52nd S	1004 Mona Ln	6-23-76	6-13-77
	82.0	75.08	6.9	2+92.7								
		75.08			4" SCH 40 P.V.C 3+77.9 top			42-817(1)		1012 Mona		6-4-92
3+00	82.3	75.10	7.2		3+54.7							
4+00	82.5	75.30	7.2		4" SCH 40 - C 4+17.0		C56197	2002-01352 C56003	1011 W. 52nd S.	1000 Mona Lane	6-30-76	5-14-82 7-9-76
5+00	82.8	75.50	7.3		4+30.9		C56196		1001 W. 52nd S.		6-30-76	
	82.5	75.57	6.9	5+33.5		5+41.9		C56545		734 Mona Lane		7-8-76
6+00	82.8	75.70	7.1		5+41.1			C62128	933 W. 52nd St		9-22-77	
7+00	82.4	75.90	6.5		6+98.3	6+81.0	C56629	C56609	923 W. 52nd St	924 Mona Lane	7-20-76	7-9-76
	82.2	76.09	6.1	7+93.7	8+00.5	7+62.9		C56696	909 W. 52nd St	912 Mona Lane	7-23-76	7-20-76
8+00	82.2	76.10	6.1		8+94.4			C56539	901 W. 52nd St	900 Mona Lane	7-9-76	
						9+01.6		C56622				2-8-77
9+00	82.5	76.30	6.2		9+97.4			C56092		856 Mona Lane		6-27-76
10+00	82.3	76.50	5.8		10+30.2			C57652	825 W. 52nd St		10-4-76	
	82.2	76.62	5.6	10+58.4								
11+00	82.3	76.70	5.6		11+26.0			C2699	821 W. 52nd S	5319 S. (D) Orange	2-24-81	12-4-90
12+00	82.5	76.90	5.6		12+68.0			2343	801 W. 52nd S		1-12-81	
13+06	82.0	77.11	4.9									
LINE 2 0+00	82.2	76.72	5.5	0+00 = 10+58.4 LINE 1								
1+00	82.5	76.92	5.6		1+25.0	1+62		C6262	850 W. 52nd St	5319 S. Orange	5-12-86	8-25-87
2+00	82.0	77.12	4.9			2+06.2		C67165	844 W. Mona		6-30-78	
	82.2	77.31	4.9	2+46.0		3+31.4		C67069	822 W. Mona		6-26-78	
3+00	82.3	77.42	4.9									
4+00	82.2	77.62	4.6		4+27.6			C5789	820 W. Mona Ln		5-5-82	
					4+44.2			C74494	5347 So. Orange		9-24-79	
	82.1	77.84	4.3	5+07.6	4" STUB E	4" STUB S	#4223		5353 S. Orange		9-30-81	

B5294-1145 71 Erie - 3-21-66 Trade-off Orange Top (1+76.5)
 2000-00963 4222 E Harry - Single Terry Alb - installed 1000 gallon grease trap (Preco) 5/15/00 4" SCH 40 2+00
 61600 Address changed to 4220 E Harry per Cust Request w/ city