


S.S. No. 12 Dist. E - 1911
Dist G - 1912

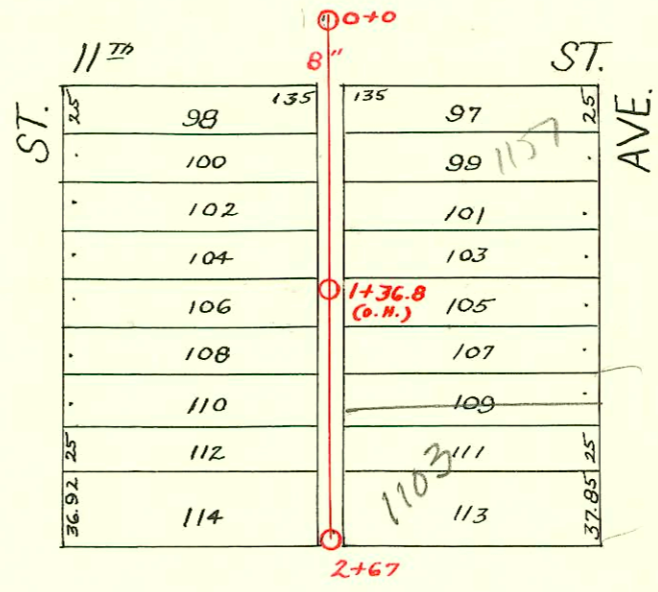

ERIE

CHAUTAUQUA

CONSTRUCTION RECORD							SERVICE RECORD					
STATION	ELEVATION		Depth	MANHOLE	4-INCH "Y" BRANCHES		No. of Permit		House Number		DATE OF PERMITS	
	Ground	Grade			North West	South East	North West	South East	North West	South East	North West	South East
0	138.47	131.10	7.37	0 + 00	0 + 47 + 73 + 96.5	0 + 44.5 + 70.5 + 94		#1950		1157 N. Chautauqua		2-15-49
1	136.80	131.60	5.20		1 + 22 146.0 top + 48 + 74	1 + 19.5 + 45.5 + 71.5 + 97.5	#4030	#1951	2901 E. 11th	1157 N. (P) Chautauqua	3-6-51	2-15-49
2	137.25	132.10	5.15		2 + 00 + 26		#2127		1140 N. Erie		9-28-54	
	137.58	132.44	5.14	2 + 67	+ 51.5	2 + 23.5 + 49	#432 #5459		1132 N. Erie	1103 N. Chautauqua	7-6-55	4-25-29

#2127-Top 1140 N. Erie - 9-28-54 - Joe McDonald