


S.S. No. 12  $\left\{ \begin{array}{l} \text{Dist E - 1911} \\ \text{Dist G - 1912} \end{array} \right.$

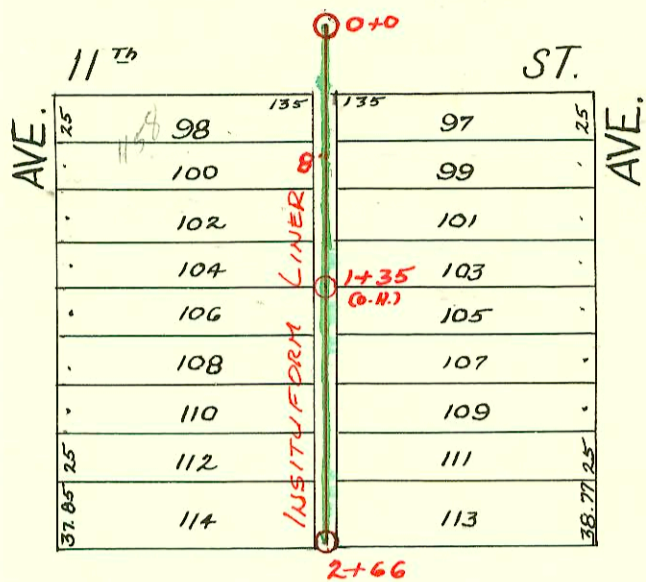

1990 SAN. SEWER RECONST., PH 3 III  
 PROJ. NO. 468-82080 (630442)  
 Built By Insituform Plains, Inc.

CHAUTAQUA

LORRAINE

CONSTRUCTION RECORD							SERVICE RECORD					
STATION	ELEVATION		Depth	MANHOLE	4-INCH "Y" BRANCHES		No. of Permit		House Number		DATE OF PERMITS	
	Ground	Grade			North West	South East	North West	South East	North West	South East	North West	South East
0	141.56	133.90	7.66	0+00	0+42 +68 +94.5	0+39.5 +65.5 +92	#2456 #77122		1154 N. Chautaugus 1138 N. Chautaugus		8-1-68 7-31-42 4-3-80	
1	142.96	135.30	7.66		1+23 +49 +72.5 +97.5	1+20.5 +46.5 +70 +95	#262 #1636 #329 #45513 #3176		1170 N. Chautaugus 1104 N. Chautaugus		10-20-69 6-23-16 4-3-28 7-1-74 3-13-41	
2	142.26 143.76	136.70 137.62	5.56 6.14	2+66	2+24 +49	2+21.5 +46.5						