


S.S. No. 12, Dist. G-1912
Dist. E-1911

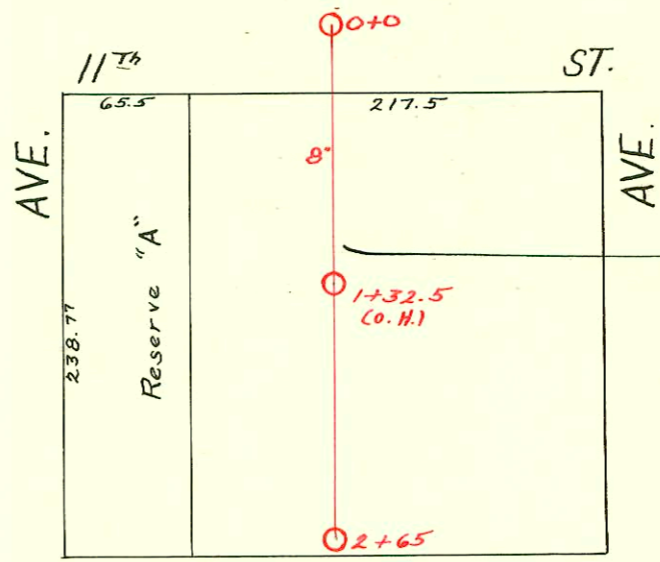

Line destroyed - Cut off at M.H. in 11th in Cemetery, by order F.L.B.

LORRAINE

HILLSIDE

CONSTRUCTION RECORD						SERVICE RECORD						
STATION	ELEVATION		Depth	MANHOLE	4-INCH "Y" BRANCHES		No. of Permit		House Number		DATE OF PERMITS	
	Ground	Grade			North West	South East	North West	South East	North West	South East	North West	South East
0	149.96	140.45	9.57	0+00	0+43.5	0+41						
					+69.5	+67						
					+95	+92.5						
1	150.16	141.45	8.71		1+20.5	1+18						
					+46.5	+44						
					+72	+69.5						
					+98	+95.5						
2	150.46	142.45	8.01		2+23.5	2+21						
	149.96	143.10	6.86	2+65	+49	+46.5						