


DIST. P- S.S. #12  
1922

IN BENEFIT DISTRICT

S.S. #12 DIST. E - 1911  
DIST. P - 1922

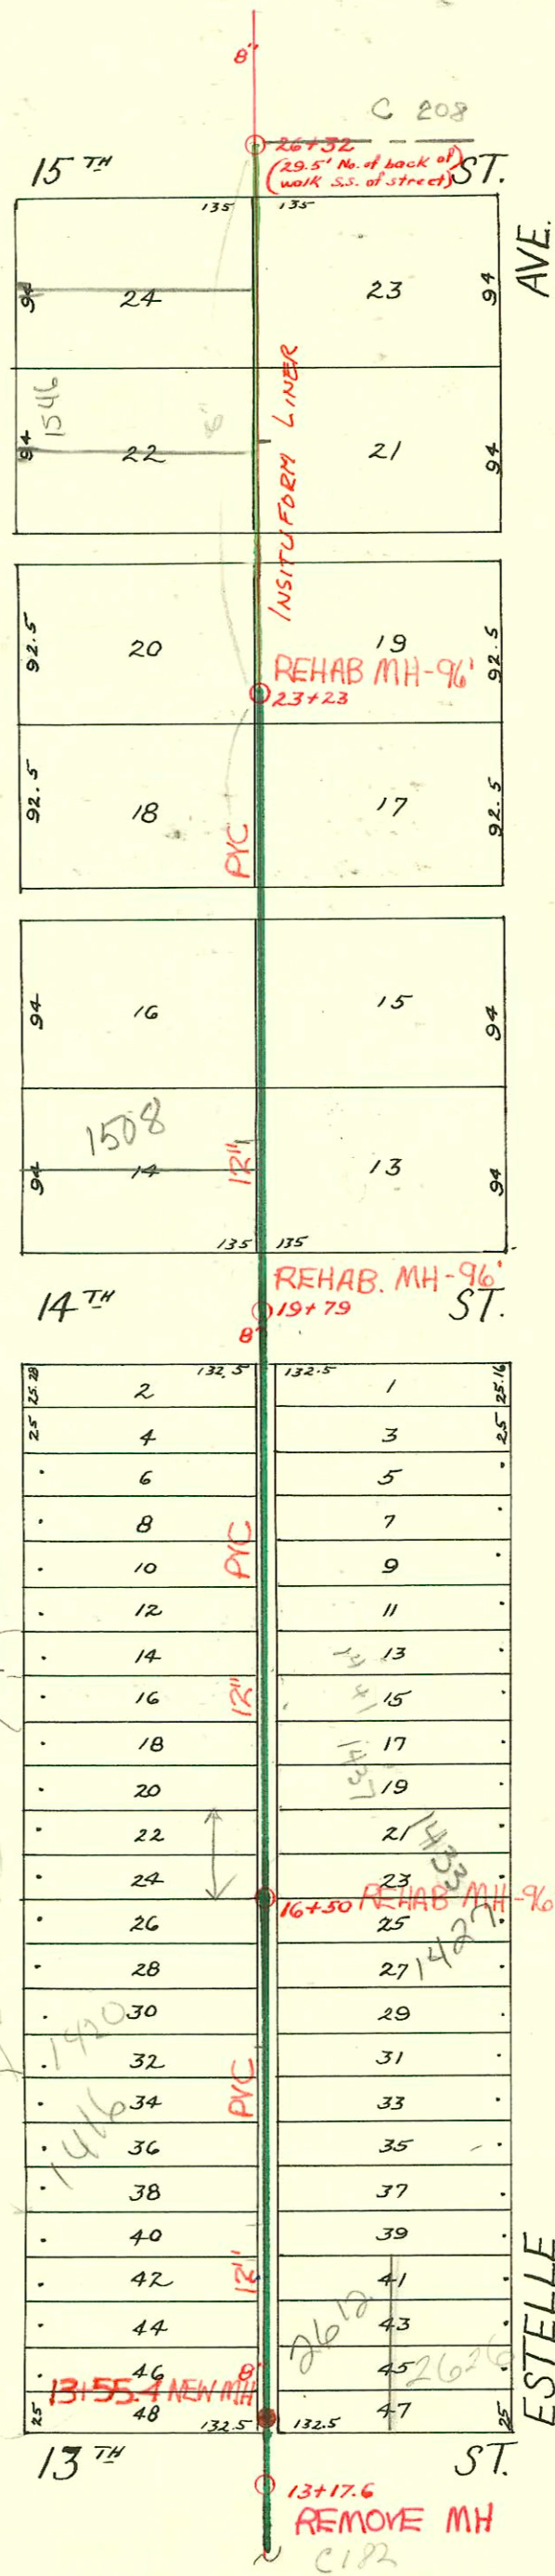

1995 SANITARY SEWER REHABILITATION PROGRAM - PHASE IV  
 PROJ. NO. N/A (621128)  
 BUILT BY W. B. CARTER CONST. CO.  
 BOOKED 7-29-96 FROM AS BUILTS

1990 SAN. SEWER RECONST., PHASE III  
 PROJ. NO. 468-82080 (630442)  
 Built By Insituform Plains, Inc.

RECONNECTIONS

STA.	ADDRESS	DIRECTION
13+89.5	2612 E. 13TH	Right
14+37	2226 E. 13TH	Right
14+74.5	1405 N. Estelle	Right
15+15.5	1407 N. Estelle	Right
15+41	1416 N. Green	Left
15+69	1421 N. Estelle	Right
15+67	1420 N. Green	Left
16+59	1430 N. Green	Left
16+65.5	1433 N. Estelle	Right
17+30	1436 N. Green	Right
17+71.5	1442 N. Green	Left
17+73	1441 N. Estelle	Right
18+17	1445 N. Estelle	Right
18+21	1450 N. Green	Left
18+70	1455 N. Estelle	Right
18+72	1452 N. Green	Left
19+18	1457 N. Estelle	Right
19+20	1458 N. Green	Right
20+57	1505 N. Estelle	Right
20+73	1514 N. Green <sup>1887</sup>	Left
21+22	1515 N. Estelle	Right
21+25	1512 N. Green	Left
21+71	1518 N. Green	Left
22+21	1522 N. Green	Left
22+19	1523 N. Estelle	Right

CONSTRUCTION RECORD

SERVICE RECORD

STATION	ELEVATION		Depth	MANHOLE	4-INCH "Y" BRANCHES		No. of Permit		House Number		DATE OF PERMITS	
	Ground	Grade			North West	South East	North West	South East	North West	South East	North West	South East
	127.36	117.43	9.93	13+17.6	13+62.5 +87.5	13+60 +85						
14	124.97	117.73	7.24		14+12.5 +37.7 14+63.5 +88.7	14+10 +35.2 +61 +86.2	#883	#356 #14	2610 E. 13th	2626 E. 13th 1405 N. Estelle	7-17-29	4-14-30 1-6-27
15	125.34	118.06	7.28		15+13.5 4" SCH 40 +39.5 +64.5 +89.5	15+11.5 4" SCH 40 +37 +62 +87	#378 #339 #603	#17315 #173	1416 N.R. Green 1420 N. Green	1407 N. Estelle See Below 1421 N. Estelle	4-16-28	3-26-91 4-5-28
16	126.03	118.39	7.64 8.00	16+50	16+16.1 +41.2 +67.1 +92.5	16+13.6 +38.7 +64.6 +90	#5194 #36 #1969	#25370 #7	1424 N. Green 1427 N. Estelle	1427 N. Estelle	10-9-67 3-4-32	5-21-90 7-5-28 4-5-48
17	126.50	118.72	7.78		17+17.8 +43.2 +68.5 +93.8	17+15.3 +40.7 +66 +91.3	#1062 #1105	#71 #58906 #698 #5640 #890	1436 N. Green 1442 N. Green	1433 N. Estelle 1437 N. Estelle 1445 N. N. Estelle	8-30-38 8-19-29	1-26-28 12-1-76 6-29-28 8-21-28
18	125.88	119.05	6.83		18+19.1 +44.2 +69.5 +95.3	18+16.6 +41.7 +67 +92.8	#905 #156	#1074	1450 N. Green 1452 N. Green	1455 N. Estelle	7-22-29 5-2-49	10-4-28
19	126.19	119.38	7.81		19+20.7 +44.9	19+18.2 +42.4	#1741	#1742	1458 N. Green	1457 N. Estelle	9-20-49	9-20-49
19+79	127.01		7.50	19+79	+44.9 +43.8	+42.4 +56.3	#18190		1502 N. Green	See Below	4-23-87 1-24-47	When measured 1-24-47
20+49.3	127.42	119.71	7.71		20+21 4" SCH 40 PVC 20+72.2 +97.5	20+18.5 +69.7 +95	#1311 #1310	Connected #15155	1508 N. Green	See Below	1-24-47	
21+27.5	127.83	120.12	7.71		21+23.5 +57.5 +82.5	21+21 +55 +80	#1309	#1278	1512 N. Green	1515 N. Estelle	1-24-47	8-18-49
22+0	128.89	120.37	8.52		22+08.1 +33.2 +59.5 +84.1	22+05.6 +30.7 +57 +81.6	#1307 #1306	#1410 #1409	1522 N. Green 1528 N. Green	1523 N. Estelle 1527 N. Estelle	1-24-47 1-24-47	2-6-47 2-6-47
23	129.61	120.70	8.91 9.30	23+23	23+10 +35.5 +61.1 +86.1	23+07.5 +33 +58.6 +83.6	#4307 #720	#1312	1536 N. Green	1537 N. Estelle	6-21-73 1-24-47	9-26-46
24	130.45	121.03	9.42		24+12.2 +37.2 4" SCH 40 PVC 24+62.5 +85.5	24+09.7 +34.7 24+60 +83	#1313 #1314	#1313 #1937	1542 N. Green 1546 N. Green	1547 N. Estelle	6-21-73 1-24-47 2-9-00 1-24-47	11-30-92 4-2-48
25	130.45	121.36	9.09		25+11 +33.5	25+08.5 +51.2	#1315		1552 N. Green		1-24-47	
26	131.10	121.69	9.41 9.60	26+32	+58.2 +84.5	+82	#1316		1556 N. Green		3-6-81 1-24-47	
26+43.6	131.30	121.83	9.47									

Rep-2000-00385-2/19/00-1546 N Green - Padgett Exc- 4" SCH 40 - Predco 139'S of MH 26132 - TWINCO-2000-1045  
 2003-01155-4/30/03-1508 N Green - Glover Ent - MH Buried PVC Saddle 10' N of utility pole (edget mismt after  
 MH located) Replaced remainder of claytile to main from previous repair

1999-00107-7/1/99-1626 N Green - AE Henning- 4" SCH 40 - High Kick out - Predco 158' N of MH 13755.4(15+13.4) - TWINCO - per Inspector  
 Peterman 7/6/99- Needs seal off permit  
 C 23587 - 2608 E 13th Seal off - at Henning 4-5-71 (14+42)

#1308 - Tap - 1518 N. Green - 1-24-47 - Simmons Pibg. Co.  
 #2396 - Tap - 1430 N. Green - 4-4-49 - R. La Foy  
 #20355 - Tap at 25+45 - 1557 N. Estelle - 12-9-53 - (Conn. made by Sewer Dept.)  
 92-45685-7 12/24/92 - 1505 N Estelle - Campbell - 4" PVC 40 - 1/2" Fall  
 D.L. Replaced line under room addition - tied back into existing line in center  
 of back yard