


Dist. P-1922
 Dist. G-1912
 Dist. E-1911

RECONNECTIONS

STA.	ADDRESS	DIRECTION
0+49	1558 N. Volutsia	Right
0+52.5	1557 N. Erie	Left
0+85	1551 N. Erie	Left
0+99	1552 N. Volutsia	Right
1+33	1548 N. Volutsia	Right
1+62	1547 N. Erie	Left
1+87	1541 N. Erie	Left
2+09	1542 N. Volutsia	Right
2+37	1538 N. Volutsia	Right
2+63	1537 N. Erie	Left
3+61	1528 N. Volutsia	Right
3+86.5	1522 N. Volutsia	Right
4+13	1521 N. Erie	Left
4+39	1517 N. Erie	Left
4+61	1518 N. Volutsia	Right
4+86	1512 N. Volutsia	Right
5+14	1511 N. Erie	Left
5+41	1507 N. Erie	Left
5+64	1502 N. Volutsia ^{R see below}	Right
5+96	1501 N. Erie	Left
6+92	1458 N. Volutsia	Right
6+93	1457 N. Erie	Left
7+68 ^{see below}	1454 N. Volutsia ^{w/4'-4" R Riser Pipe}	Right
7+70	1453 N. Erie ^{w/4'-4" R Riser Pipe}	Left
7+96	1448 N. Volutsia ^{w/4.5'-4" Riser Pipe}	Right
8+69	1443 N. Erie ^{w/5'-4" Riser Pipe}	Left
8+72	1442 N. Volutsia ^{w/5.5'-4" R Riser Pipe} ^{see below}	Right
11+58	1411 N. Erie	Right
12+00	1412 N. Volutsia Apt.	Left
12+52	2806 & 2808 E. 13TH	Left
12+28	2830 E. 13TH	Right

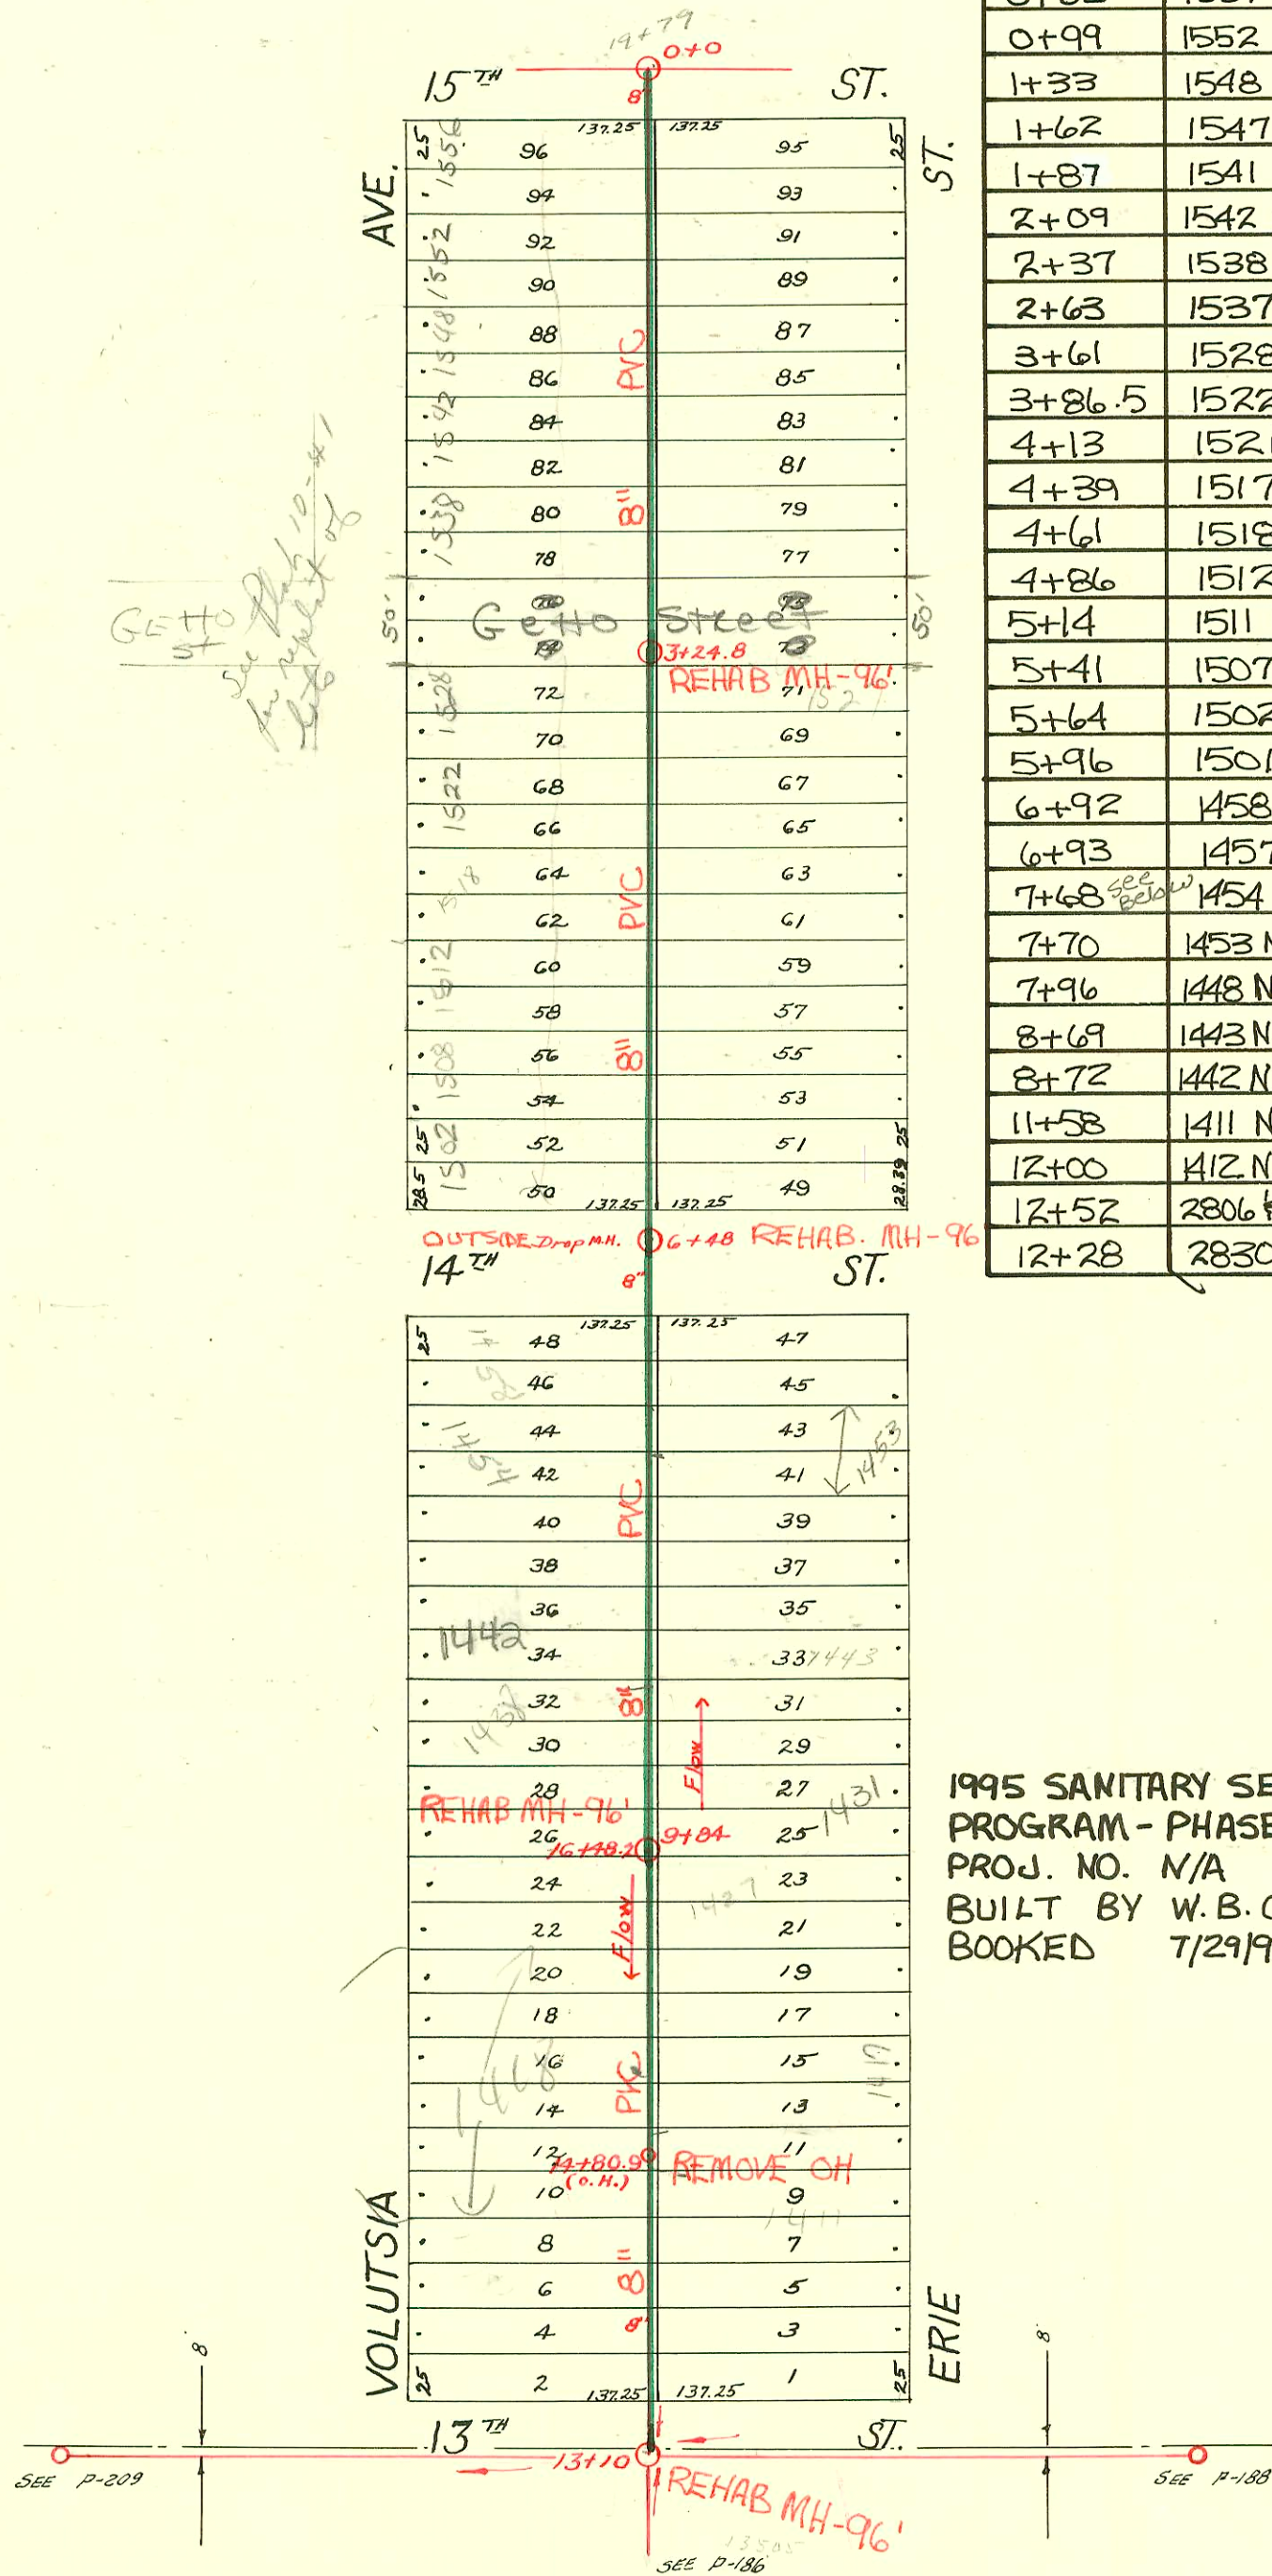

1995 SANITARY SEWER REHABILITATION
 PROGRAM - PHASE IV
 PROJ. NO. N/A (621128)
 BUILT BY W.B. CARTER CONST. CO.
 BOOKED 7/29/96 FROM AS BUILTS

- 2003-01805-7/10/03-1442 Volutsia - Jones Swr - Partial repair-aprx 15' from house(east iron) to twin CO to sch 40 PVC
- 2003-02074-8/6/03-1502 Volutsia - Arambulas- 1422, 4" sch 40 PVC, 1 twin CO, replace from EPL 38' 1 fern CO
- 2003-02449-9/22/03-1454 Volutsia- Wichita Exc- 120' S of MH 6+48(7+68) tied to exist stub from Main- 4" sch 40 PVC- 2H45, 1 twin CO
- 2006-00916-4/10/06-1418 Volutsia. Repair tied to SDR stub, 1-wye, 1-45V, 1-22V, 1-22H (McCallum)

6366- 1425 n. Erie-8-17-82 Jim Morris (132^{top} 2' S. of 16+497) Church Addr