


S.S. No. 12 - Dist. E  
1911

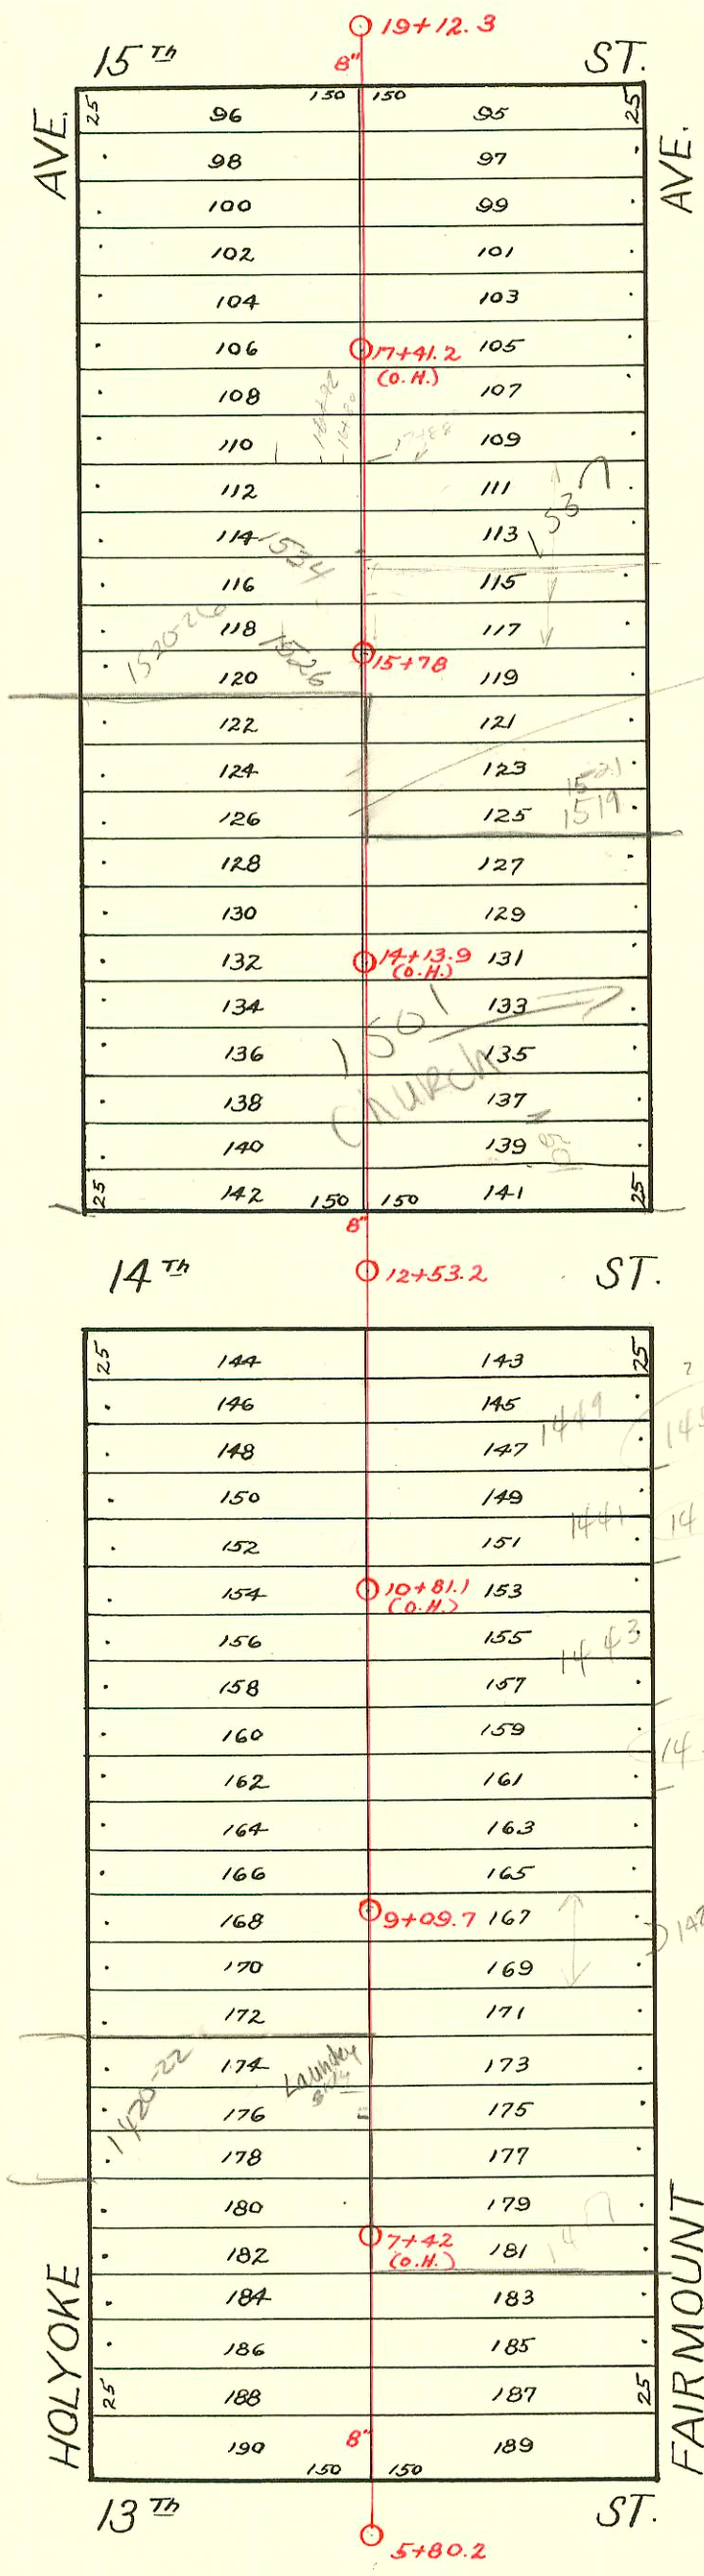

lined in 1998 - see GBA

SW2000-00012-14106-1420 N Holyoke Laundry Bldg - Hope Inc } 239 N g m H - (8+19.2) (1) twin clo, Ardeo, (1) 22 H, 4" sch 40 PVC - McCullough

| CONSTRUCTION RECORD |           |        |       |         |                     | SERVICE RECORD |               |            |                        |                  |                 |            |
|---------------------|-----------|--------|-------|---------|---------------------|----------------|---------------|------------|------------------------|------------------|-----------------|------------|
| STATION             | ELEVATION |        | Depth | MANHOLE | 4-INCH "Y" BRANCHES |                | No. of Permit |            | House Number           |                  | DATE OF PERMITS |            |
|                     | Ground    | Grade  |       |         | North West          | South East     | North West    | South East | North West             | South East       | North West      | South East |
| 5                   | 183.50    | 174.04 | 9.46  | 5+80.2  |                     |                |               |            |                        |                  |                 |            |
| 6                   | 183.30    | 174.36 | 8.94  |         | 6+24.3              | 6+21.8         |               |            | 3302-04-06             | 3316 E.          |                 |            |
|                     |           |        |       |         | +49.4               | +46.9          | #881          | #1588      | 08 E. 13 <sup>th</sup> | 13 <sup>th</sup> | 5-18-42         | 4-23-42    |
|                     |           |        |       |         | +74.4               | +71.9          | #1882         | #1587      | 1402-04-06             | 1405             | 5-18-42         | 4-23-42    |
|                     |           |        |       |         | +99.5               | +97            |               |            | 08 N. Holyoke          | Fairmount        |                 |            |
| 7                   | 186.56    | 175.96 | 10.60 |         | 7+25                | 7+22.5         |               |            |                        |                  |                 |            |
|                     |           |        |       |         | +50.5               | +47.9          |               | #1366      |                        | 1419             |                 | 9-25-29    |
|                     |           |        |       |         | +75.7               | +73.2          | #1883         | #513       | 1418-12-4              | 1417             | 5-18-42         | 11-25-36   |
| 8                   | 188.03    | 177.56 | 10.47 |         | 8+05                | 8+00           | #1933         |            | 16 N. Holyoke          | Fairmount        |                 |            |
|                     |           |        |       |         | +31                 | +28.5          |               | #2340      | 1420-22                | 1421             | 10-7-49         |            |
|                     |           |        |       |         | +54.5               | +52            |               |            | 1425 N. Holyoke        | Fairmount        | 1-4-00          | 5-27-40    |
|                     |           |        |       |         | +79.5               | +77            | #3271         |            | 1426 N. Holyoke        |                  | 12-2-50         |            |
| 9                   | 190.12    | 179.16 | 10.96 | 9+09.7  | 9+03.5              | 9+01           |               |            |                        |                  |                 |            |
|                     |           |        |       |         | +26.5               | +24            | #239          |            |                        |                  | 2-19-24         |            |
|                     |           |        |       |         | +51.5               | +49            | #772          | #391       | 1430 N. Holyoke        | 1435             | 6-27-29         | 4-19-30    |
|                     |           |        |       |         | +76.5               | +74            |               |            |                        |                  |                 |            |
|                     |           |        |       |         | +98.5               |                |               |            |                        |                  |                 |            |
| 10                  | 190.71    | 180.76 | 9.95  |         | 10+01               |                |               |            |                        |                  |                 |            |
|                     |           |        |       |         | +24.2               | 10+21.7        |               | #817       |                        | 1443             |                 | 5-29-23    |
|                     |           |        |       |         | +49.3               | +46.8          |               |            |                        |                  |                 |            |
|                     |           |        |       |         | +74.3               | +71.8          |               |            |                        |                  |                 |            |
|                     |           |        |       |         | +97.1               | +94.6          | #283          | #731       | 1448 N. Holyoke        | 1441 (1449)      | 3-4-74          | 8-23-11    |
| 11                  | 192.03    | 182.36 | 9.67  |         | 11+23.3             | 11+20.8        | #684          | C18326     |                        | 1449             | 5-7-23          | 3-10-70    |
|                     |           |        |       |         | +48.5               | +46            | #124          |            |                        |                  | 1-24-23         |            |
|                     |           |        |       |         | +74                 | +71.5          | #125          | #360       |                        | 1457             | 1-24-23         | 4-11-28    |
|                     |           |        |       |         |                     |                |               |            |                        | Fairmount        |                 |            |
| 12                  | 193.86    | 183.96 | 9.90  |         | 12+07               | 12+04.5        |               |            |                        |                  |                 |            |
|                     | 194.55    | 184.79 | 9.76  | 12+53.2 | +94.7               | +92.2          |               |            |                        |                  |                 |            |
| 13                  | 195.84    | 185.03 | 10.81 |         | 13+20               | 13+17.5        |               | #817       |                        |                  |                 | 10-7-11    |
|                     |           |        |       |         | +45.3               | +47.8          |               |            |                        |                  |                 |            |
|                     |           |        |       |         | +70                 | +67.5          |               |            |                        |                  |                 |            |
|                     |           |        |       |         | +95                 | +92.5          |               |            |                        |                  |                 |            |
| 14                  | 196.12    | 185.53 | 10.59 |         | 14+22.5             | 14+20          |               | #382       |                        |                  |                 | 9-18-16    |
|                     |           |        |       |         | +45.1               | +42.6          |               |            |                        |                  |                 |            |
|                     |           |        |       |         |                     | +62.5          |               |            |                        |                  |                 |            |
|                     |           |        |       |         | +87.2               | +84.7          |               |            |                        |                  |                 |            |
| 15                  | 196.45    | 186.03 | 10.42 |         | 15+12.3             | 15+09.8        |               | #641       |                        | 7                |                 | 4-30-23    |
|                     |           |        |       |         | +36.9               | 15+34.4        |               |            |                        |                  |                 |            |
|                     |           |        |       | 15+78   | 15+62.3             | 15+59.8        | #592          | #173       | 1526 N. Holyoke        | 1525             | 12-18-12        | 12-19-32   |
|                     |           |        |       |         | +89.5               | +87            |               |            |                        |                  |                 |            |
| 16                  | 196.30    | 186.53 | 9.77  |         | 16+14.5             | 16+12          |               | #6237      |                        | 1534 S/O         |                 | 9-26-70    |
|                     |           |        |       |         | 16+32               | +29.5          | #490          | #839       | 1532 N. Holyoke        |                  | 10-4-15         | 10-16-11   |
|                     |           |        |       |         | +61.9               | +64.4          | #799          |            | 1538 N. Holyoke        |                  | 9-30-11         |            |
|                     |           |        |       |         | +90                 | +87.5          |               |            |                        |                  |                 |            |
| 17                  | 194.34    | 187.03 | 7.31  |         | 17+12               | 17+09.5        |               | #263       |                        |                  |                 | 5-1-14     |
|                     |           |        |       |         | +37.7               | +35.2          |               | #1992      | #831                   | 1528 N. Holyoke  | 4-7-48          | 10-12-11   |
|                     |           |        |       |         | +62.9               | +60.4          |               | #830       |                        |                  |                 | 10-12-11   |
|                     |           |        |       |         | +87.2               | +84.7          |               |            |                        |                  |                 |            |
| 18                  | 192.64    | 187.53 | 5.11  |         | 18+11.8             | 18+09.3        |               |            |                        |                  |                 |            |
|                     |           |        |       |         | +40.2               | +37.7          |               |            |                        |                  |                 |            |
|                     |           |        |       |         | +67.8               | +65.3          | #1991         |            | 1556 N. Holyoke        |                  | 4-7-48          |            |
| 19                  | 192.16    | 188.03 | 4.13  |         |                     |                |               |            |                        |                  |                 |            |
|                     | 192.86    | 188.08 | 4.78  | 19+12.3 |                     |                |               |            |                        |                  |                 |            |

see next pg

See off at pt 154' 30" of m. H 127 53.2' 2' 24" S. of base main.

Tap #18216 - 1501 Fairmount - Robt. McElroy - 3-3-70 (13+39.6)  
 #299 - Tap - 1501 Fairmount - W.W. Pray - 7-30-36  
 #1111 - Tap - 1429 Fairmount - R. LaFoy - 11-14-47  
 #1630 - Private line - 1429 1/2 Fairmount - Simmons Mfg - 2-20-48  
 11623 Tap 1519-01 m. Fairmount Jet 11-6-59 15+19