


S.S. No. 12 - Dist. E
1911

RECONNECTIONS

STA.	ADDRESS	DIRECTION
29+37.6	1732 N. Fairmount	West
28+94.2	1728 N. Fairmount	West
28+36.9	1712 N. Vassar	East
28+22.3	1722 N. Fairmount	West
27+73.8	1714 & 1716 N. Fairmount	West
26+65.6	1702 N. Fairmount	West

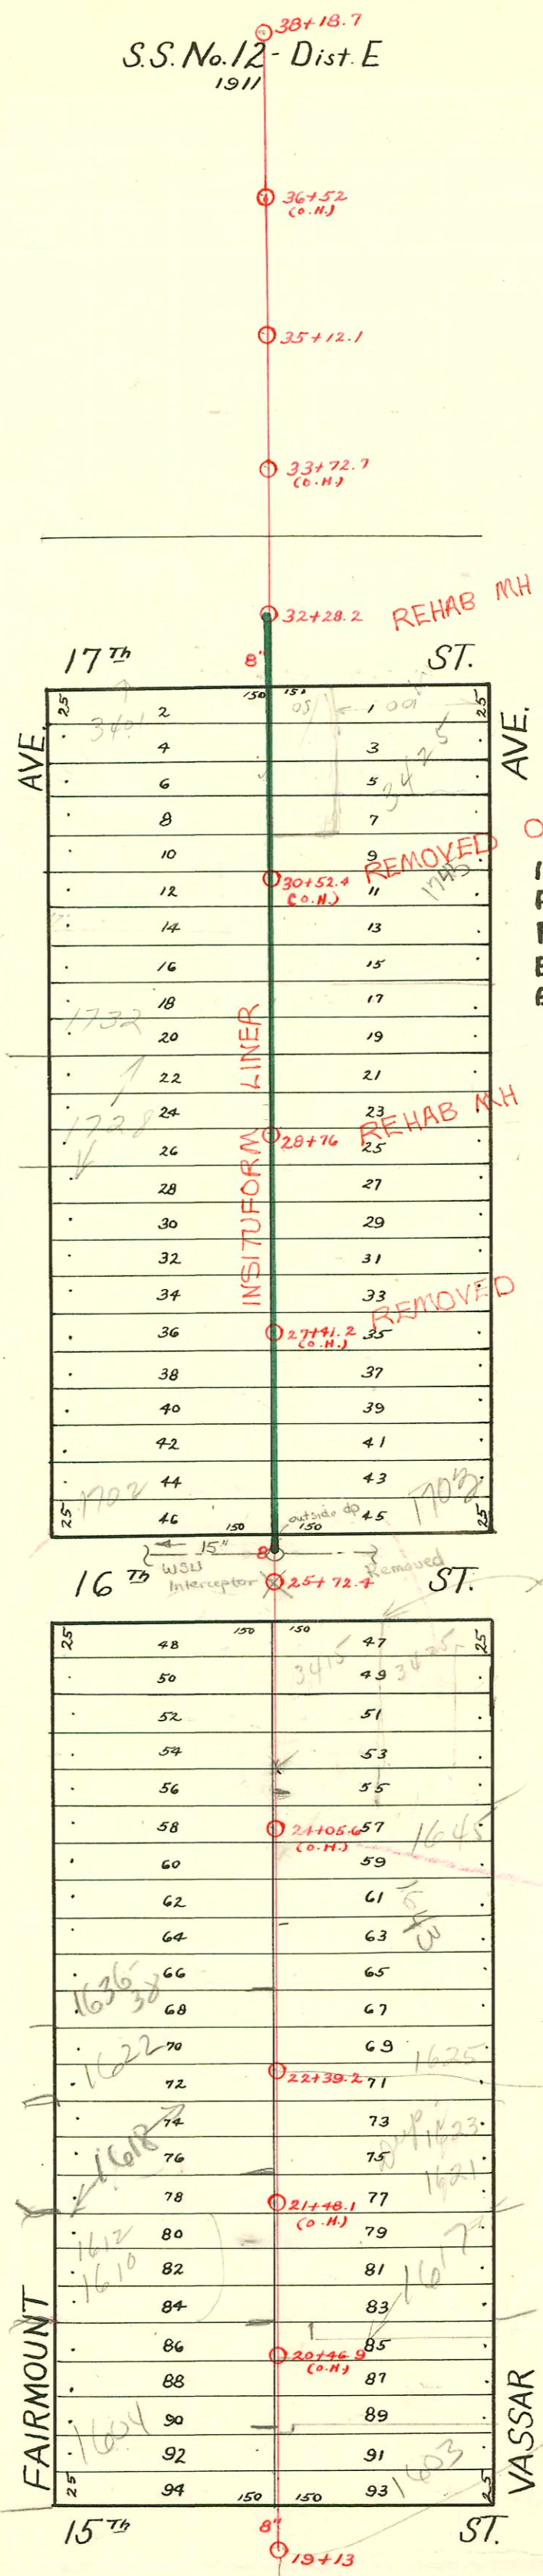

1994 SANITARY SEWER REHABILITATION PROGRAM - PHASE I
 PROJ. NO. 468-82399 (623124)
 BUILT BY INSITUFORM PLAINS, INC.
 BOOKED 2-17-95 FROM AS BUILTS

→ 95' S of 2nd M.H. No. of 15th

CONSTRUCTION RECORD

SERVICE RECORD

STATION	ELEVATION		Depth	MANHOLE	4-INCH "Y" BRANCHES		No. of Permit		House Number		DATE OF PERMITS		
	Ground	Grade			North West	South East	North West	South East	North West	South East	North West	South East	
19	196.44	190.11	6.33	19+13	19+43.5	19+41							
					+68.9	+66.4	#238					4-1-21	
					+89.2	+86.7	#768	1604 Fairmount				9-13-11	
20	196.62	190.53	6.09	20+16.5	20+14								
					+42.7	+40.2	#239					4-1-21	
					+67.8	+65.3	#650	1607 Vassar				6-7-17	
21	197.07	191.03	6.04	21+18.5	21+16							3-14-16	
					+44	+41.5	#650	1610-102 N. Fairmount				7-21-71	
					+69.2	+66.7	#11684					9-28-94	
					+94.7	+92.2		1618 Fairmount				10-28-59	
22	196.11	191.53	4.58	22+39.2	22+17.5								
					+47.5	+45	1977 #712	1622 Fairmount	1625 N. Vassar			12-2-80	8-24-27
					+70	+67.5	#2003						
					+227.95.5	+93	#2138	10416 Fairmount	1624-36 Vassar			8-12-52	3-7-81
23	197.33	192.03	5.30	23+20.9	23+18.4								
					+46.1	+43.6	#3099	1650 Fairmount				11-1-52	
					+71	+68.5	#344						
					+96.5	27+94	#677						7-18-12
24	200.57	192.53	8.04	24+47.7	24+45.2								
					+75.7	+73.2	#677						8-2-11
							(615783)						(9-8-69)
25	203.36	193.03	10.33	25+72.4	25+00.2								
					+28.5	+26							
26	204.16	193.53	10.63	26+11.5	26+09								
					+37.3	+34.8	#478						11-10-16
					+62.2	+59.7							
					+87	+84.5	9477						10-19-83
27	203.79	194.03	9.76	27+11.8	27+09.3								
					+37	+34.2	#65064						
					+59.4	+47.2	#277						2-15-78
					+61.9	+59.4	#898	1714 Fairmount					6-12-12
					+87	+84.5	#234						1-24-78
28	202.83	194.53	8.30	28+12.2	28+09.7								
					+34.8	+32.3	#1127						3-31-21
					+60	+57.5	#228						3-10-78
							#374	1725 N. Vassar					8-22-29
							#1214	1725 N. Vassar					3-22-29
29	203.02	195.13	7.99	29+10.7	29+08.2								
					+35.1	+32.6	#659	1728 Fairmount					2-27-73
					+60.1	+57.6		1622 Fairmount					5-26-24
					+85.1	+82.6							
30	203.27	195.53	7.74	30+10.1	30+07.6								
					+19.2	+19.2	#138						12-12-73
					+35.5	+33	#2532	1741 N. Vassar					3-23-31
					+57.8	+65.5	#707	1741 N. Vassar					1-22-74
					+91.2	+88.7	#1024						12-20-45
31	203.32	196.03	7.29	31+16.7	31+14.2								
					+42.1	+39.6	#435	1754 Fairmount					2-27-73
					+67.5	+65	#324						8-14-11
32	203.44	196.53	6.91	32+28.2									
33	204.99	197.03	7.96	33+31	33+28.5								
34	205.74	197.53	8.21	34+31.3	34+28.8								
35	206.73	198.03	8.70	35+12.1	35+32								
36	207.09	198.53	8.49	36+29	36+26.5								
37	209.42	199.03	9.57	37+42									
					+76		#661						7-26-11
					+78.5	+88	#659						7-26-11
							#660						7-26-11
38	209.03	199.53	9.50	38+06.5									
					+11.5		#658	1901 N. Vassar					7-26-11
							#678						6-25-28

2003-00060 17103 1636 N Fairmount - Padgett - Predeo by city 56.3' N of MH 22739.2 (22195.5) 2V45, 1H22, TWINCO
 2002-03310 127102 1728 N Fairmount - McClung - City W/ Rep 8.2' N of MH 28776 (28784.2) 1V45, 1V22 4" PVC
 Tap C74125-17177 Vassar - 9-6-79 - (28+26.7)
 SO C68016 (3419E174) 3-28-78 - Henning
 SO C65521-3407 E. 17th - 3-17-78 - Henning (30+9.3)
 SO C43630-1725 N. Vassar - 2/25/74 (27+71.2) Seal off # C1718-3425 E. 16th - Jayhawk Services - 1-30-67
 (new M.H.) top # C1719 " " " " (24+22.4)
 C32691-1845 Fairmount (Life Line) - 4/6/72
 Tap #824-4-15-24 1740 Fairmount - 5-24-71
 Tap #1241-12-13-21 Fairmount College
 Tap #1814-1749 N. Yale - 7-8-52 - Kendall P/bg. Co. - (Boys Dormitory)
 Tap #532-1819 N. Vassar - 5-10-29 - George Magruder
 Tap #1575-1702 Fairmount - 11-1-29 - Home Builders P/bg. Co.
 Tap #21 - Wichita Univ. - 1-13-30 - Clark & Smith - Into M.H. 38+18.7
 Tap #416 - Wichita Univ. - 7-31-31 - Simmons P/bg. Co.
 Tap #945 - Wichita Univ. - 6-30-38 - Simmons P/bg. Co.
 Tap #3098-1650 Fairmount - 11-1-52 - Kendall P/bg. Co.
 Tap #2864 - Wichita Univ. Airplane School Bldg. - 11-13-40 - Moore Robertson P/bg. Co. - (Used old conn.)
 Tap #2532-1741 N. Vassar - 12-20-45 - Roy McCoy
 Tap #503-2000 Fairmount - Veterans Stadium - 7-24-47 - Pray Bros (Private line)
 Tap #441-1739 N. Vassar - 7-19-47 - R La Foy
 Tap #2328-2000 Gentry - Police Radio Station - 3-24-49 - W.B. Carter
 Tap #6975-1732 Fairmount - Jack Durham - 11-14-53
 6645 Tap 1621 N Vassar - Debl's Laundry - 4-14-58 - across page
 #1817 - Japim N. 2000 Fairmount - Veterans Stadium - 8-18-60 - (Pray Bros - Private line)
 #1527 - trailer - private line conn. (1740 Fairmount) La Jay P/bg (32471)
 S.O. # C64887 - 1719 N Vassar - 1-24-75 - Henning (28+40)