


LAT. 1- Dist. H- S.S. No. 12  
1922

REMOVAL OF SANITARY SEWER  
TO SERVE AUTO ZONE AT CENTRAL  
AND MINNESOTA  
PROJ. NO. 659 PPS (607861)  
BUILT BY COASTLAND CO., INC.  
BOOKED 4-4-97 AS PER PLAN

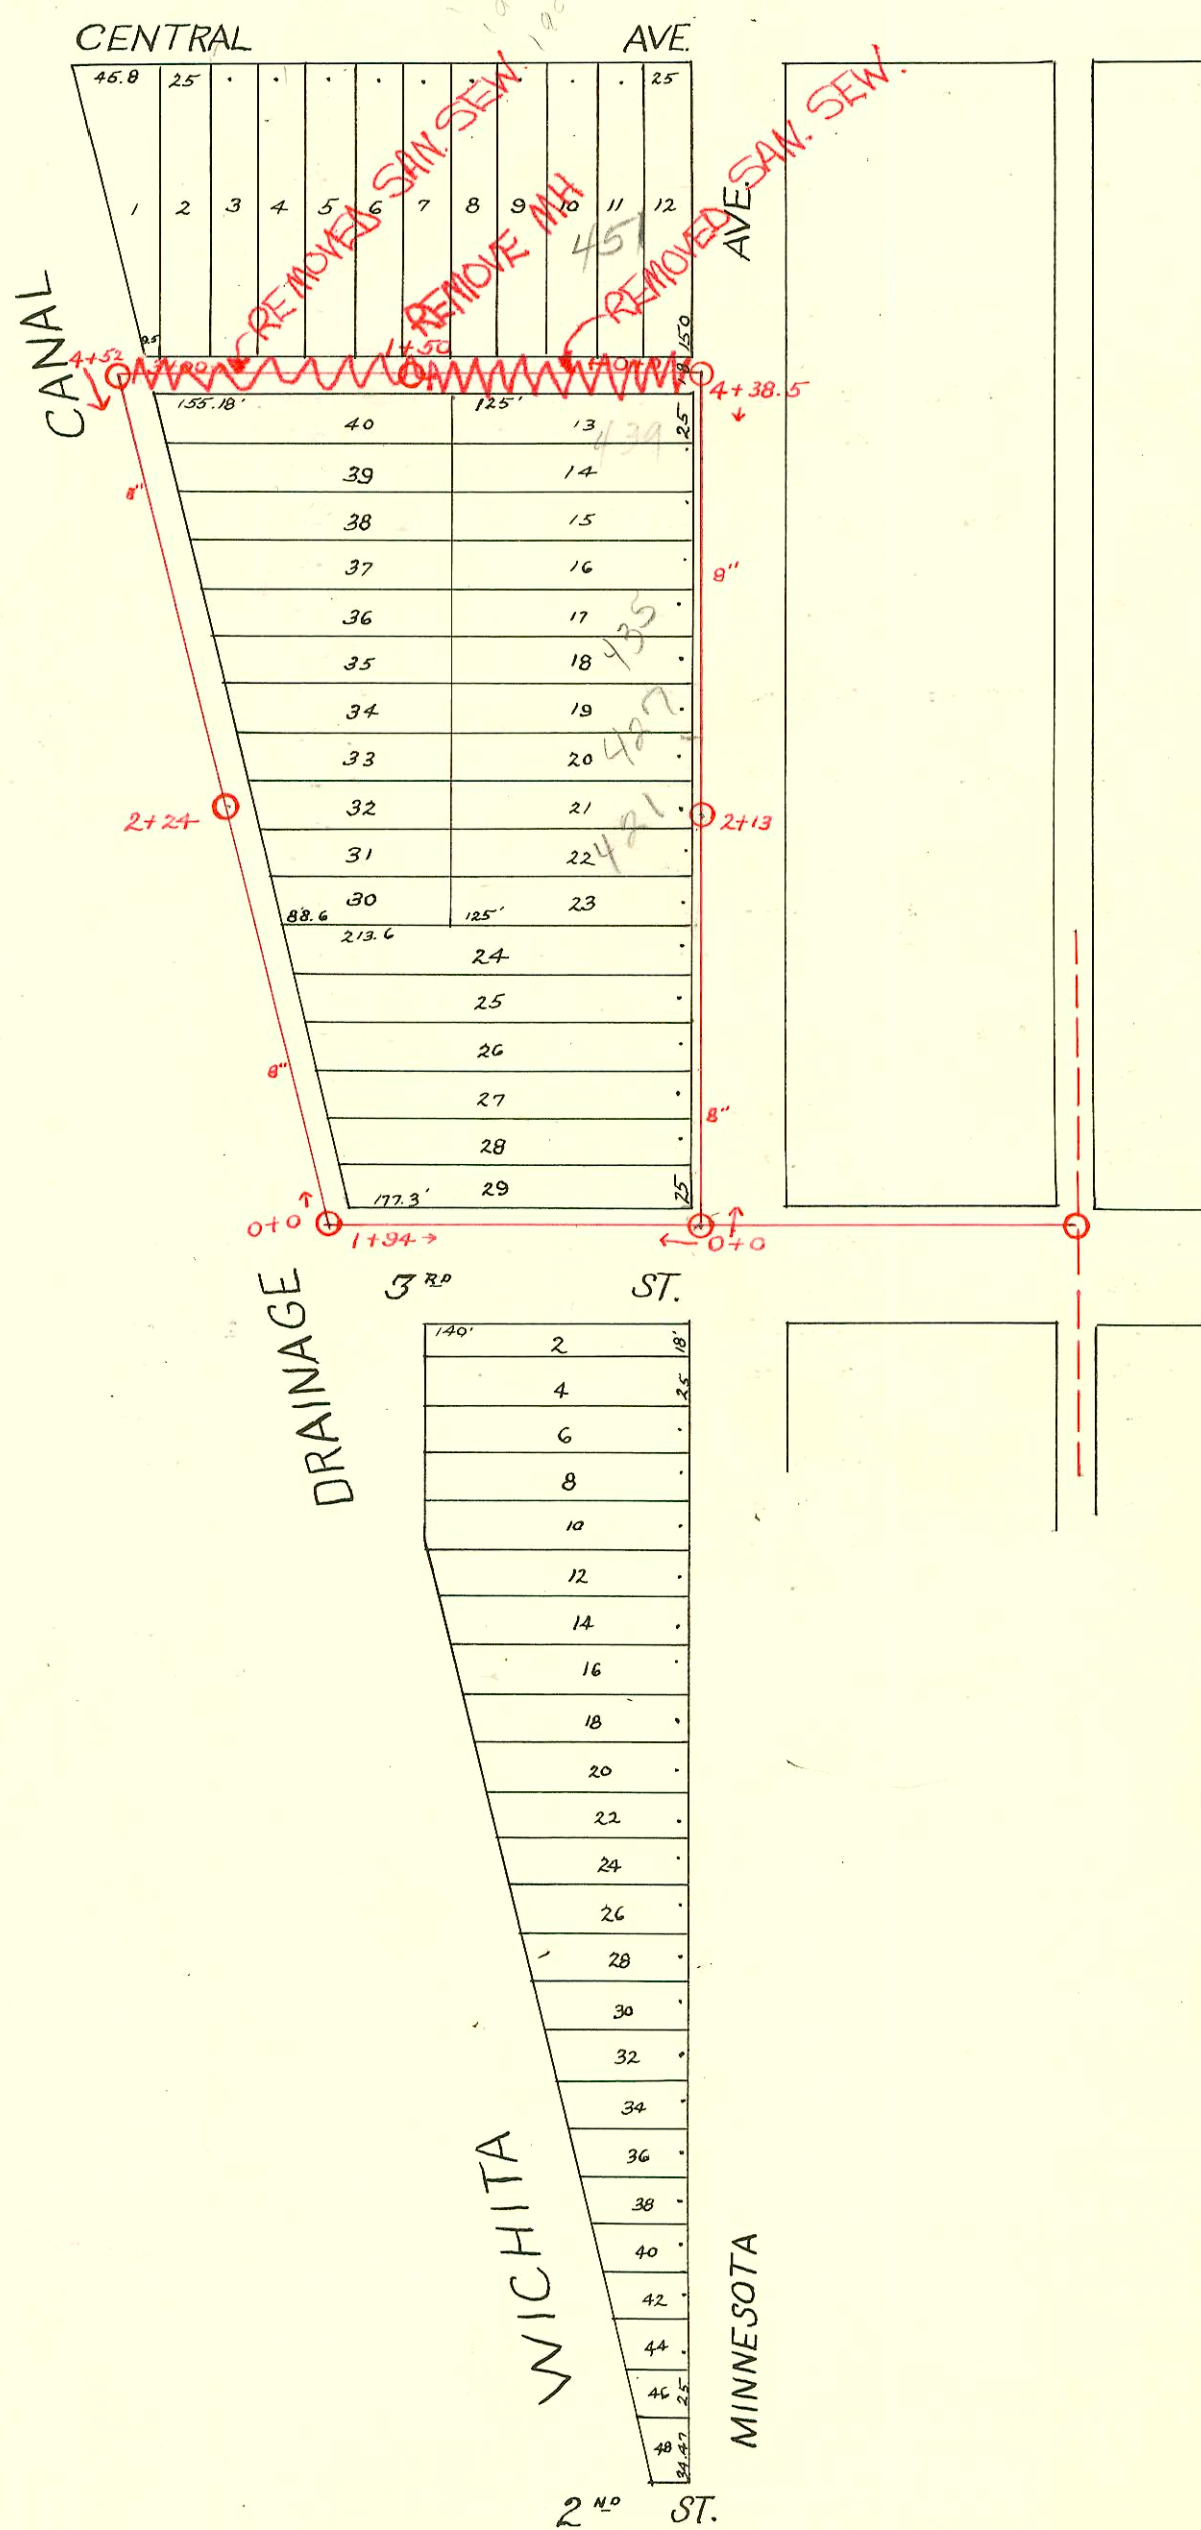

| CONSTRUCTION RECORD                                    |           |        |        |         |                                                |                                    | SERVICE RECORD                |            |                        |            |                      |            |
|--------------------------------------------------------|-----------|--------|--------|---------|------------------------------------------------|------------------------------------|-------------------------------|------------|------------------------|------------|----------------------|------------|
| STATION                                                | ELEVATION |        | Depth  | MANHOLE | 4-INCH "Y" BRANCHES                            |                                    | No. of Permit                 |            | House Number           |            | DATE OF PERMITS      |            |
|                                                        | Ground    | Grade  |        |         | North West                                     | South East                         | North West                    | South East | North West             | South East | North West           | South East |
| West parking Minnesota, North from 3 <sup>rd</sup> St. | 0 + 0     | 110.19 | 106.95 | 3.24    | N.W. Cor. 3 <sup>rd</sup> & Minnesota<br>0 + 0 | 0 + 57                             | #543                          |            | 407 N. Minnesota       |            | 5-20-25              |            |
|                                                        | + 50      | 110.24 | 107.00 | 3.24    |                                                | + 83                               |                               |            | 411 N. Minnesota       |            | 5-31-51              |            |
|                                                        | 1 + 0     | 111.05 | 107.05 | 4.00    |                                                | 1 + 08                             | #4800                         |            | 413 N. R. Minnesota    |            | 8-30-23              |            |
|                                                        |           |        |        |         |                                                | + 34<br>1105.0 115.0 115.0<br>+ 59 | #72297<br>#823                |            |                        |            | 7-24-25              |            |
|                                                        | + 50      | 111.61 | 107.10 | 4.51    |                                                | + 82                               |                               |            |                        |            |                      |            |
|                                                        | 2 + 0     | 111.51 | 107.15 | 4.36    |                                                | 2 + 07                             | #1468                         |            | 421 N. Minnesota       |            | 11-3-22              |            |
|                                                        |           |        |        |         | 2 + 13                                         | + 32<br>2 + 62<br>2 + 53           | #1387477<br>#7520537<br>#1469 |            | 429 St. Minnesota      |            | 12-10-91<br>12-14-95 |            |
|                                                        | + 50      | 111.55 | 107.20 | 4.35    |                                                | + 68                               |                               |            |                        |            | 11-3-22              |            |
|                                                        |           |        |        |         |                                                | + 84                               |                               |            |                        |            |                      |            |
|                                                        | 3 + 0     | 111.61 | 107.25 | 4.36    |                                                | 3 + 08                             | #12613<br>#570                |            | 437 N. Minnesota       |            | 5-5-2-85             |            |
| Alley South of Central                                 |           |        |        |         |                                                | + 34                               |                               |            |                        |            | 5-25-25              |            |
|                                                        | + 50      | 111.58 | 107.30 | 4.28    |                                                | + 59                               |                               |            | 451 N. W. C. Minnesota |            |                      |            |
|                                                        | 4 + 0     | 111.70 | 107.39 | 4.31    | 4 + 38.5                                       | + 85                               | #721047                       |            |                        |            | 2-18-91              |            |
|                                                        | 0 + 0     | 111.61 | 107.39 | 4.22    | 0 + 0                                          | 0 + 15                             | #12613<br>#523                |            | 451 N. Minnesota       |            | 3-30-72              |            |
|                                                        |           |        |        |         |                                                | + 39.5<br>0 + 34.5<br>0 + 63       | #20912<br>#621                |            | 439 N. Minnesota       |            | 4-12-23              |            |
|                                                        | + 50      | 111.72 | 107.44 | 4.28    |                                                | + 88                               | #747                          |            | 1845 E. Central        |            | 6-8-25               |            |
|                                                        | 1 + 0     | 110.95 | 107.49 | 3.46    |                                                | 1 + 15                             |                               |            |                        |            | 7-7-25               |            |
|                                                        |           |        |        |         | 1 + 50                                         | + 40                               | #720                          |            | 1921 E. Central        |            | 7-16-30              |            |
|                                                        | + 50      | 110.36 | 107.45 | 2.82    |                                                | + 66                               | #147                          |            | 1821 E. Central        |            | 8-26-70              |            |
|                                                        |           |        |        |         |                                                | + 92                               |                               |            |                        |            | 9-29-32              |            |
| In No. Parking of 3 <sup>rd</sup> W. of Minnesota      | 2 + 0     | 109.59 | 107.59 | 2.00    |                                                | 2 + 17                             |                               |            |                        |            |                      |            |
|                                                        | + 50      | 109.18 | 107.64 | 1.54    |                                                | + 44                               |                               |            |                        |            |                      |            |
|                                                        | 3 + 0     | 110.67 | 107.69 | 2.98    | 3 + 00                                         | + 69                               |                               |            |                        |            |                      |            |
|                                                        | 0 + 0     | 110.19 | 106.95 | 3.24    | N.W. Cor. 3 <sup>rd</sup> & Minnesota<br>0 + 0 | 0 + 59                             | #73544<br>#594                |            | 401 S. Minnesota       |            | 8-10-79              |            |
|                                                        | + 50      |        | 107.00 |         |                                                | 1 + 27                             |                               |            |                        |            | 4-23-23              |            |
|                                                        | 1 + 0     |        | 107.05 |         | 1 + 94                                         |                                    |                               |            |                        |            |                      |            |
|                                                        | + 50      |        | 107.10 |         |                                                |                                    |                               |            |                        |            |                      |            |
|                                                        | 0 + 0     |        | 107.15 |         | 0 + 0                                          |                                    |                               |            |                        |            |                      |            |
|                                                        | + 50      |        | 107.20 |         |                                                |                                    |                               |            |                        |            |                      |            |
|                                                        | 1 + 0     |        | 107.25 |         |                                                |                                    |                               |            |                        |            |                      |            |
| On Canal Blvd. North from 3 <sup>rd</sup> St.          | + 50      |        | 107.30 |         | 2 + 24                                         |                                    |                               |            |                        |            |                      |            |
|                                                        | 2 + 0     |        | 107.35 |         |                                                |                                    |                               |            |                        |            |                      |            |
|                                                        | + 50      |        | 107.40 |         |                                                |                                    |                               |            |                        |            |                      |            |
|                                                        | 3 + 0     |        | 107.45 |         |                                                |                                    |                               |            |                        |            |                      |            |
|                                                        | + 50      |        | 107.50 |         |                                                |                                    |                               |            |                        |            |                      |            |
|                                                        | 4 + 0     |        | 107.55 |         |                                                |                                    |                               |            |                        |            |                      |            |
|                                                        | + 52      | 110.67 | 107.61 | 3.06    | 4 + 52                                         |                                    |                               |            |                        |            |                      |            |
|                                                        |           |        |        |         |                                                |                                    |                               |            |                        |            |                      |            |
#639 - Tap 435 N. Minnesota - 6-15-28 (112.5.08 MH)  
#2085 - Tap 421 N. Minnesota - 3-3-49 - Joe McDonald  
See off C18526-1819 2. Central - Al Henning - 3-26-70 (1 + 64)  
# 20703 - S1/4 188 433 N. Minnesota - Rob Smith