


LAT. 15- Dist. A- S.S. No. 12
1922

SEE SHEET 234
FOR RECON. ST.


10+20.5 MH TO 'A' END INSITUFORM LINER SOUTH
BEGIN 8" V.C.P. NORTH

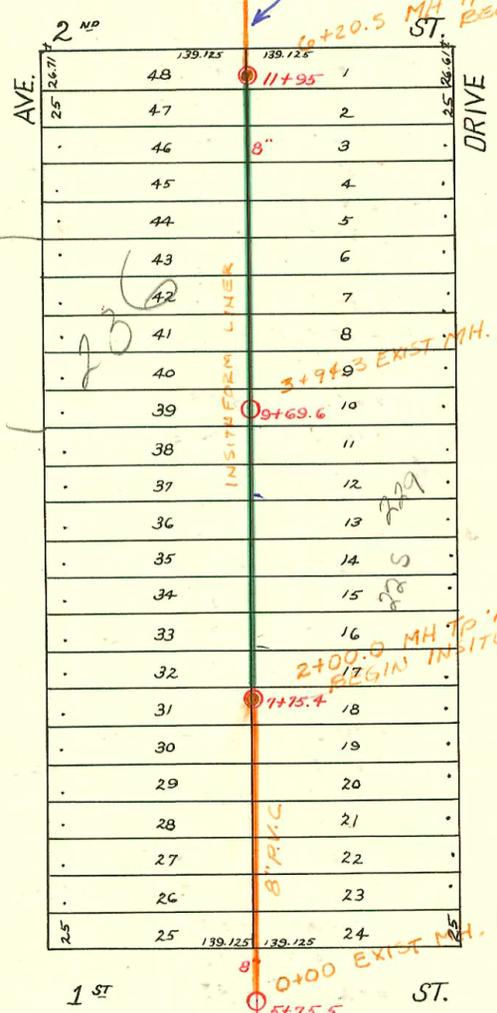


RECON. A PORTION OF LAT 15,
DIST. A, S.S.#12, BETW. CRESTWAY
& TERRACE FROM 1ST ST. TO 2ND ST.
BUILT BY: WILDCAT CONST.
BOOKED 3-12-84 FROM BR-64

2+00.0 MH TO 'A' END NEW 8" PVC SOUTH
BEGIN INSITUFORM LINER NORTH

0+00 EXIST MH. BEGIN NEW 8" P.V.C. NORTH

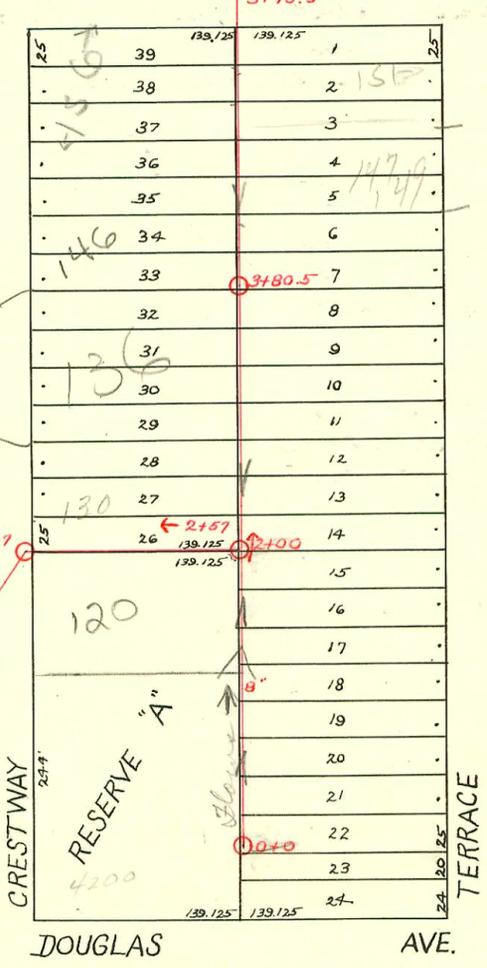

Note: N&S line flows from
0+00 to 2+00
11+95 to 2+00

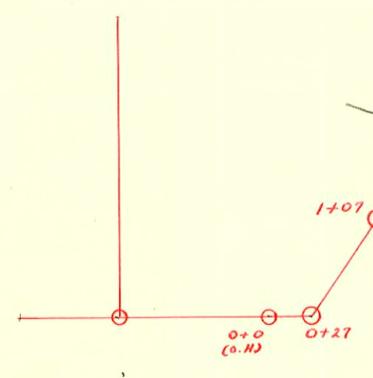

CRESTWAY DOUGLAS AVE. TERRACE

CONSTRUCTION RECORD

SERVICE RECORD

STATION	ELEVATION		Depth	MANHOLE	4-INCH "Y" BRANCHES		No. of Permit		House Number		DATE OF PERMITS	
	Ground	Grade			North West	South East	North West	South East	North West	South East	North West	South East
0+0	185.45	177.62	7.83	0+0		0+15 +30 +56 +81 1+05 +29 +57.4						
								#864 #584	115 N Terrace Dr			12-18-23 6-8-26
2+0	184.86	177.42	7.44	2+0	2+12	2+09.5 +37 +62.5 +87.5		#382 B5982 #92	130 N Crestway 154 N Crestway	123 N Terrace Dr		4-16-28 7-11-66 2-9-26
3+0	184.99	177.52	7.47		3+13.5	3+11 +38.5 +63 +89.5		#1 #619 #305 #237	131 N Terrace Dr 121 N Terrace Dr 139 N Terrace Dr			1-2-29 7-21-26 3-30-25 2-19-24
					3+80.5	+63 +87		#195	146 N Crestway 120 N Crestway	see below N/C Rep		11-28-00 3-22-27
4+0	185.29	177.62	7.67		4+15.5	4+13 +40.5 +65.5 +91.1		#82	149-147 N Terrace			2-8-27 8-19-59
					5+17	5+14.5 +42.5 +77.5		#1303 #2171	151 N Terrace			8-26-99 9-7-54
5+0	184.86	177.72	7.14		5+75.5							
6+0	185.38	177.82	7.56		6+09.5	6+07 +34.5 +59.5 +84.5		#915 #1084 #721	203 N Terrace Dr 200 N Crestway 207 N Terrace Dr			7-23-29 9-15-38 7-1-25
7+0	185.04	177.92	7.12		7+10.5	7+08 +35.9 +61.1 +86.5		#1373 #1006	212 N Crestway 217 N Terrace			3-9-39 7-22-32
8+0	184.62	178.02	6.60		8+11.5	8+09 +37 +63.2 +87.5		#470 #117 #426	224 N Crestway 223 N Terrace			5-5-25 2-25-30 5-21-26
9+0	185.48	178.12	7.36		9+12.5	9+10 +37.5 +64.5 +89.5		#1840 #334 #899	229 N Terrace 233 N Terrace			11-12-97 4-4-28 7-19-29
10+0	186.34	178.22	8.12		10+14.5	10+12 +39.5 +65.5 +91.2		#2677 #1592 #222	236 N Crestway 236 N Crestway 254 N Crestway	235 N Terrace		12-8-24 5-22-29 4-27-31
11+0	185.98	178.32	7.66		11+16.5	11+14 +40.5 +67.1		#879	252 N Crestway			7-17-29
11+95	186.74	178.42	8.32	11+95		+85.2 +82.7						
0+0	186.31	177.16	9.15	0+0 (O.H.)								
0+27	184.65	177.19	7.46	0+27 (In W. Parking)								
1+07	184.93	177.27	7.66	1+07 (In E. Parking)								
2+0	184.88	177.36	7.52	2+57 (N.E. Cor. Res. "A")								
2+57	185.45	177.42	8.03									
RECONST. PORTION LAT 15, DIST. A, S. S. #12												
0+00	184.77	178.35		EXIST.								
1+00	187.3	178.50										
2+00	187.65	178.58 OUT 178.65 IN		2+00.0								
3+00	187.4			3+94.3 EXIST.								
4+00	188.5											
5+00	189.0											
6+00	189.5	179.09 OUT 179.15 IN		6+20.4								
7+00	188.0			END NEW PIPE								
7+50	192.0											
Repair for	146 N CRESTWAY	37 WIN CO, 1122, 2KICKOUTS, 3V45										
	2000-02567-4/23/00	Wichita Ex- 4" SCH 40 (Preco)										

RECONST. PORTION LAT 15, DIST. A, S. S. #12

Repair for

146 N CRESTWAY 37 WIN CO, 1122, 2KICKOUTS, 3V45
 2000-02567-4/23/00 - Wichita Ex- 4" SCH 40 (Preco) 11' N of MH 3+80.5 (3+91.5) Repl 13' Low end 1 ran line to garage.
 158499-121 N Terrace - 11-29-83 2+11.3
 #1930-Top - 104 N Crestway - 12-29-23 (Lot about 100' No. of 0+0)
 2002-025 2343913-Top - 120 N Crestway - 1-29-53 J. Douglas Lansdowne tied to exist wye 35' S of MH at 2nd (1465) 1122, 2122, 1 TWIN CO, 1 Fernco
 2003-00833 #191-Top - 136 N Crestway - 3-18-29 Clark & Smith 3/31/03 ASAP P/bg - 26' from edge of drive - 2-4" wyes, 2V45, 1V22, 1 TWIN CO
 #548-Top - 117 N Terrace Dr - 5-14-29 Dermody P/bg. Co.
 #1061-Top - 130 N Crestway - 8-14-29 Johnson P/bg. Co.
 #474-Top - 149 N Terrace - 5-8-30 Home Builders P/bg. Co.
 #173-Top - 257 N Terrace - 4-9-31 Long P/bg. Co.
 #2477-Top - 102 N Crestway - 9-25-50 Tutton P/bg. Co.