


DIST. 1 - S. S. No. 12
1923

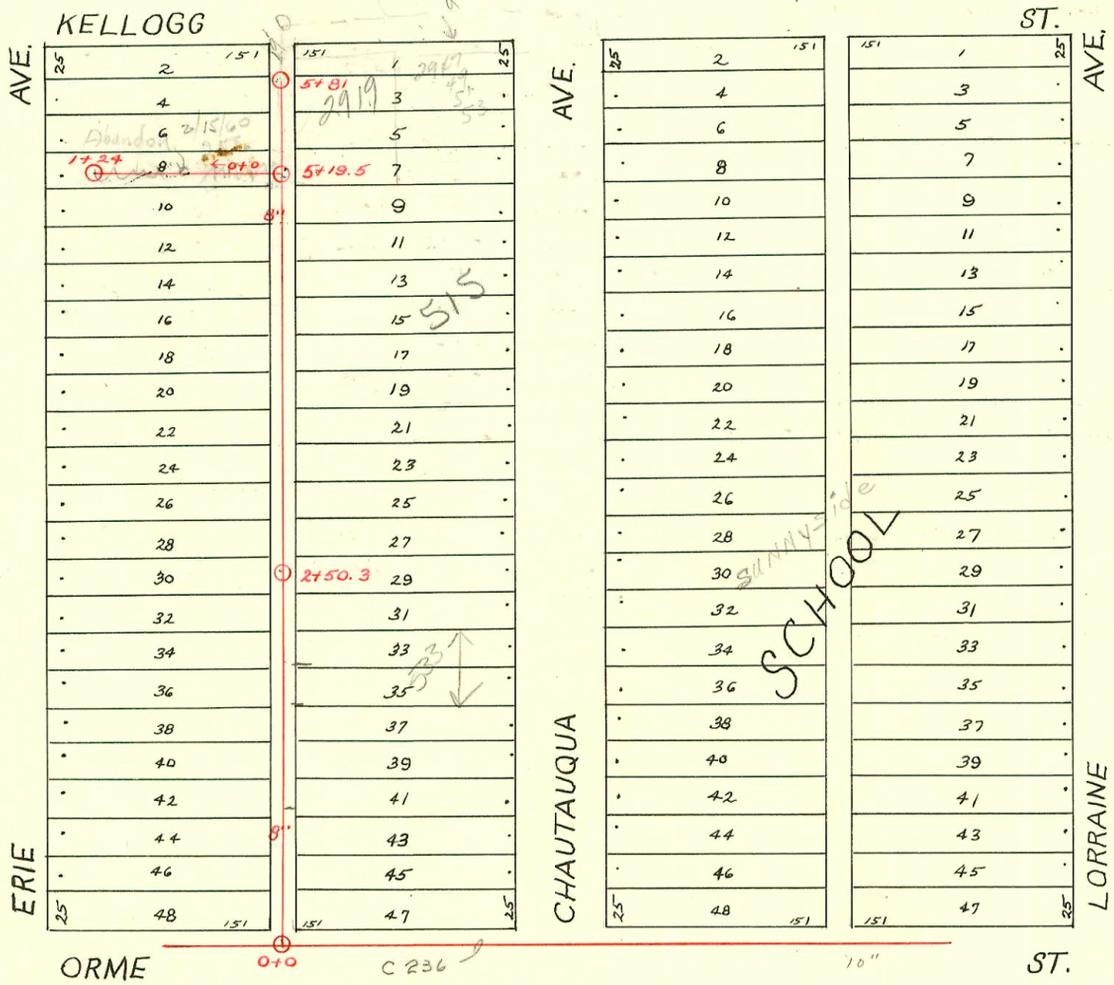

10-29-80
C-238
let it show on Book
That 8" line west out of
Station 5+19.5 M/H is
Sealed off in M/H.
Abandoned line Sealed by Drain Layer.
O.K. by Brewster Clark

SWR2000-00487-2919 E Kellogg - Repair - use @ 3' N 1/2 M/H (1) 220 (1) 450 (1) Fernco
4" polyethylene - Roto Footer - 2 R3100

CONSTRUCTION RECORD

SERVICE RECORD

Line in Alley bet. Chautauqua & Erie

Line from Erie to Alley East. 92' S. of Kellogg.

STATION	ELEVATION		Depth	MANHOLE	4-INCH "Y" BRANCHES		No. of Permit		House Number		DATE OF PERMITS	
	Ground	Grade			North West	South East	North West	South East	North West	South East	North West	South East
0 + 0	109.65	101.70	7.95	0 + 0	0 + 18.1 + 43.8 + 68.6 + 94.5	0 + 15.6 + 41.3 + 66.1 + 92		#620	557 S. Chautauqua			7-22-26
1 + 0	109.52	102.00	7.52		1 + 19 + 43.8 + 70.2 + 93.8	1 + 16.5 + 41.3 + 67.7 + 91.3	#25 #270	#2375 #962	548 S. Erie 548 S. Erie 537 S. Chautauqua	553 S. Chautauqua	3-24-36 3-25-25	10-21-24 10-21-30
2 + 0	109.52	102.30	7.24	2 + 50.3	2 + 19.8 + 44.8 + 69.8 + 95.8	2 + 17.3 + 42.3 + 67.3 + 93.3	#349 #234	#2683	532 S. Erie 530 S. Erie	525 S. Chautauqua	4-7-25 3-19-25	12-10-24 10-11-23
3 + 0	109.85	102.60	7.25		3 + 20.8 + 45.8 + 70.8 + 95.8	3 + 18.3 + 43.3 + 68.3 + 93.3	#231	#1408	528 S. Erie	521 S. Chautauqua	3-18-25	10-3-29
4 + 0	109.48	102.90	6.58		4 + 21.3 + 46.8 + 71.8 + 96.8	4 + 18.8 + 44.3 + 69.3 + 94.3	#660	#1613	526 S. Erie 576-20 S. Erie	515 S. R. Chautauqua	3-12-25 9-13-46	11-2-23
5 + 0	109.35	103.20	6.15	5 + 19.58	5 + 22	5 + 22	#1579 #664	#158	2003-01020 520 S. Erie 522 S. Erie	515 S. R. Chautauqua	see below 10-26-23 8-8-27	4-17-25 3-5-25
+ 81	108.65	103.44	5.21	5 + 81			#1216 #11649	#577	2919 E. Kellogg	2919 E. Kellogg	4-28-60	10-20-59 6-19-26
0 + 0	109.59	103.57	6.08	0 + 0	0 + 29 + 80		#1168 #1769		2909 E. Kellogg 2905 E. Kellogg		2-2-60 8-6-23	8-6-23
1 + 0	110.11	103.81	6.30		1 + 17.3		#1170		2901 E. Kellogg		8-6-23	8-6-23
+ 24	110.26	103.88	6.38	1 + 24								

2003-01020 - 4/17/03 - 515 S Chautauqua - A.E. Henning - 4" PVC Replaced 10' section 45' from main - No alley

3946 - 2947 E Kellogg - Bob Scott 7-22-81 (518.0 S 29.0) (5752.0)

R. 263484 - 536 S. Erie - 10-12-77 Jerry Boardman

#119 - 513 S. Chautauqua - 7-27-23 - 25' So. of 5781

#272A - Tap - 2920 E. Orme - 10-2-40 - Ray Bryant

#13127 Tap 2947-49-51-53 E. Kellogg Richard La Souza 7-28-60
(Line on N. side of sidewalk in parking area 19 ft. N. of MN 5781 + east 96' to wye)