


LAT. 22 - DIST. - S.S. No. 12
1924

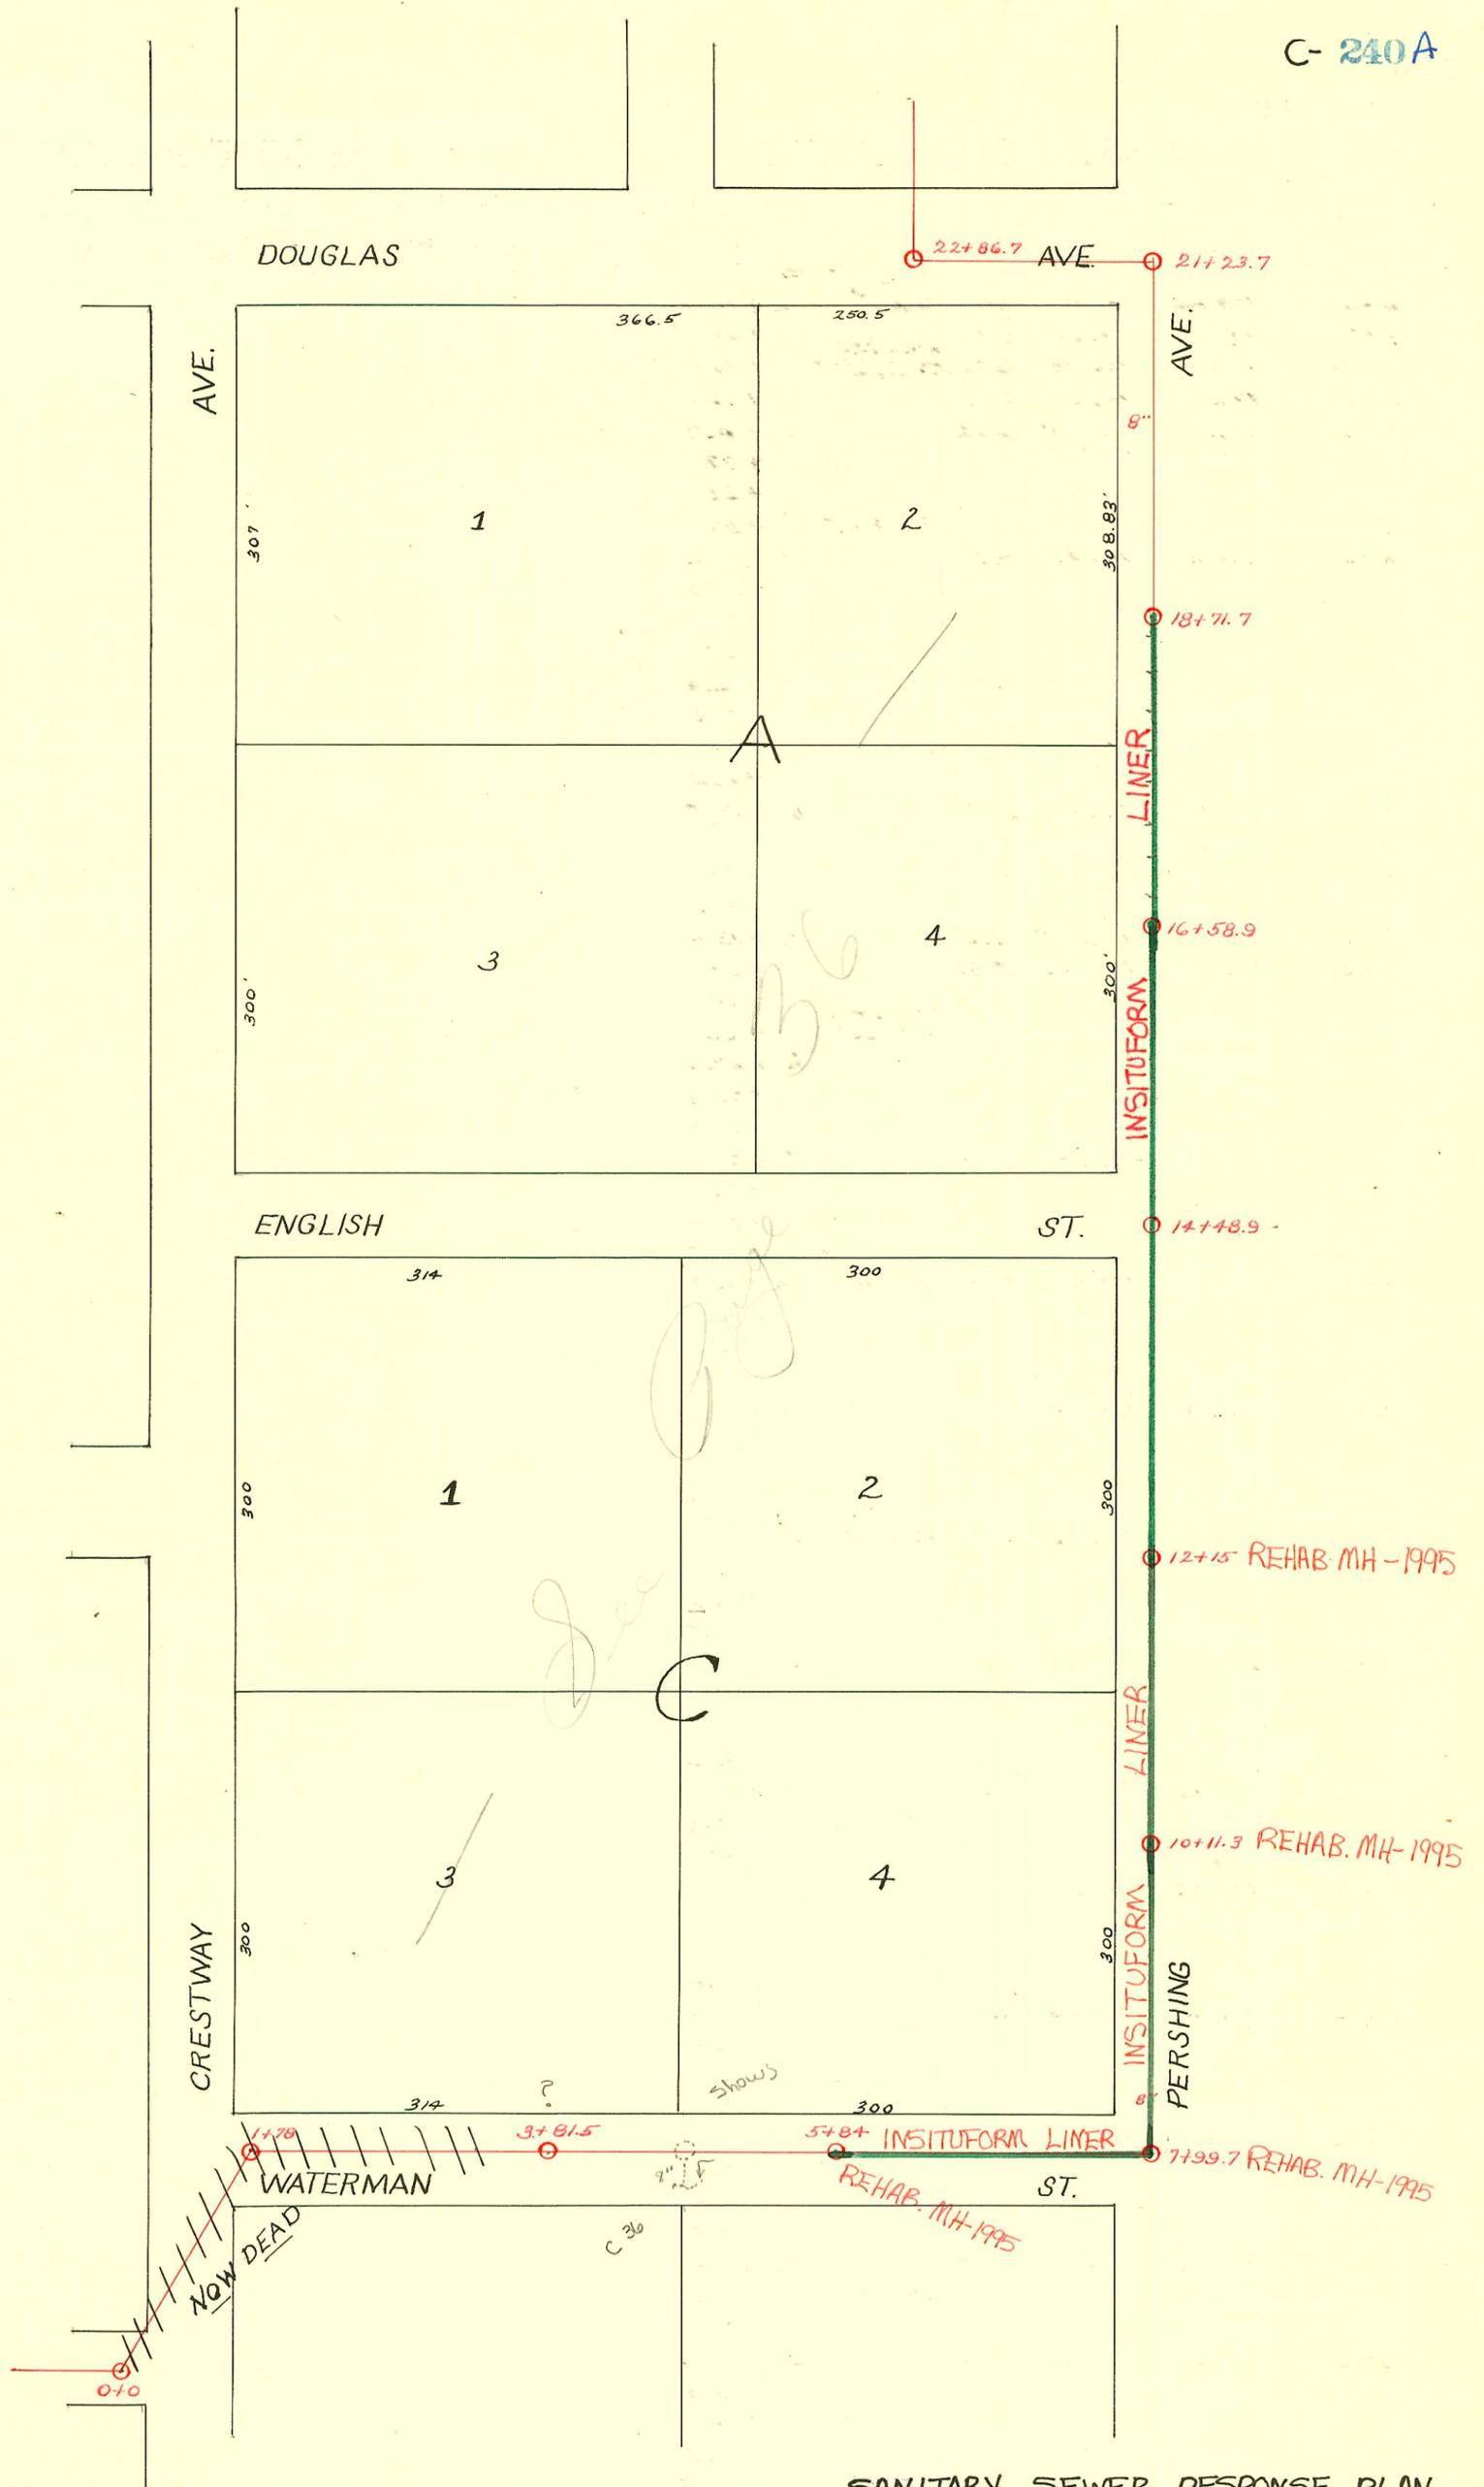

SANITARY SEWER RESPONSE PLAN
 PHASE -IA
 PROJ. NO. 468-82420 (623124)
 BUILT BY INSITUFORM PLAINS, INC.
 BOOKED 7-27-96 FROM AS BUILTS

SEWER RESPONSE PLAN - PHASE IB
 PROJ. NO. 468-82542 (621193)
 BUILT BY INSITUFORM PLAINS, INC.
 BOOKED 7-24-97 FROM AS BUILTS

CONSTRUCTION RECORD						SERVICE RECORD						
STATION	ELEVATION		Depth	MANHOLE	4-INCH "Y" BRANCHES		No. of Permit		House Number		DATE OF PERMITS	
	Ground	Grade			North West	South East	North West	South East	North West	South East	North West	South East
0+0	172.94	166.50	6.44	W. of W.L. of Crestway & of Waterman 0+0	2+11							
1+0	173.16	166.65	6.51	18'E. of E.P.L. of Crestway. 5'N. of Waterman	+36.4							
+78	173.27	166.77	6.50		+61.5							
2+0	173.47	166.80	6.67		+86.6							
3+0	173.97	166.95	7.02		3+11.7							
					+37							
					+62.2							
					3+81.5							
4+0	174.81	167.10	7.71		+87.3							
					4+12.2							
					+37.2							
					+62							
					+87.6							
5+0	175.22	167.25	7.97		5+12.4							
					+37.6							
					5+84							
					+63							
					+88.5							
6+0	174.28	167.40	6.88		6+13.5							
					+39							
					+63.4							
					+88.7							
7+0	173.72	167.65	6.07		7+13.4							
+99.7	173.47	167.79	5.68		+39							
					+64							
				5'N. of Q. Waterman 7+99.7	+89							
					8+27.7							
					+52.7							
					+77.7							
9+0	173.97	167.94	6.03		9+03.2							
					+27.7							
					+53.2							
					+77.7							
10+0	175.0	168.09	6.91	10+11.3	10+03.2							
					+27.7							
					+53.1							
					+78.2							
11+0	175.04	168.24	6.80		11+03							
					+28.3							
					+53.9							
					+78.7							
12+0	175.31	168.39	6.92	12+15	12+04							
					+29.1							
					+54.2							
					+79.5							
13+0	175.44	168.54	6.90		13+03.8							
					+30							
					+54.7							
					+79.9							
14+0	176.24	168.69	7.55		14+04.7							
					+29.7							
				14+48.9	+77.7							
15+0	176.30	168.84	7.46		15+02.9							
					+28.1							
					+53.1							
					+78.4							
16+0	176.65	168.99	7.66		16+03.7							
					+28.4							
					16+58.9							
					+53.2							
					+78.4							
17+0	177.83	169.13	8.70		17+03.1							
					+28.4							
					+53.9							
					+78.4							
18+0	177.73	169.28	8.45		18+03.4							
					+52.9							
				18+71.7	+78.7							
19+0	179.12	169.43	9.69		19+03.2							
					+28.3							
					+54							
					+78.5							
20+0	181.06	169.58	11.48		20+03.7							
21+0	180.93	169.74	11.19		+28.5							
+23.7	179.39	169.77	9.62		+53.9							
				21+23.7	+78.7							

Tap - 441 S. Terrace Dr.